



0374-072

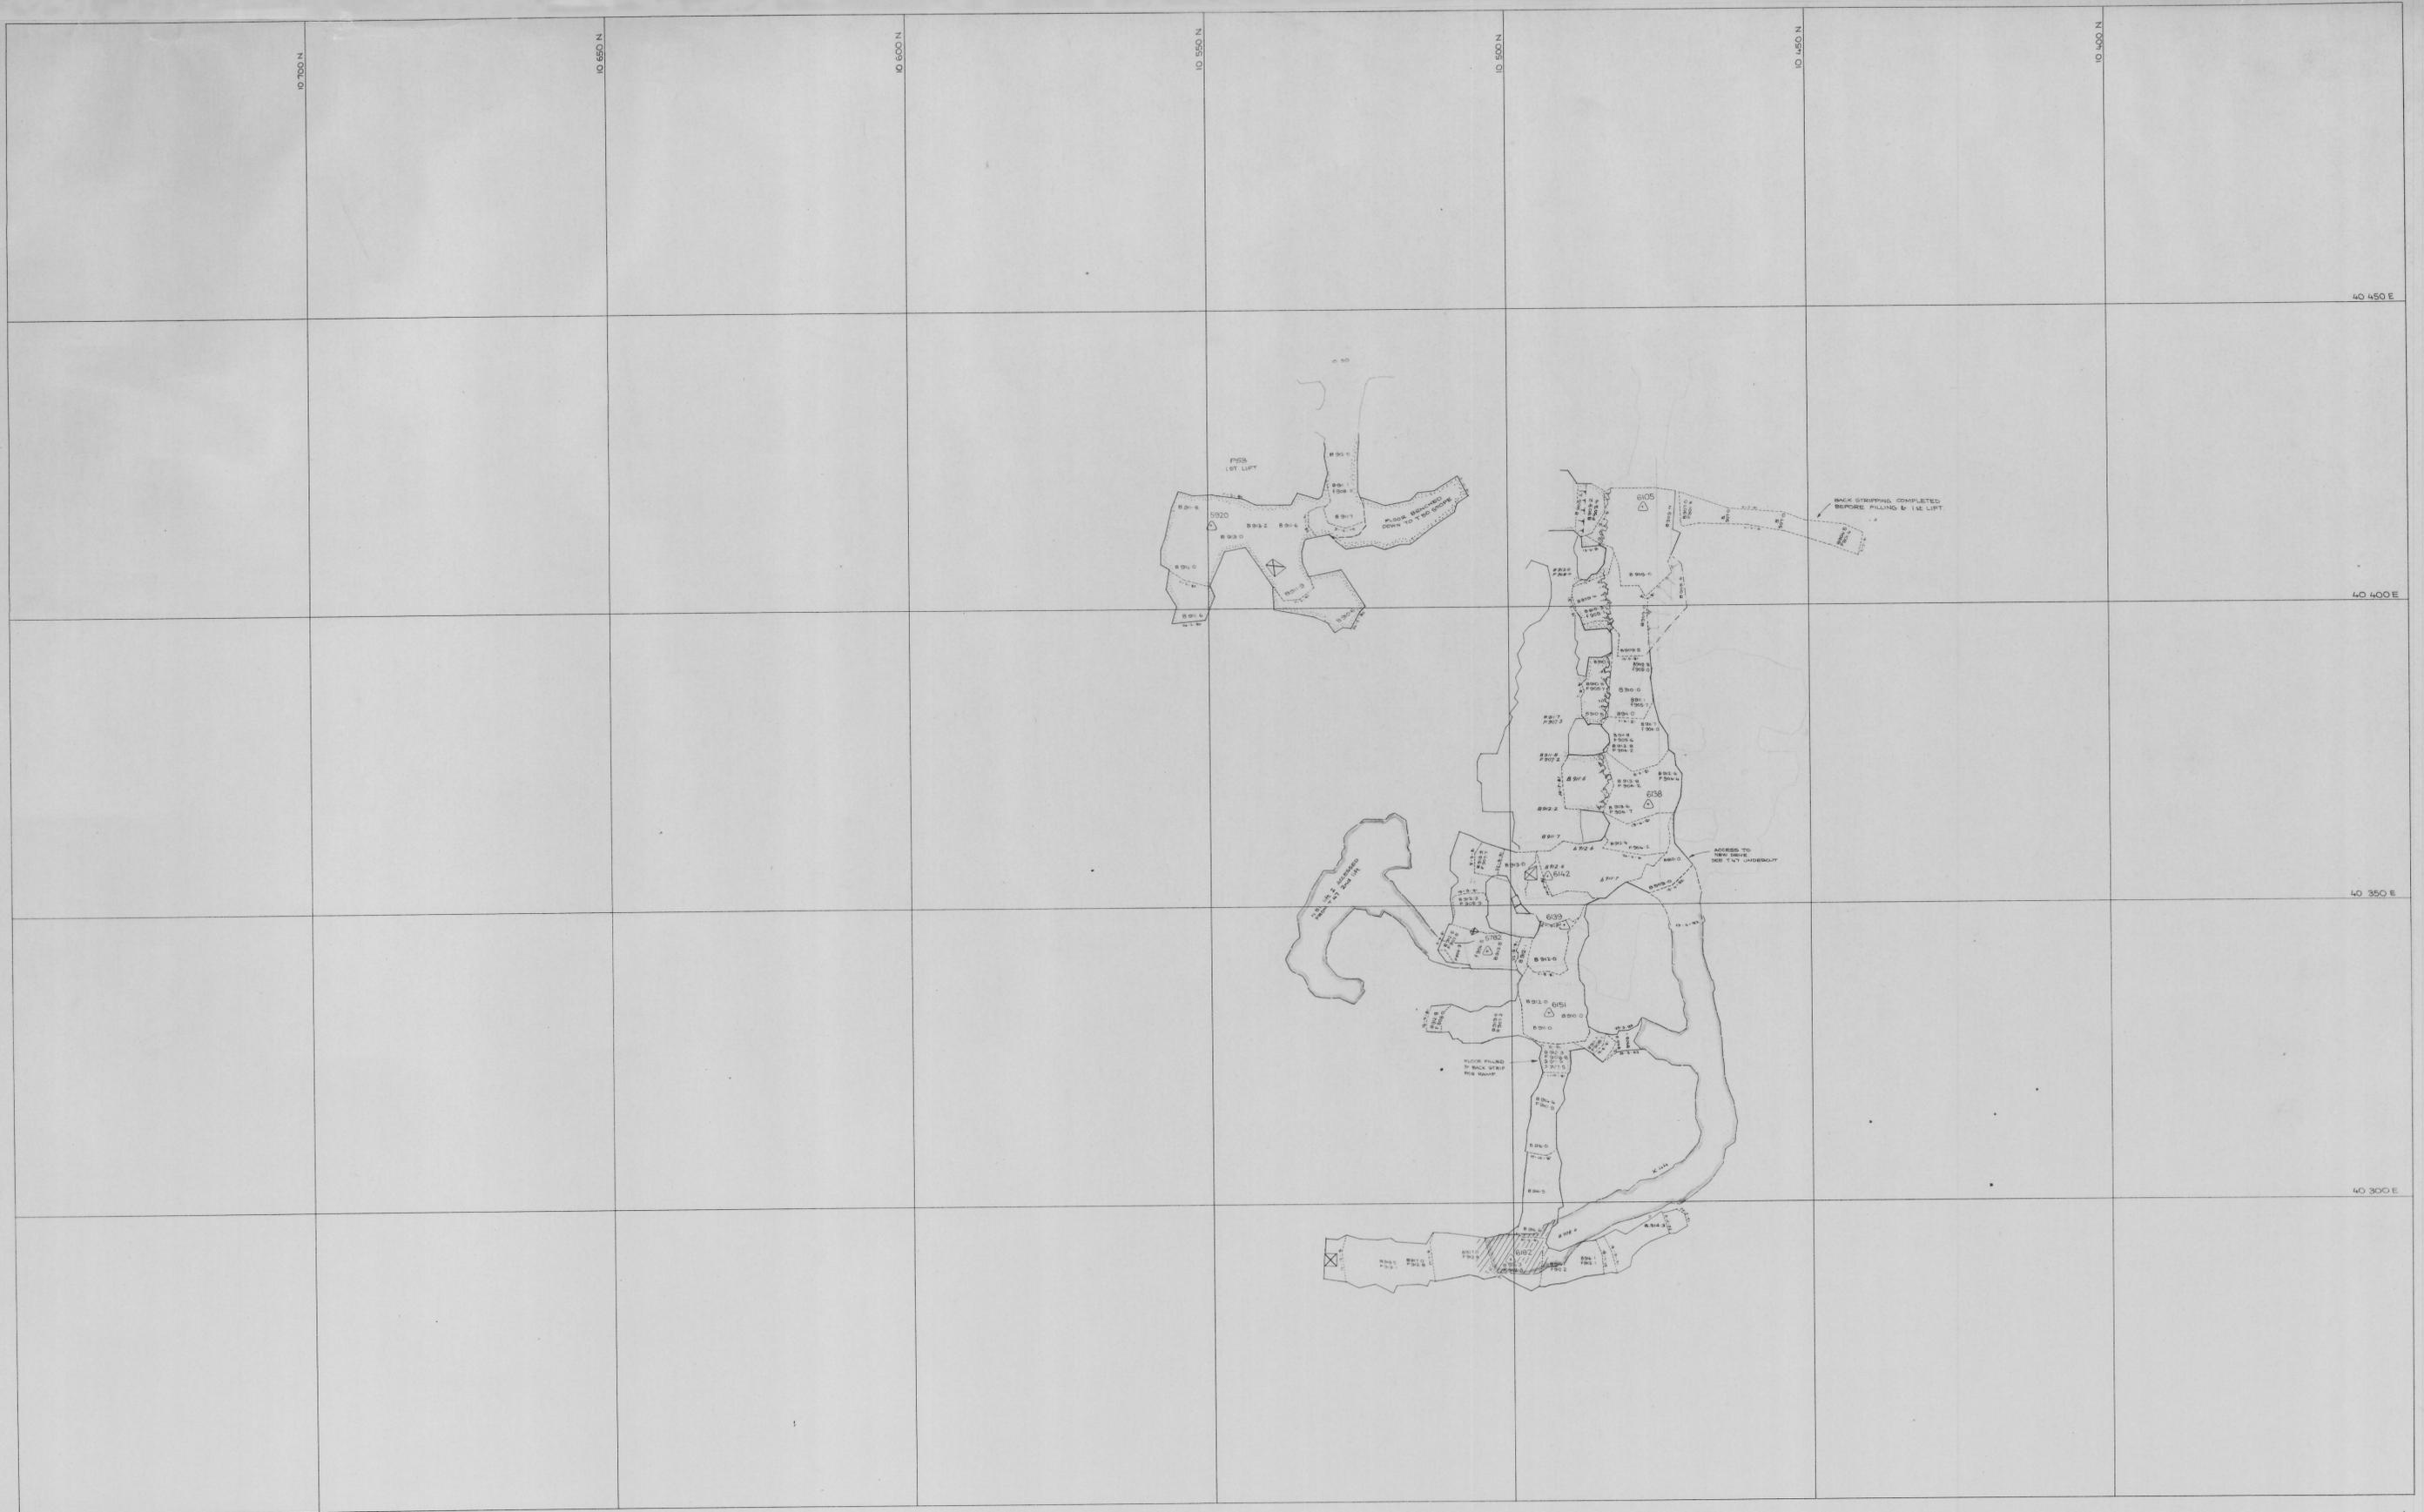

SCALE 1:500

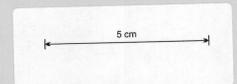

north

LOCATION BOLD HEAD MINE

SUBJECT
 P53 STOPE
 C1 LENS - T47 STOPE
 1st lift

KIS KING ISLAND SCHEELITE
 A DIVISION OF WARMAN INTERNATIONAL
 GRASSY KING ISLAND

PLAN NUMBER
 04BH15 - 109 - 99

83362