
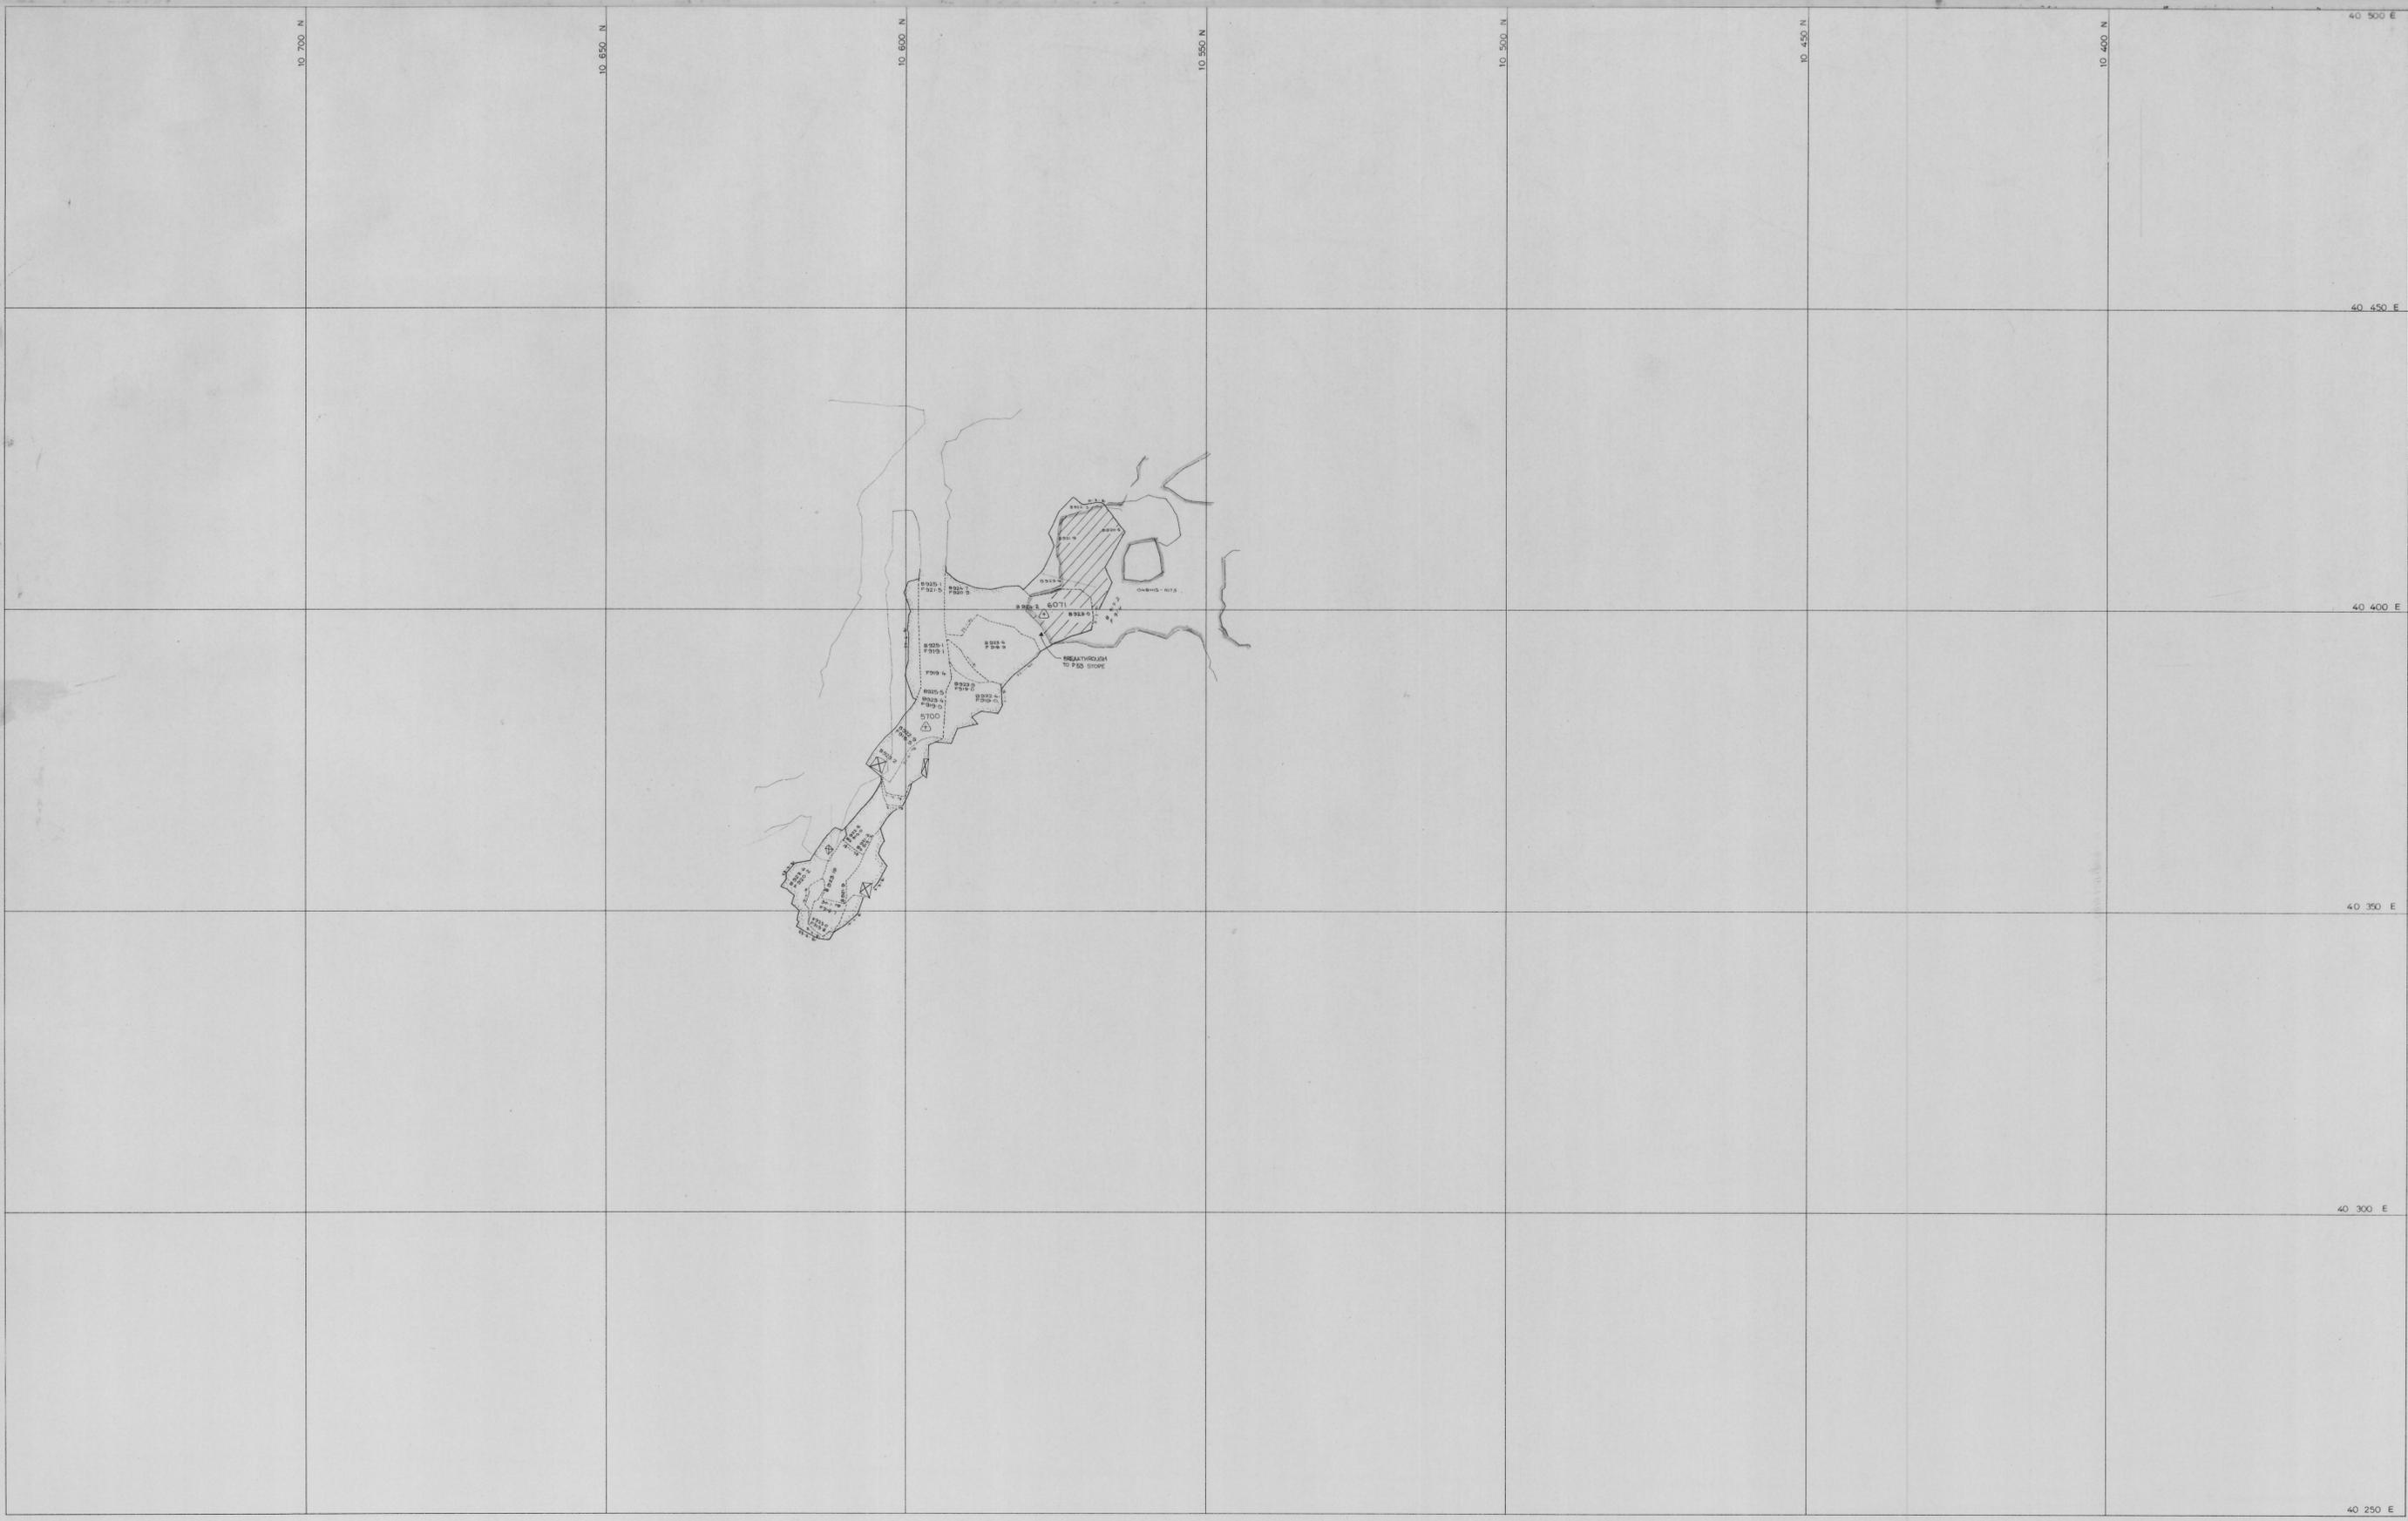


0374-075

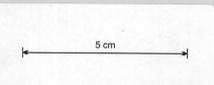

SCALE 1:500 	north	LOCATION BOLD HEAD MINE	 KING ISLAND SCHEELITE <small>A DIVISION OF WARMAN INTERNATIONAL</small> GRASSY KING ISLAND PLAN NUMBER 04BH15 - 107 - 00
	SUBJECT C <sub>2</sub> LENS OREBODY R59 BENCHING	83359	