
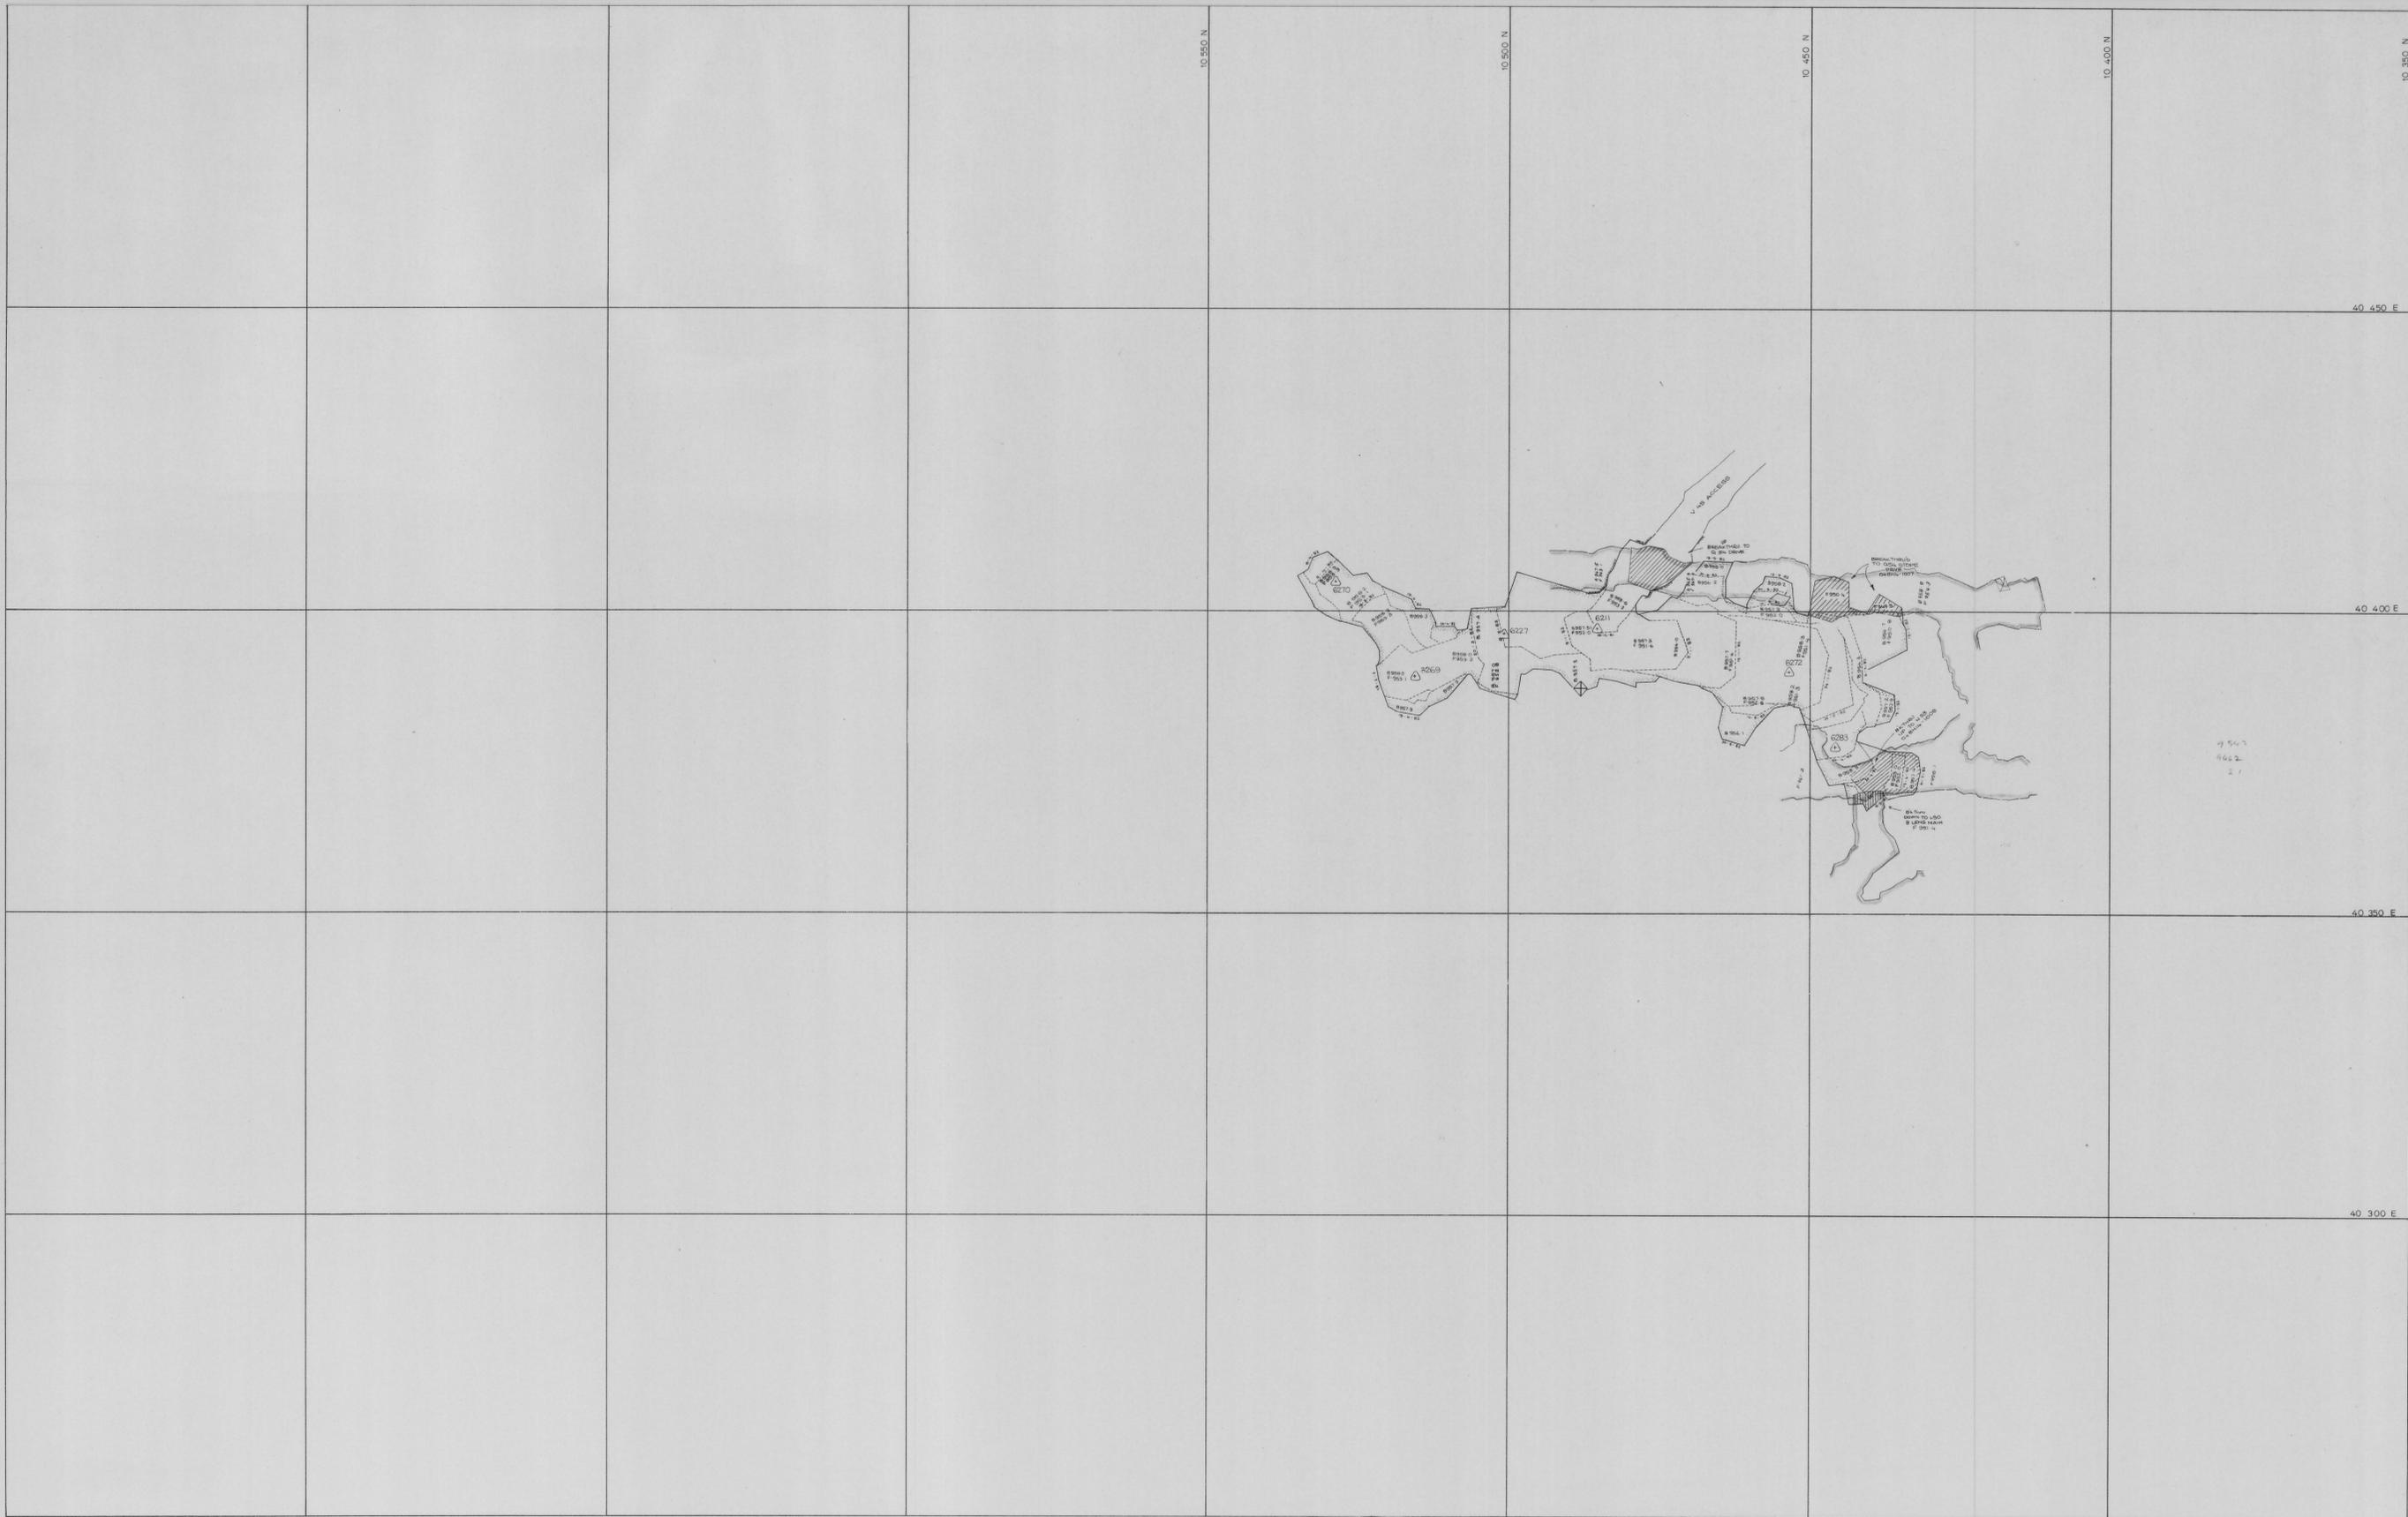


0374-078

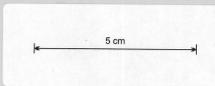

	<p>SCALE 1: 500</p> 	 <p>north</p>	<p>LOCATION BOLD HEAD MINE</p> <p>SUBJECT 046 STOPE 9th lift</p>	 <p>KING ISLAND SCHEELITE A DIVISION OF WARMAN INTERNATIONAL</p> <p>GRASSY KING ISLAND</p> <p>PLAN NUMBER 04BH15 - 106 - 91</p>
--	---	--	--	--

83356