
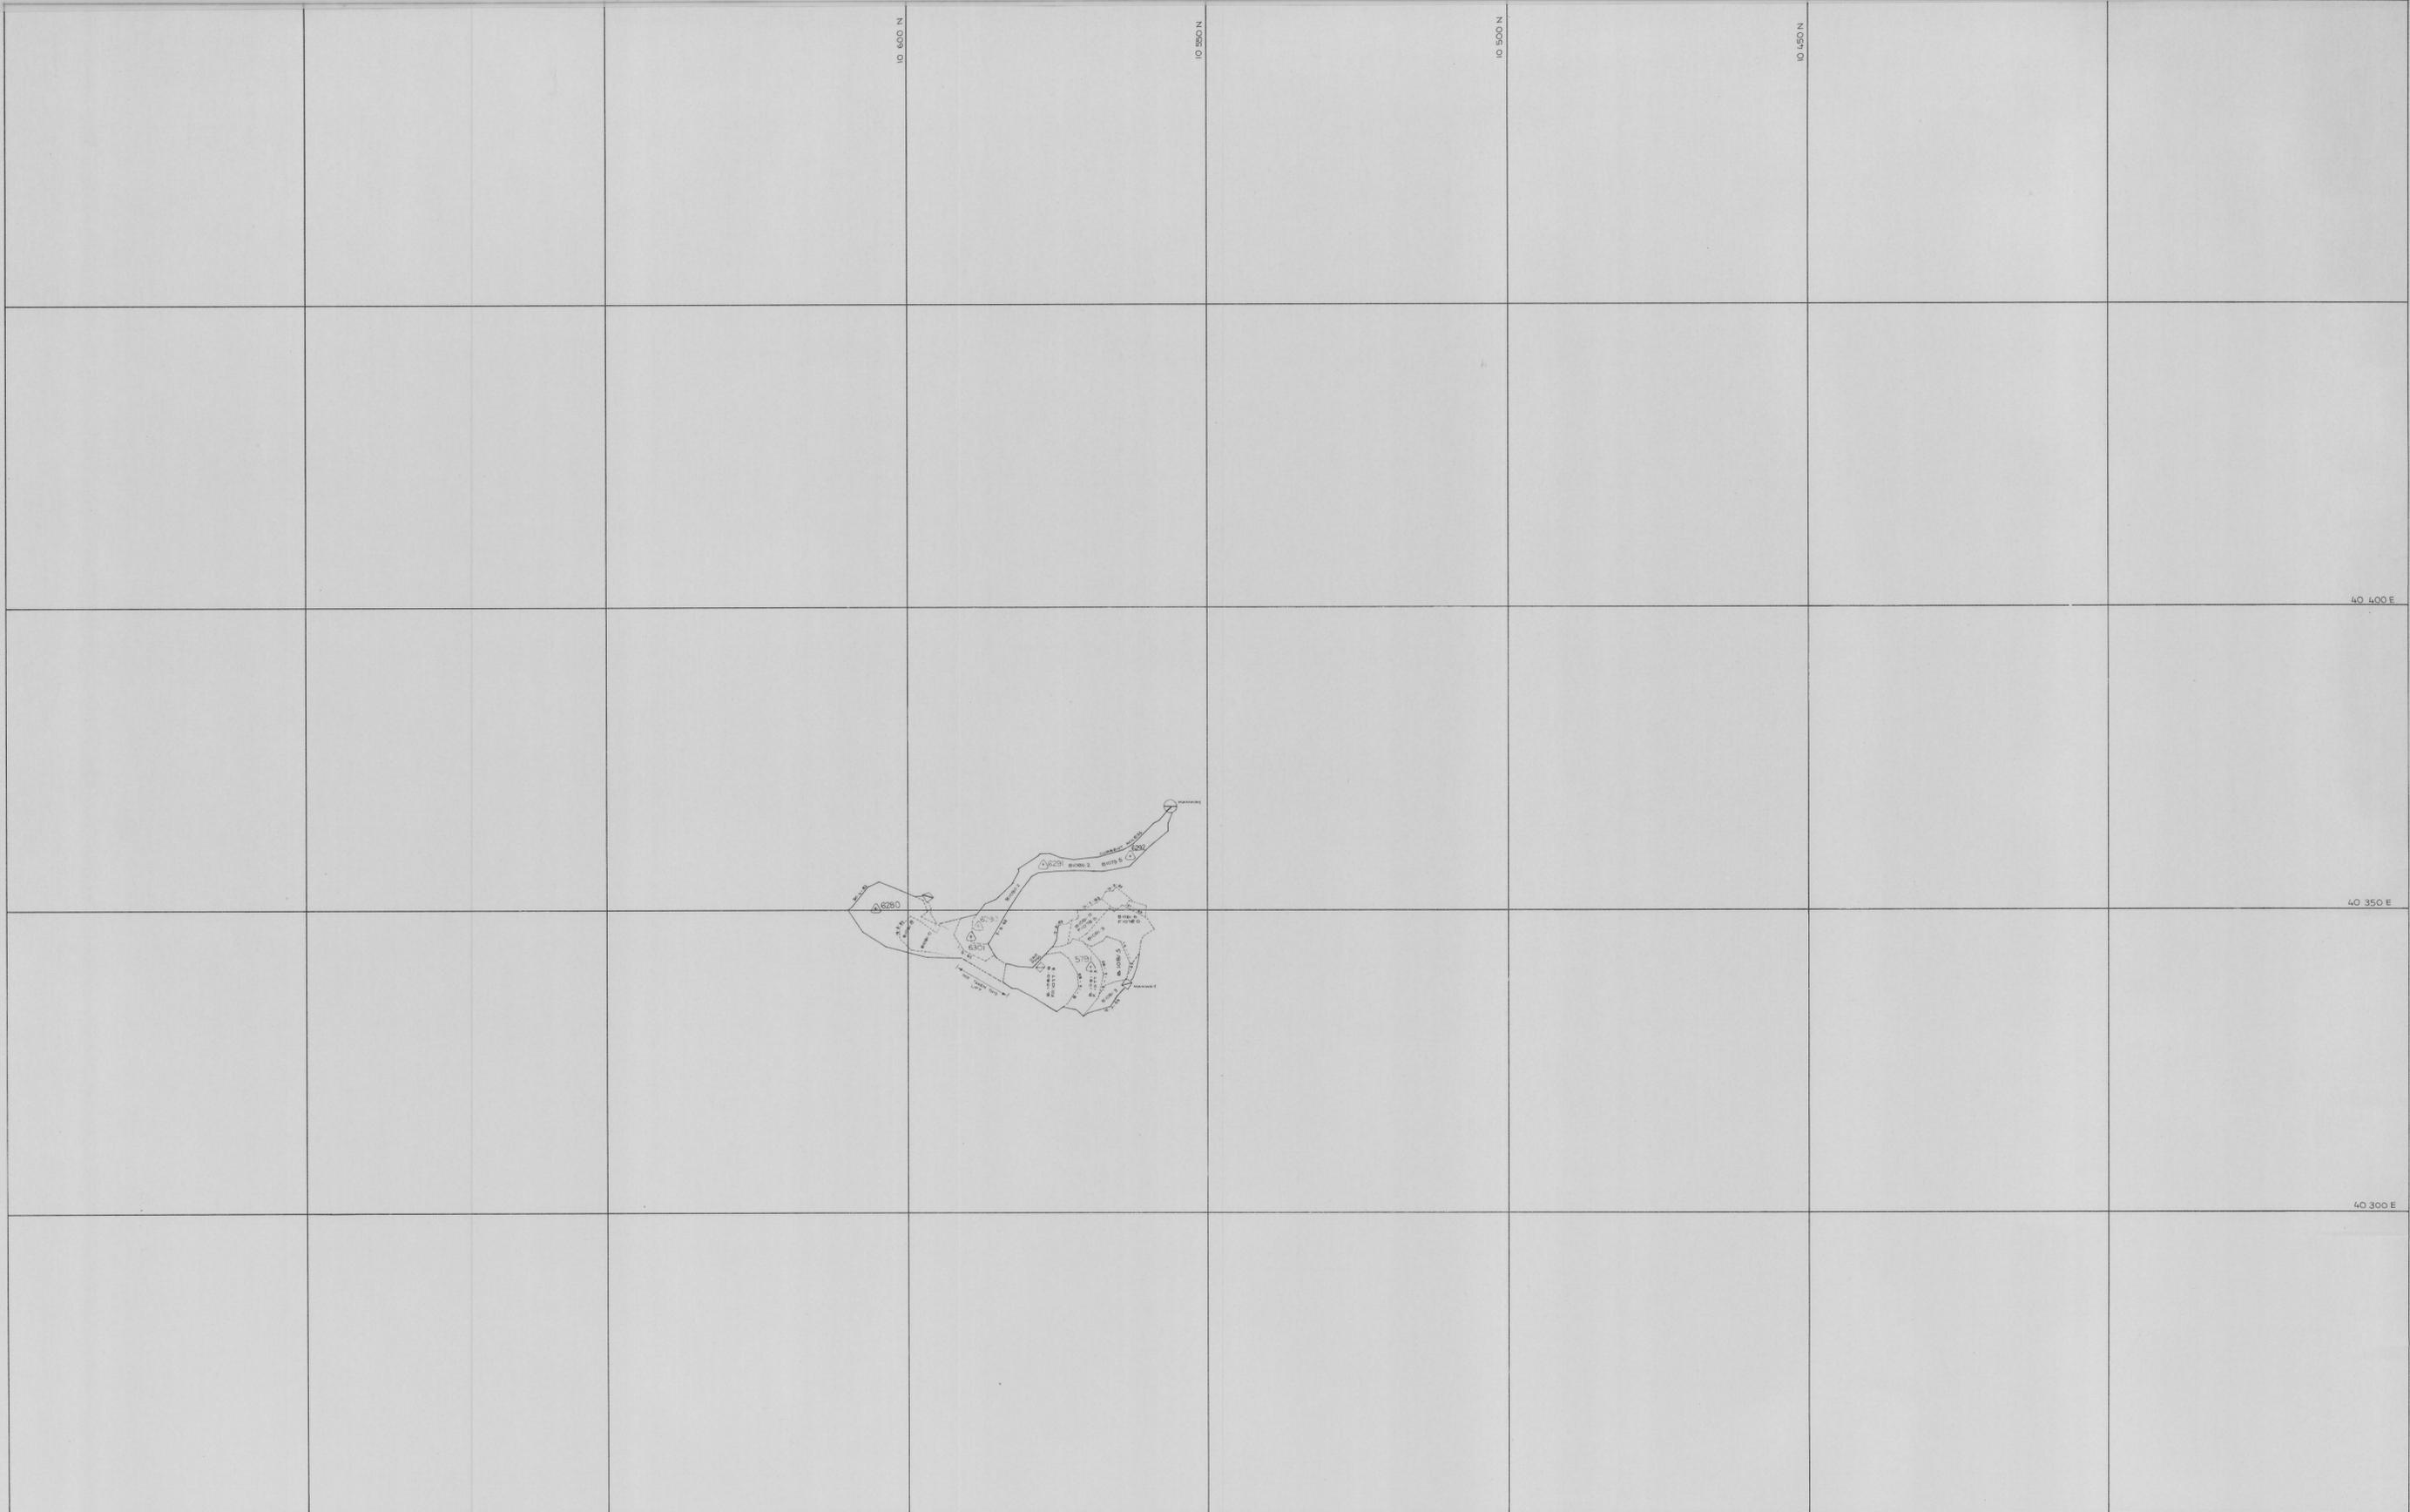
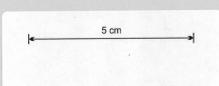


0374-083

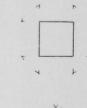

	<p>SCALE 1:500</p> 	 <p>north</p>	<p>LOCATION BOLD HEAD MINE</p> <p>SUBJECT H50 STOPE 14th lift</p>	 <p>A DIVISION OF WARMAN INTERNATIONAL</p> <p>GRASSY KING ISLAND</p> <p>PLAN NUMBER 04BH15 - 103 - 86</p>
--	----------------------------------------------------------------------------------------------------------	----------------------------------------------------------------------------------------------------	-----------------------------------------------------------------------	------------------------------------------------------------------------------------------------------------------------------------------------------------------------------------------------

83351