



0374-087

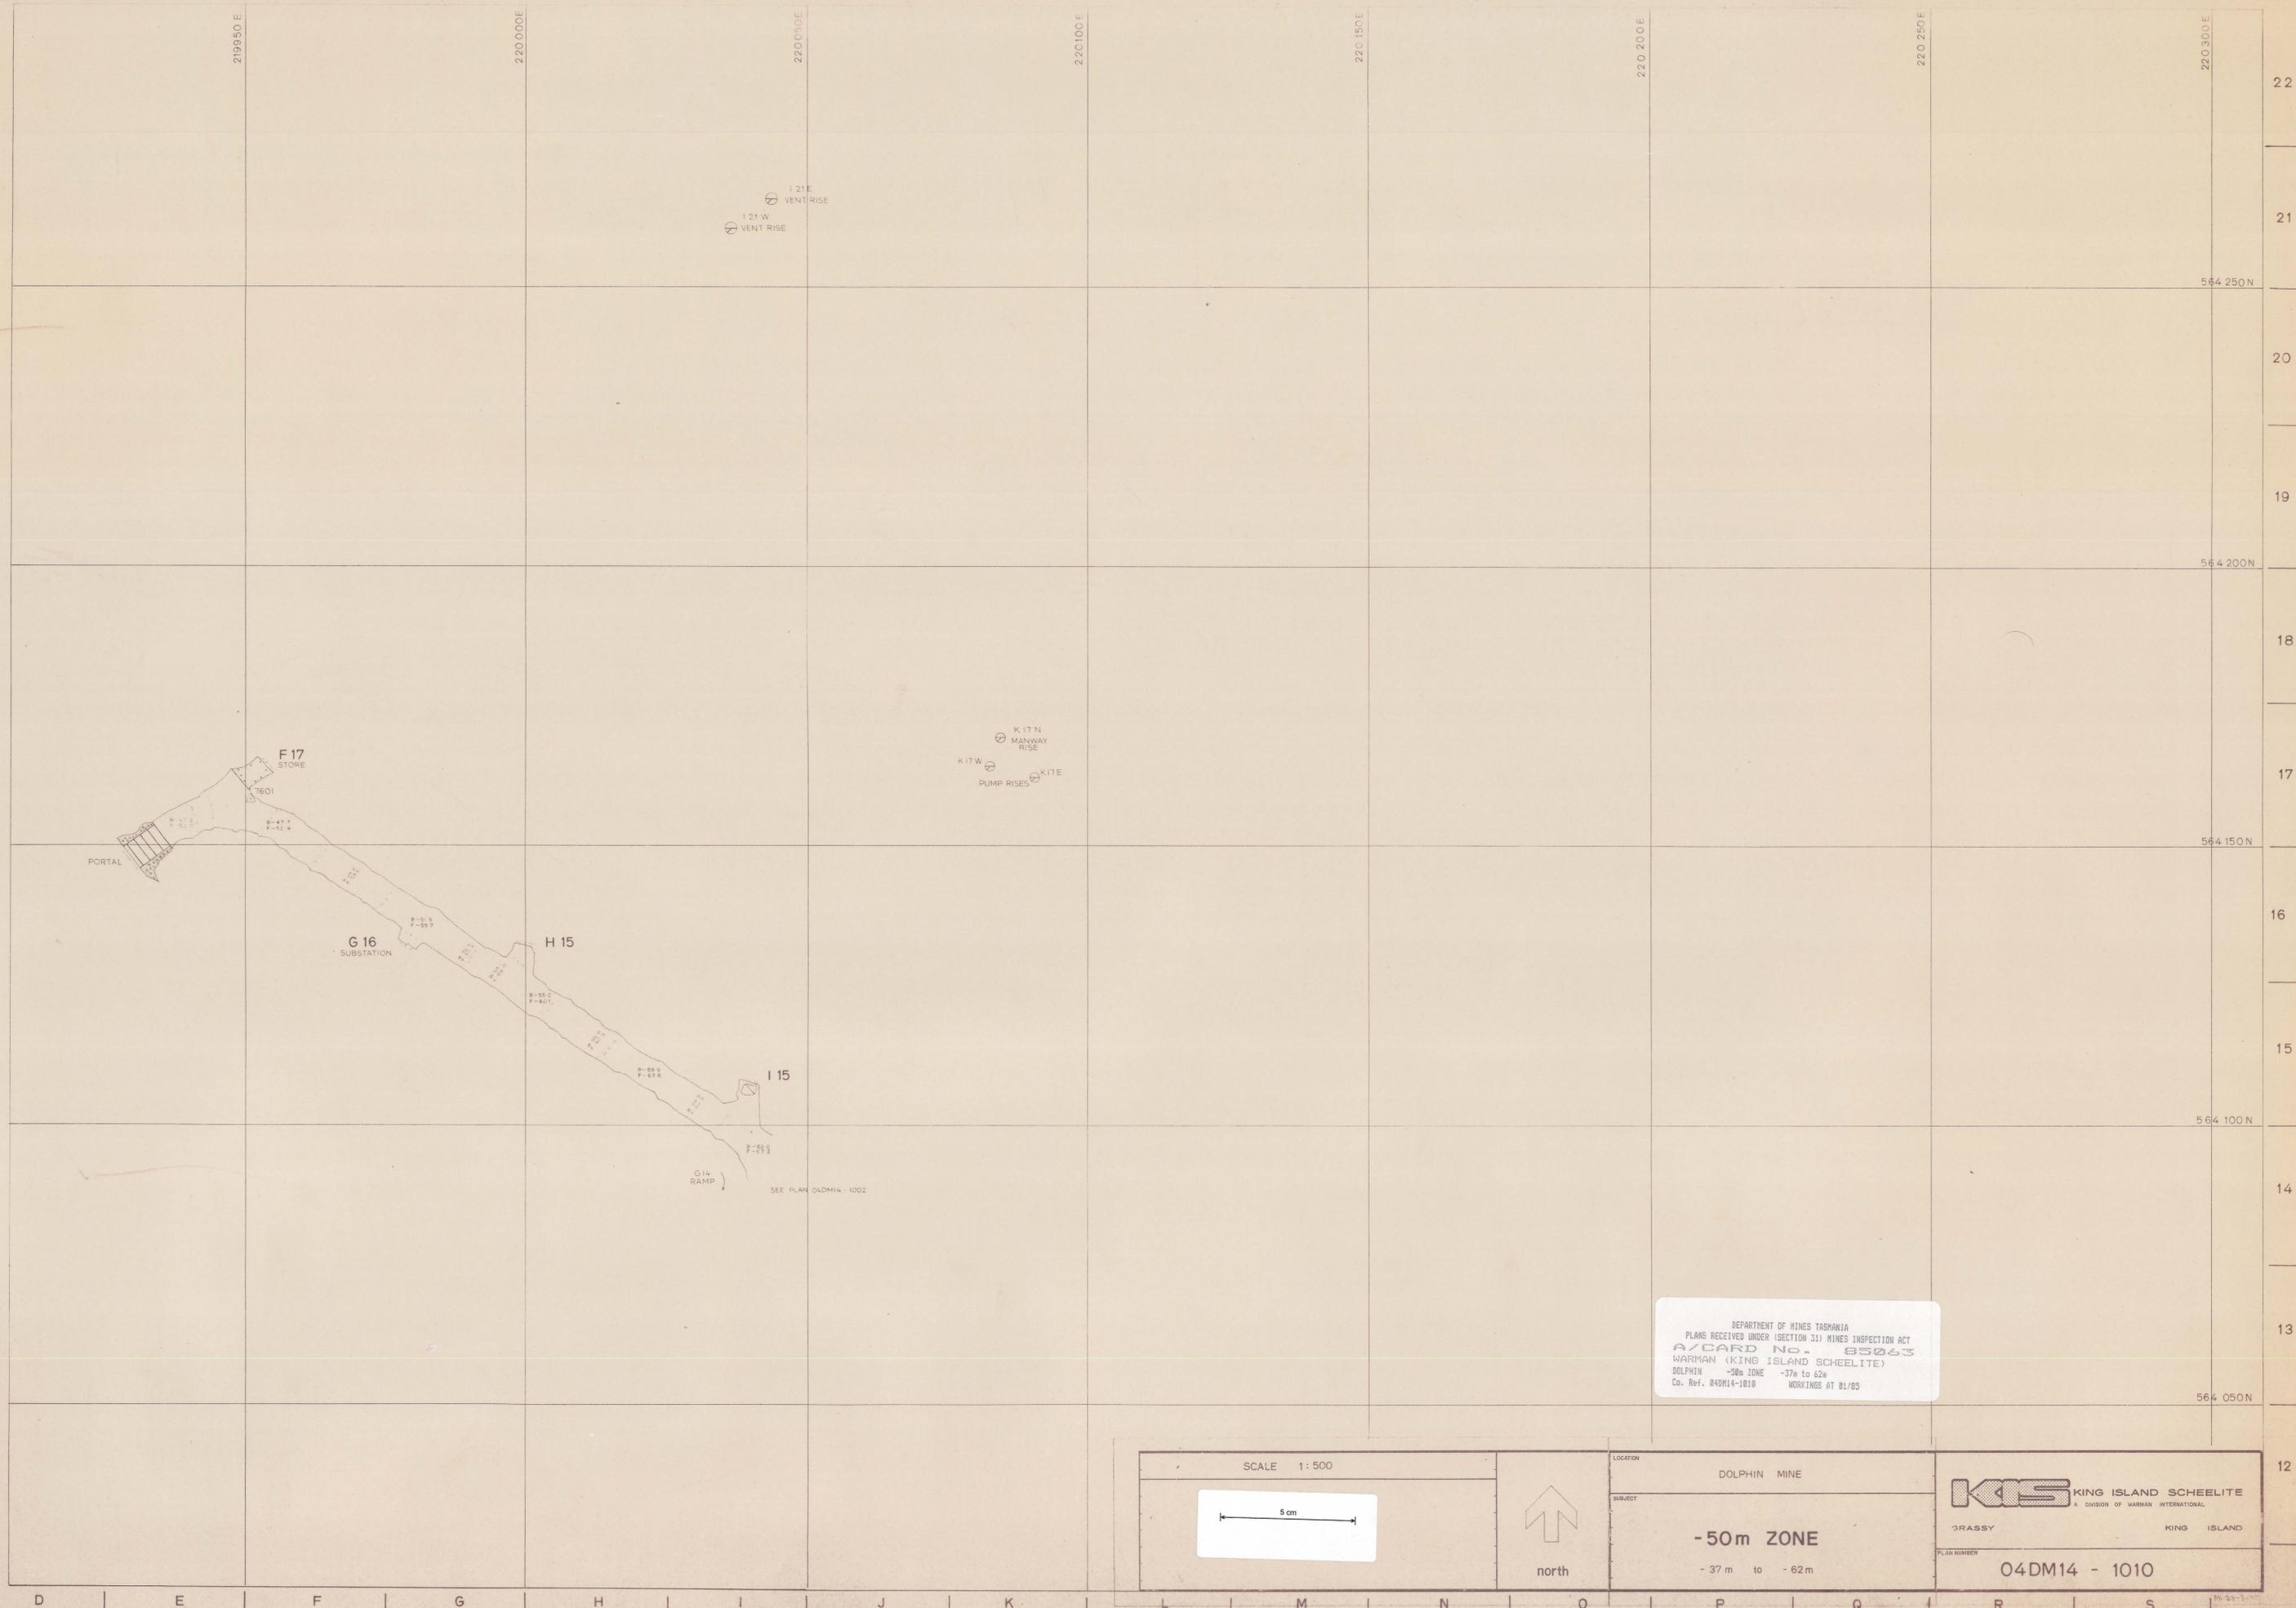

DEPARTMENT OF MINES TASMANIA
 PLANS RECEIVED UNDER SECTION 311 MINES INSPECTION ACT
 A/CARD No. 85263
 WARMAN (KING ISLAND SCHEELITE)
 DOLPHIN -50m ZONE -37m to 62m
 Co. Ref. 04DM14-1010 WORKINGS AT 01/85

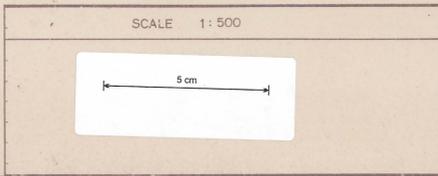

LOCATION DOLPHIN MINE
 SUBJECT -50m ZONE
 -37m to -62m

KING ISLAND SCHEELITE
 A DIVISION OF WARMAN INTERNATIONAL
 GRASSY KING ISLAND
 PLAN NUMBER 04DM14 - 1010

D E F G H I J K L M N O P Q R S

22
 21
 564 250 N
 20
 19
 564 200 N
 18
 17
 564 150 N
 16
 15
 564 100 N
 14
 13
 564 050 N
 12