
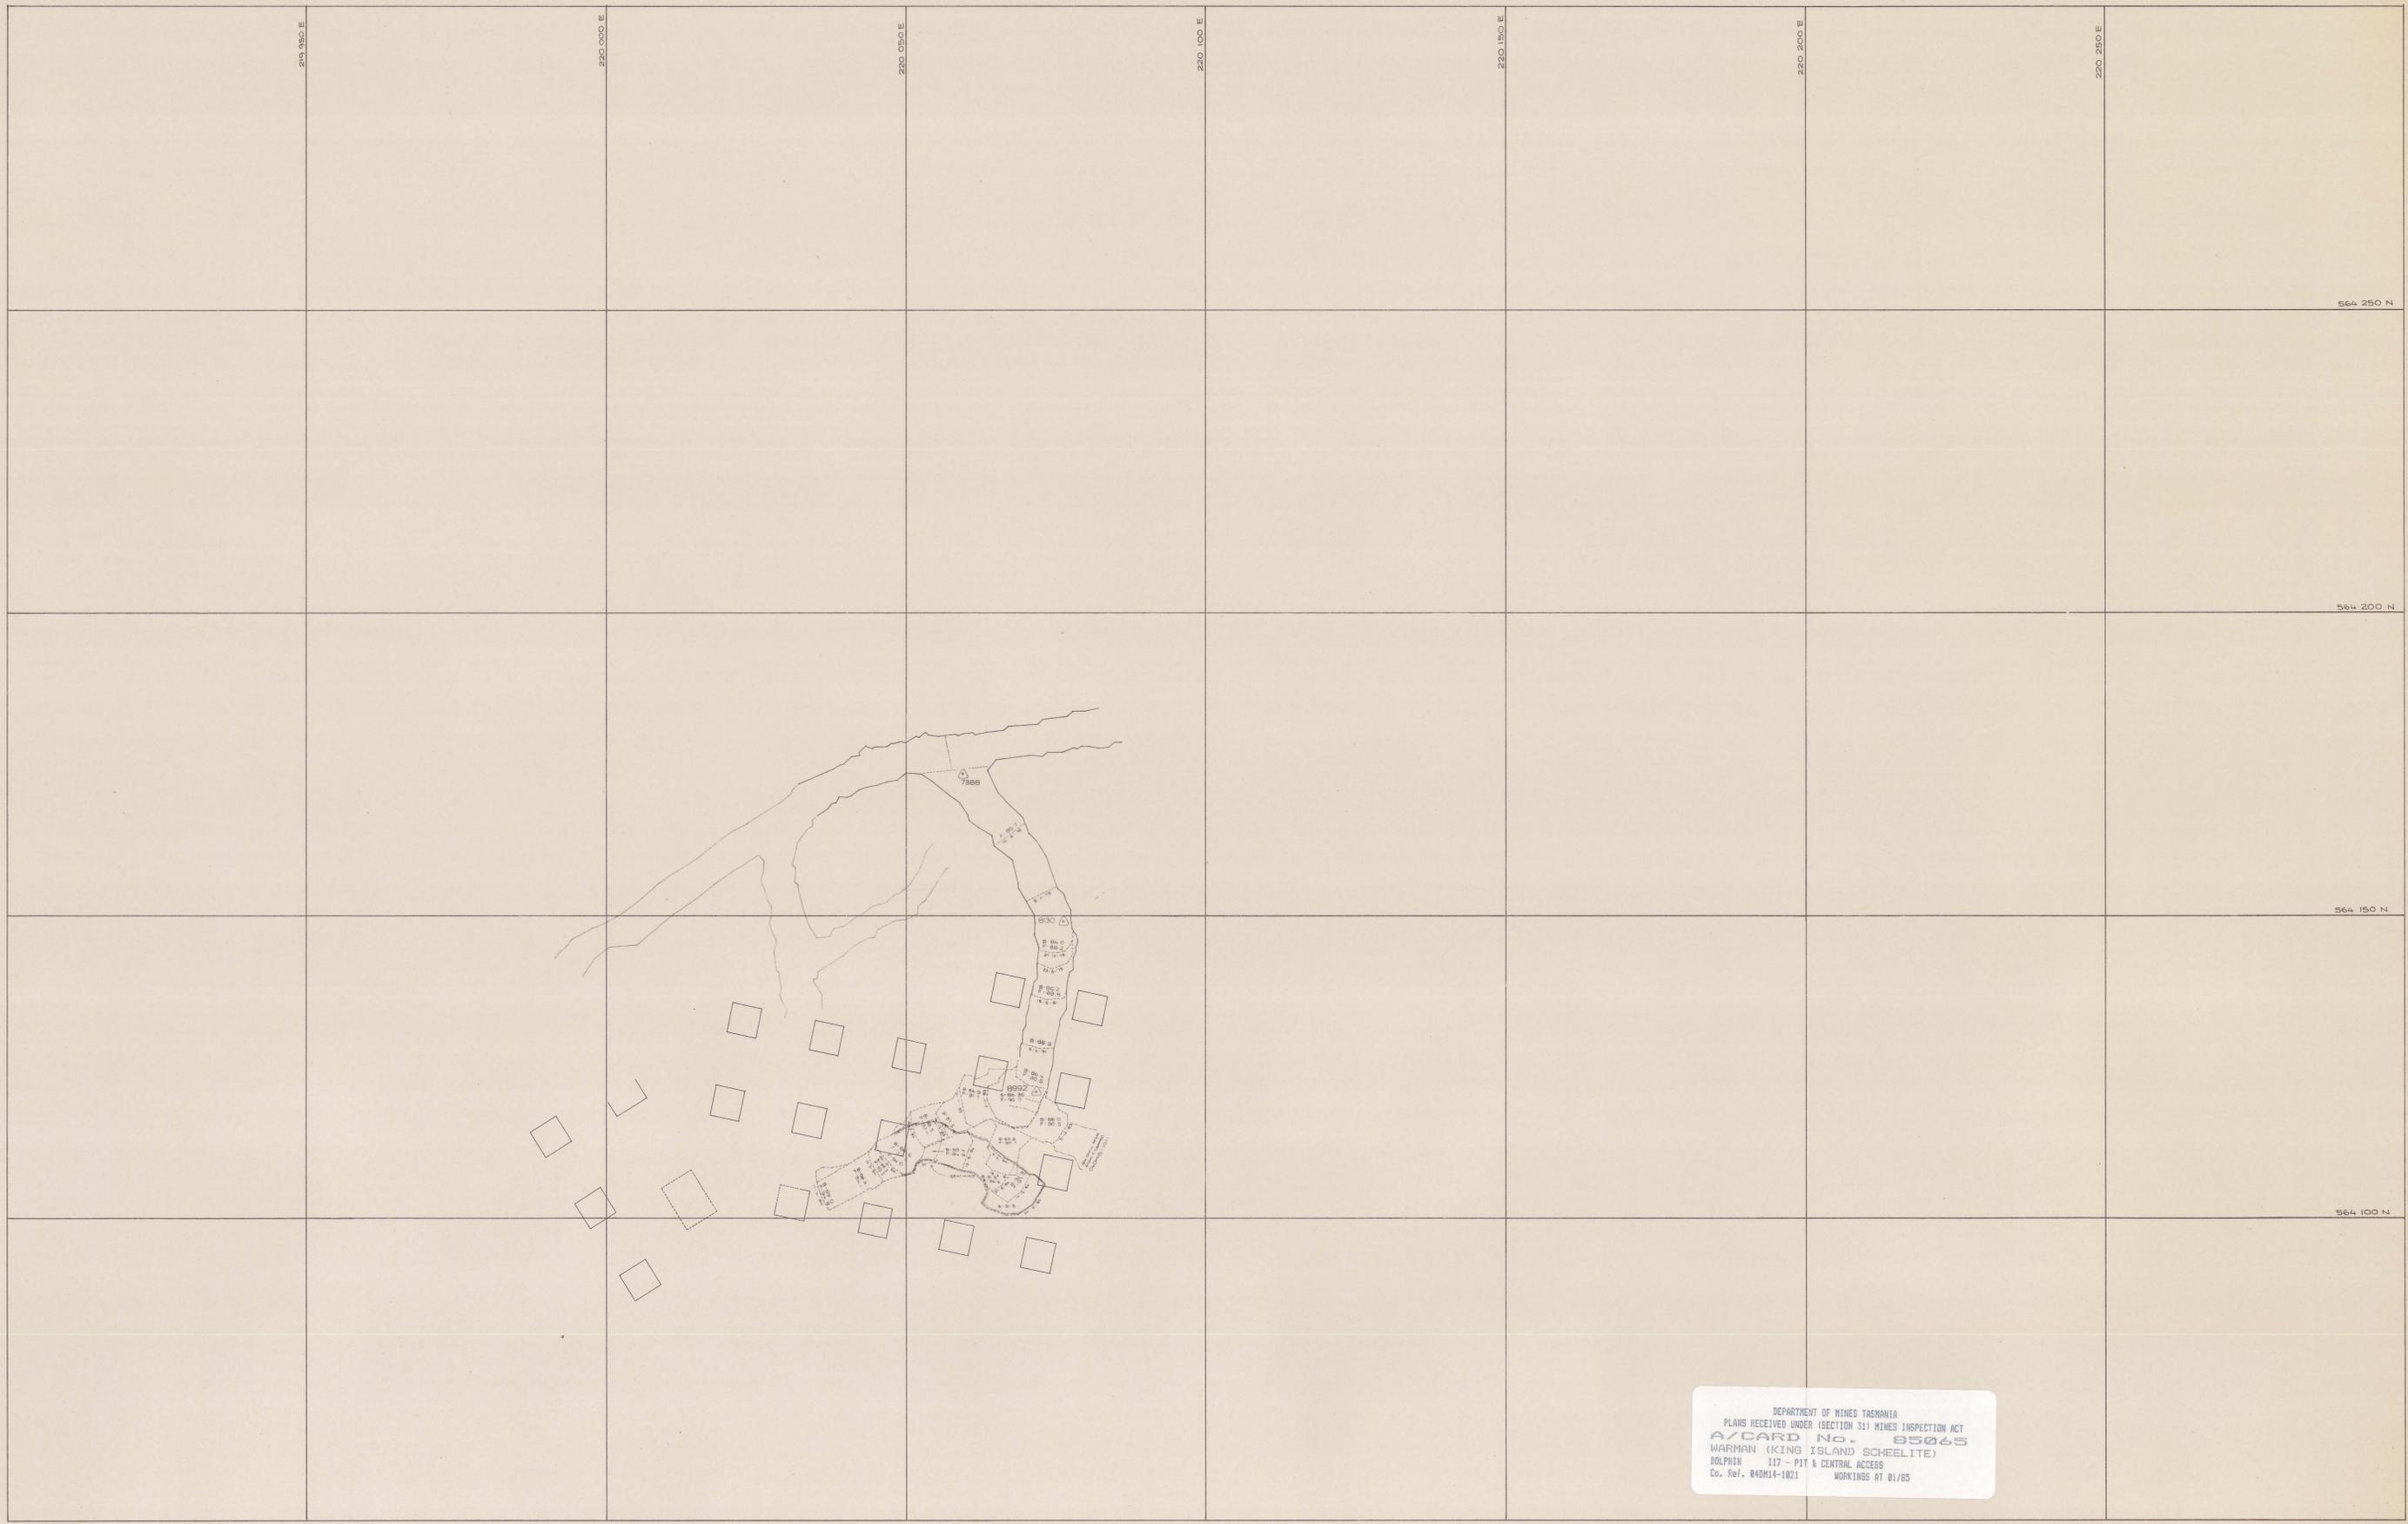


0374-090

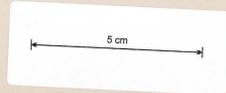

DEPARTMENT OF MINES TASMANIA
 PLANS RECEIVED UNDER (SECTION 31) MINES INSPECTION ACT
A/CARD No. 85065
 WARMAN (KING ISLAND SCHEELITE)
 DOLPHIN 117 - PIT & CENTRAL ACCESS
 Co. Ref. 04DM14-1021 WORKINGS AT 01/85

	SCALE 1:500 	 north	LOCATION DOLPHIN MINE SUBJECT 117 - PIT & CENTRAL ACCESS	 KING ISLAND SCHEELITE A DIVISION OF WARMAN INTERNATIONAL GRASSY KING ISLAND PLAN NUMBER 04DM14 - 1021
--	--	--	---	--