


0374-093

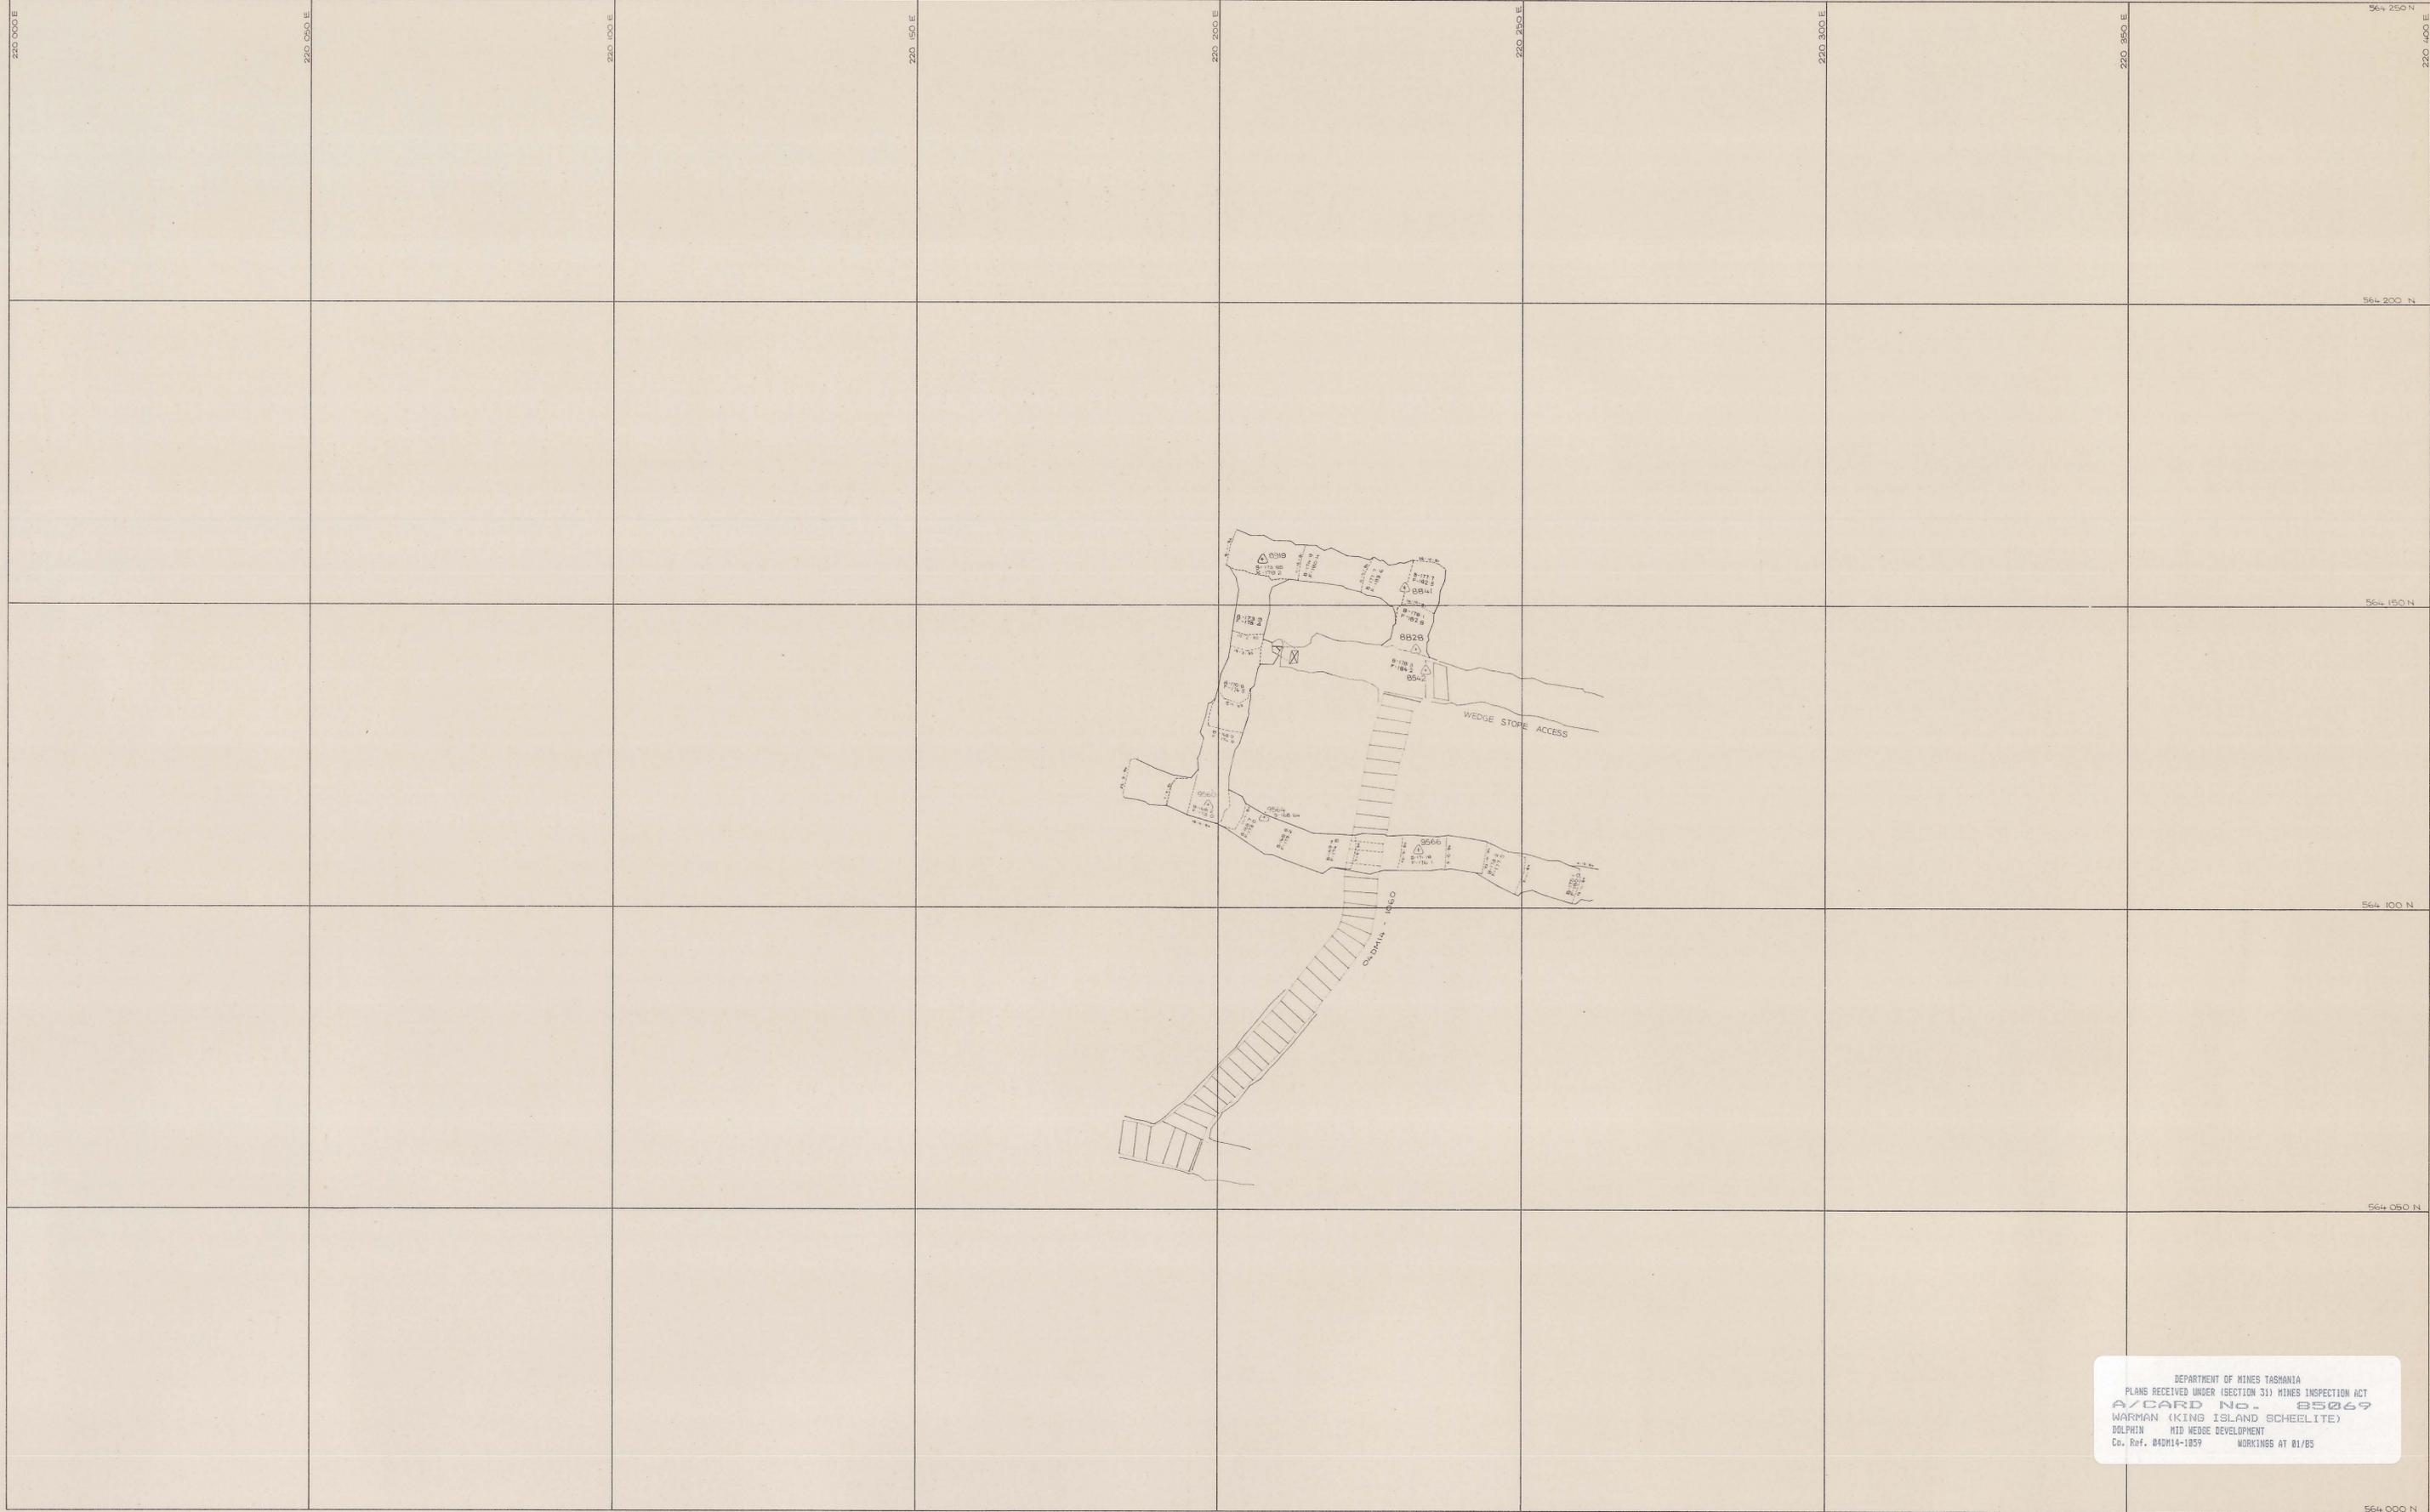

DEPARTMENT OF MINES TASMANIA  
 PLANS RECEIVED UNDER (SECTION 31) MINES INSPECTION ACT  
 A/CARD No. 85269  
 WARMAN (KING ISLAND SCHEELITE)  
 DOLPHIN MID WEDGE DEVELOPMENT  
 Co. Ref. 04DM14-1059 WORKINGS AT 01/85

|  |             |  |                                  |   |
|--|-------------|--|----------------------------------|---|
|  | SCALE 1:500 |  | LOCATION<br>DOLPHIN MINE         | <b>KING ISLAND SCHEELITE</b><br><small>A DIVISION OF WARMAN INTERNATIONAL</small> |
|  |             |  | SUBJECT<br>MID WEDGE DEVELOPMENT |   |