


0374-095

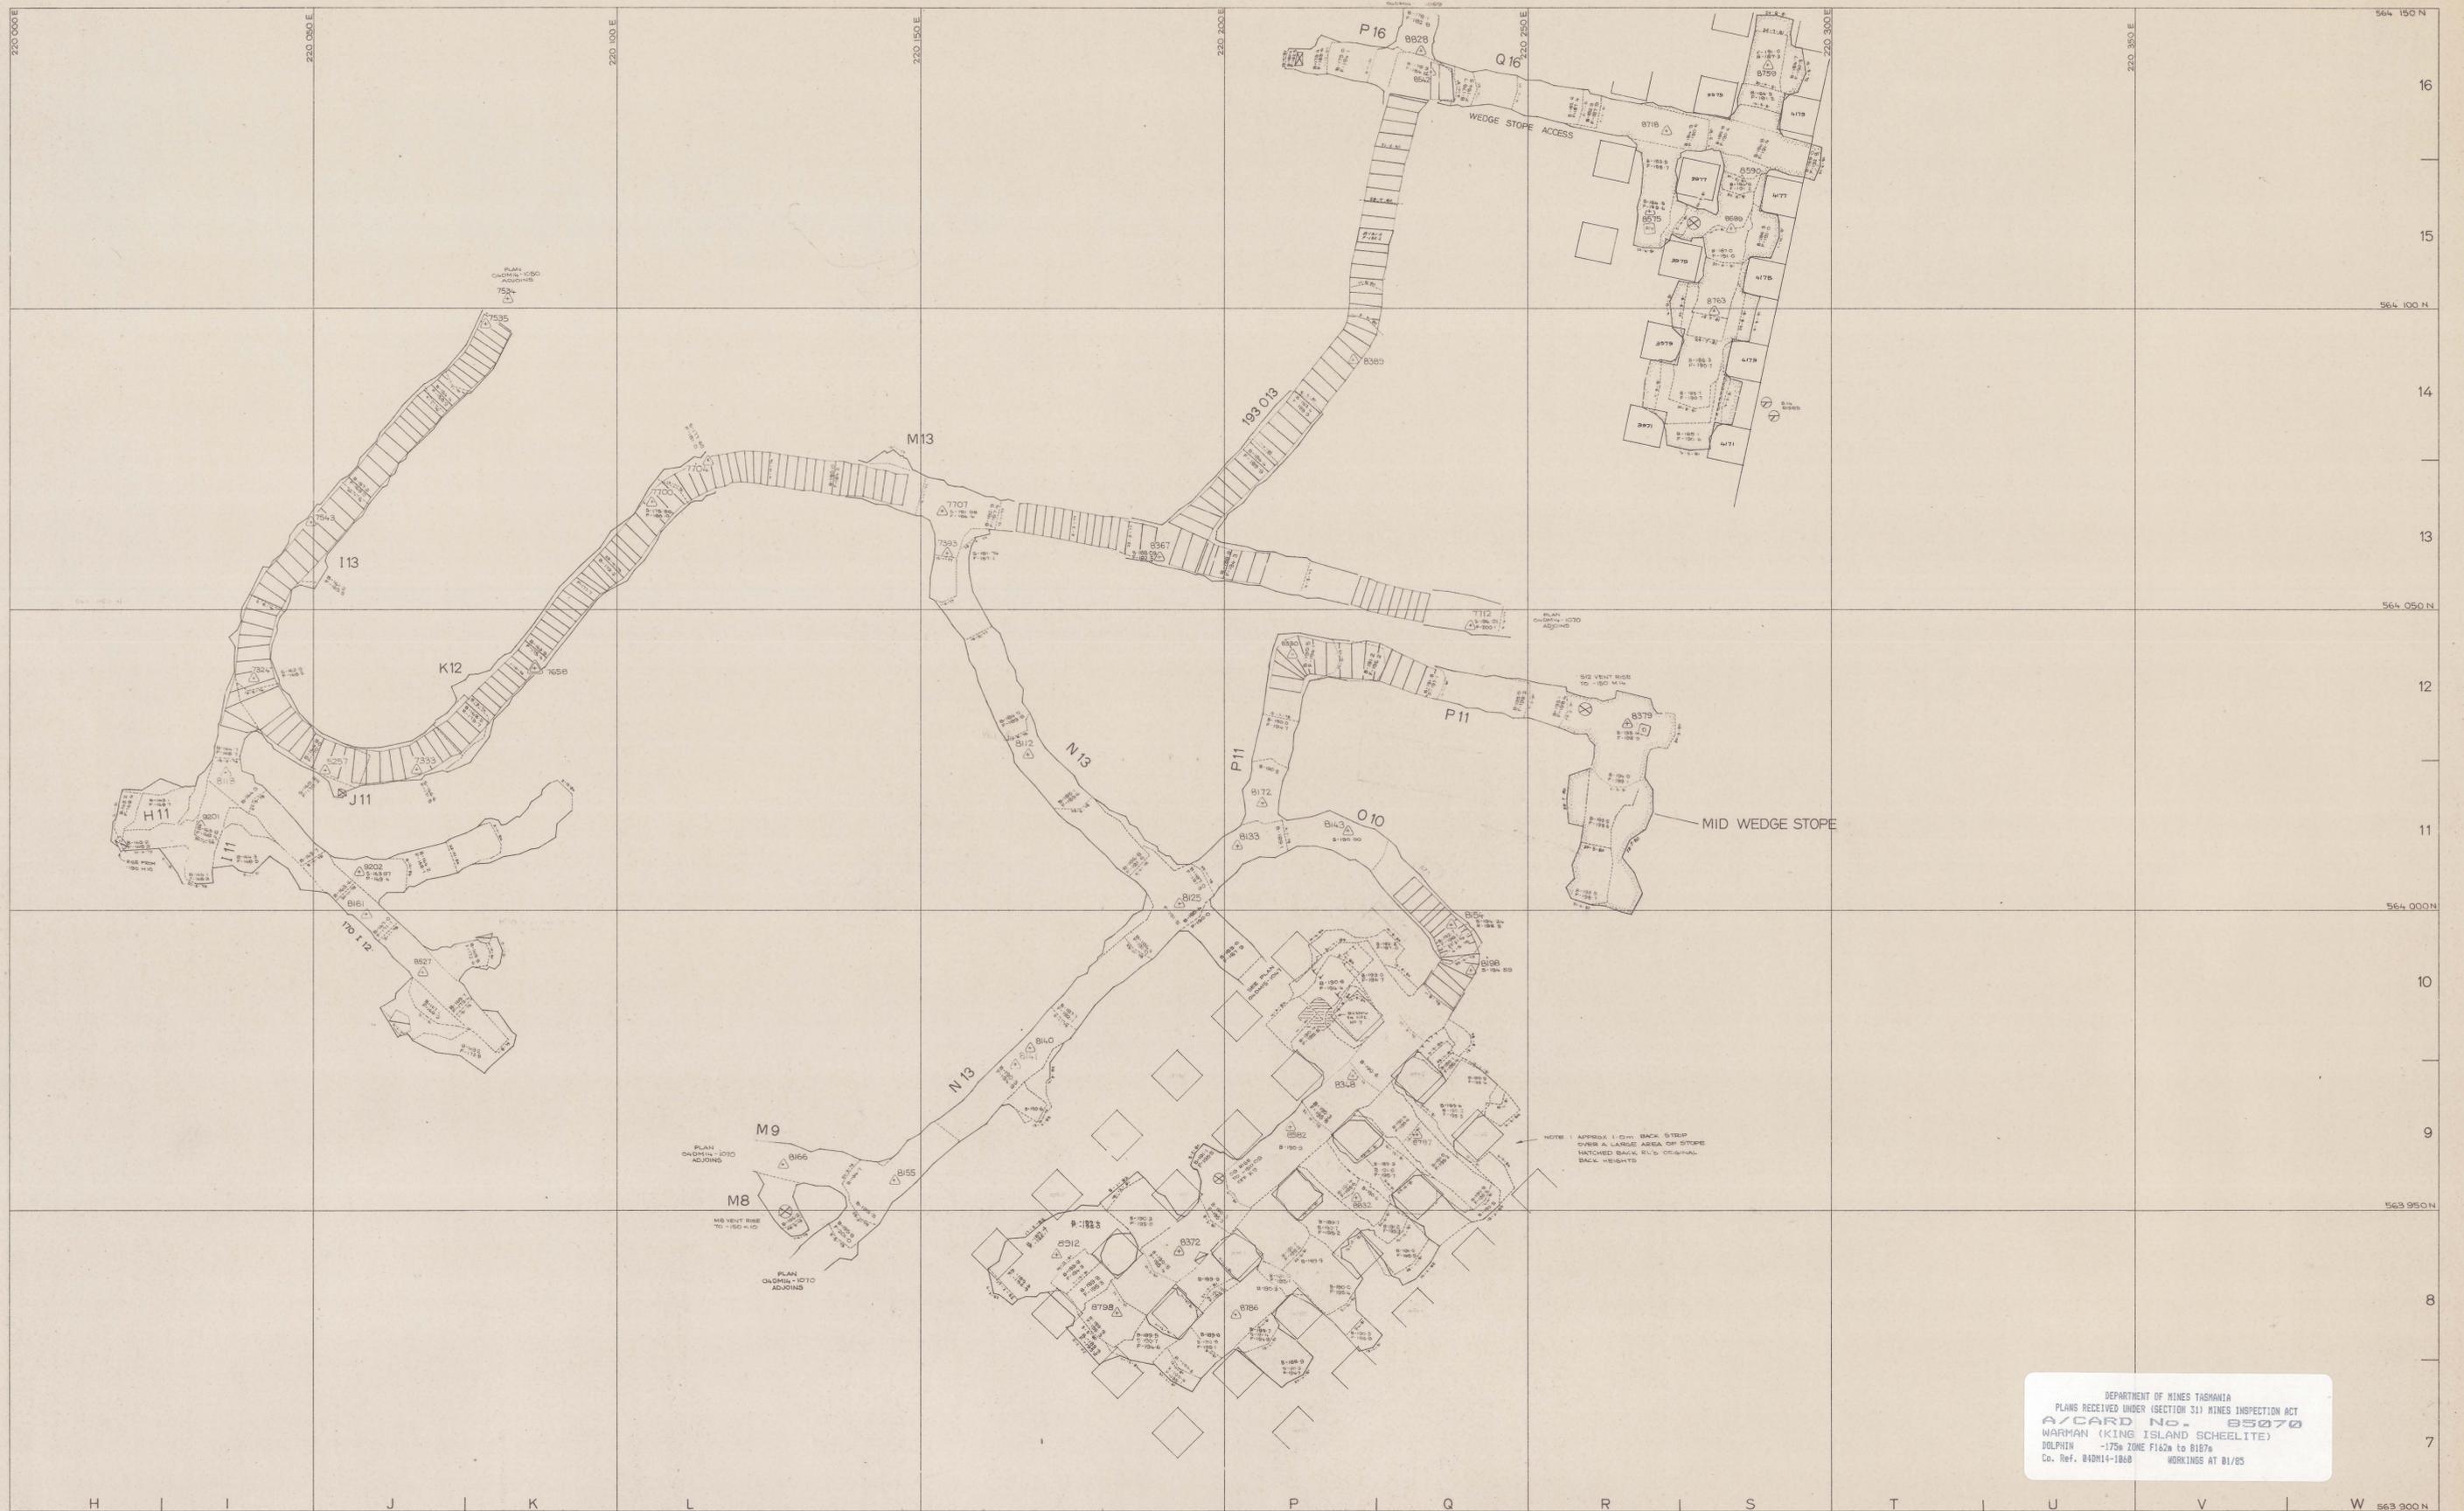

DEPARTMENT OF MINES TASMANIA
 PLANS RECEIVED UNDER (SECTION 31) MINES INSPECTION ACT
A/CARD No. - 85870
 WARMAN (KING ISLAND SCHEELITE)
 DOLPHIN -175m ZONE F162m to B187m
 Co. Ref. 04DM14-1060 WORKINGS AT 01/85

SCALE 1:500 	LOCATION DOLPHIN MINE	KING ISLAND GRASSY
	SUBJECT -175m ZONE F-162m to B-187m	

h. 5.8 m