
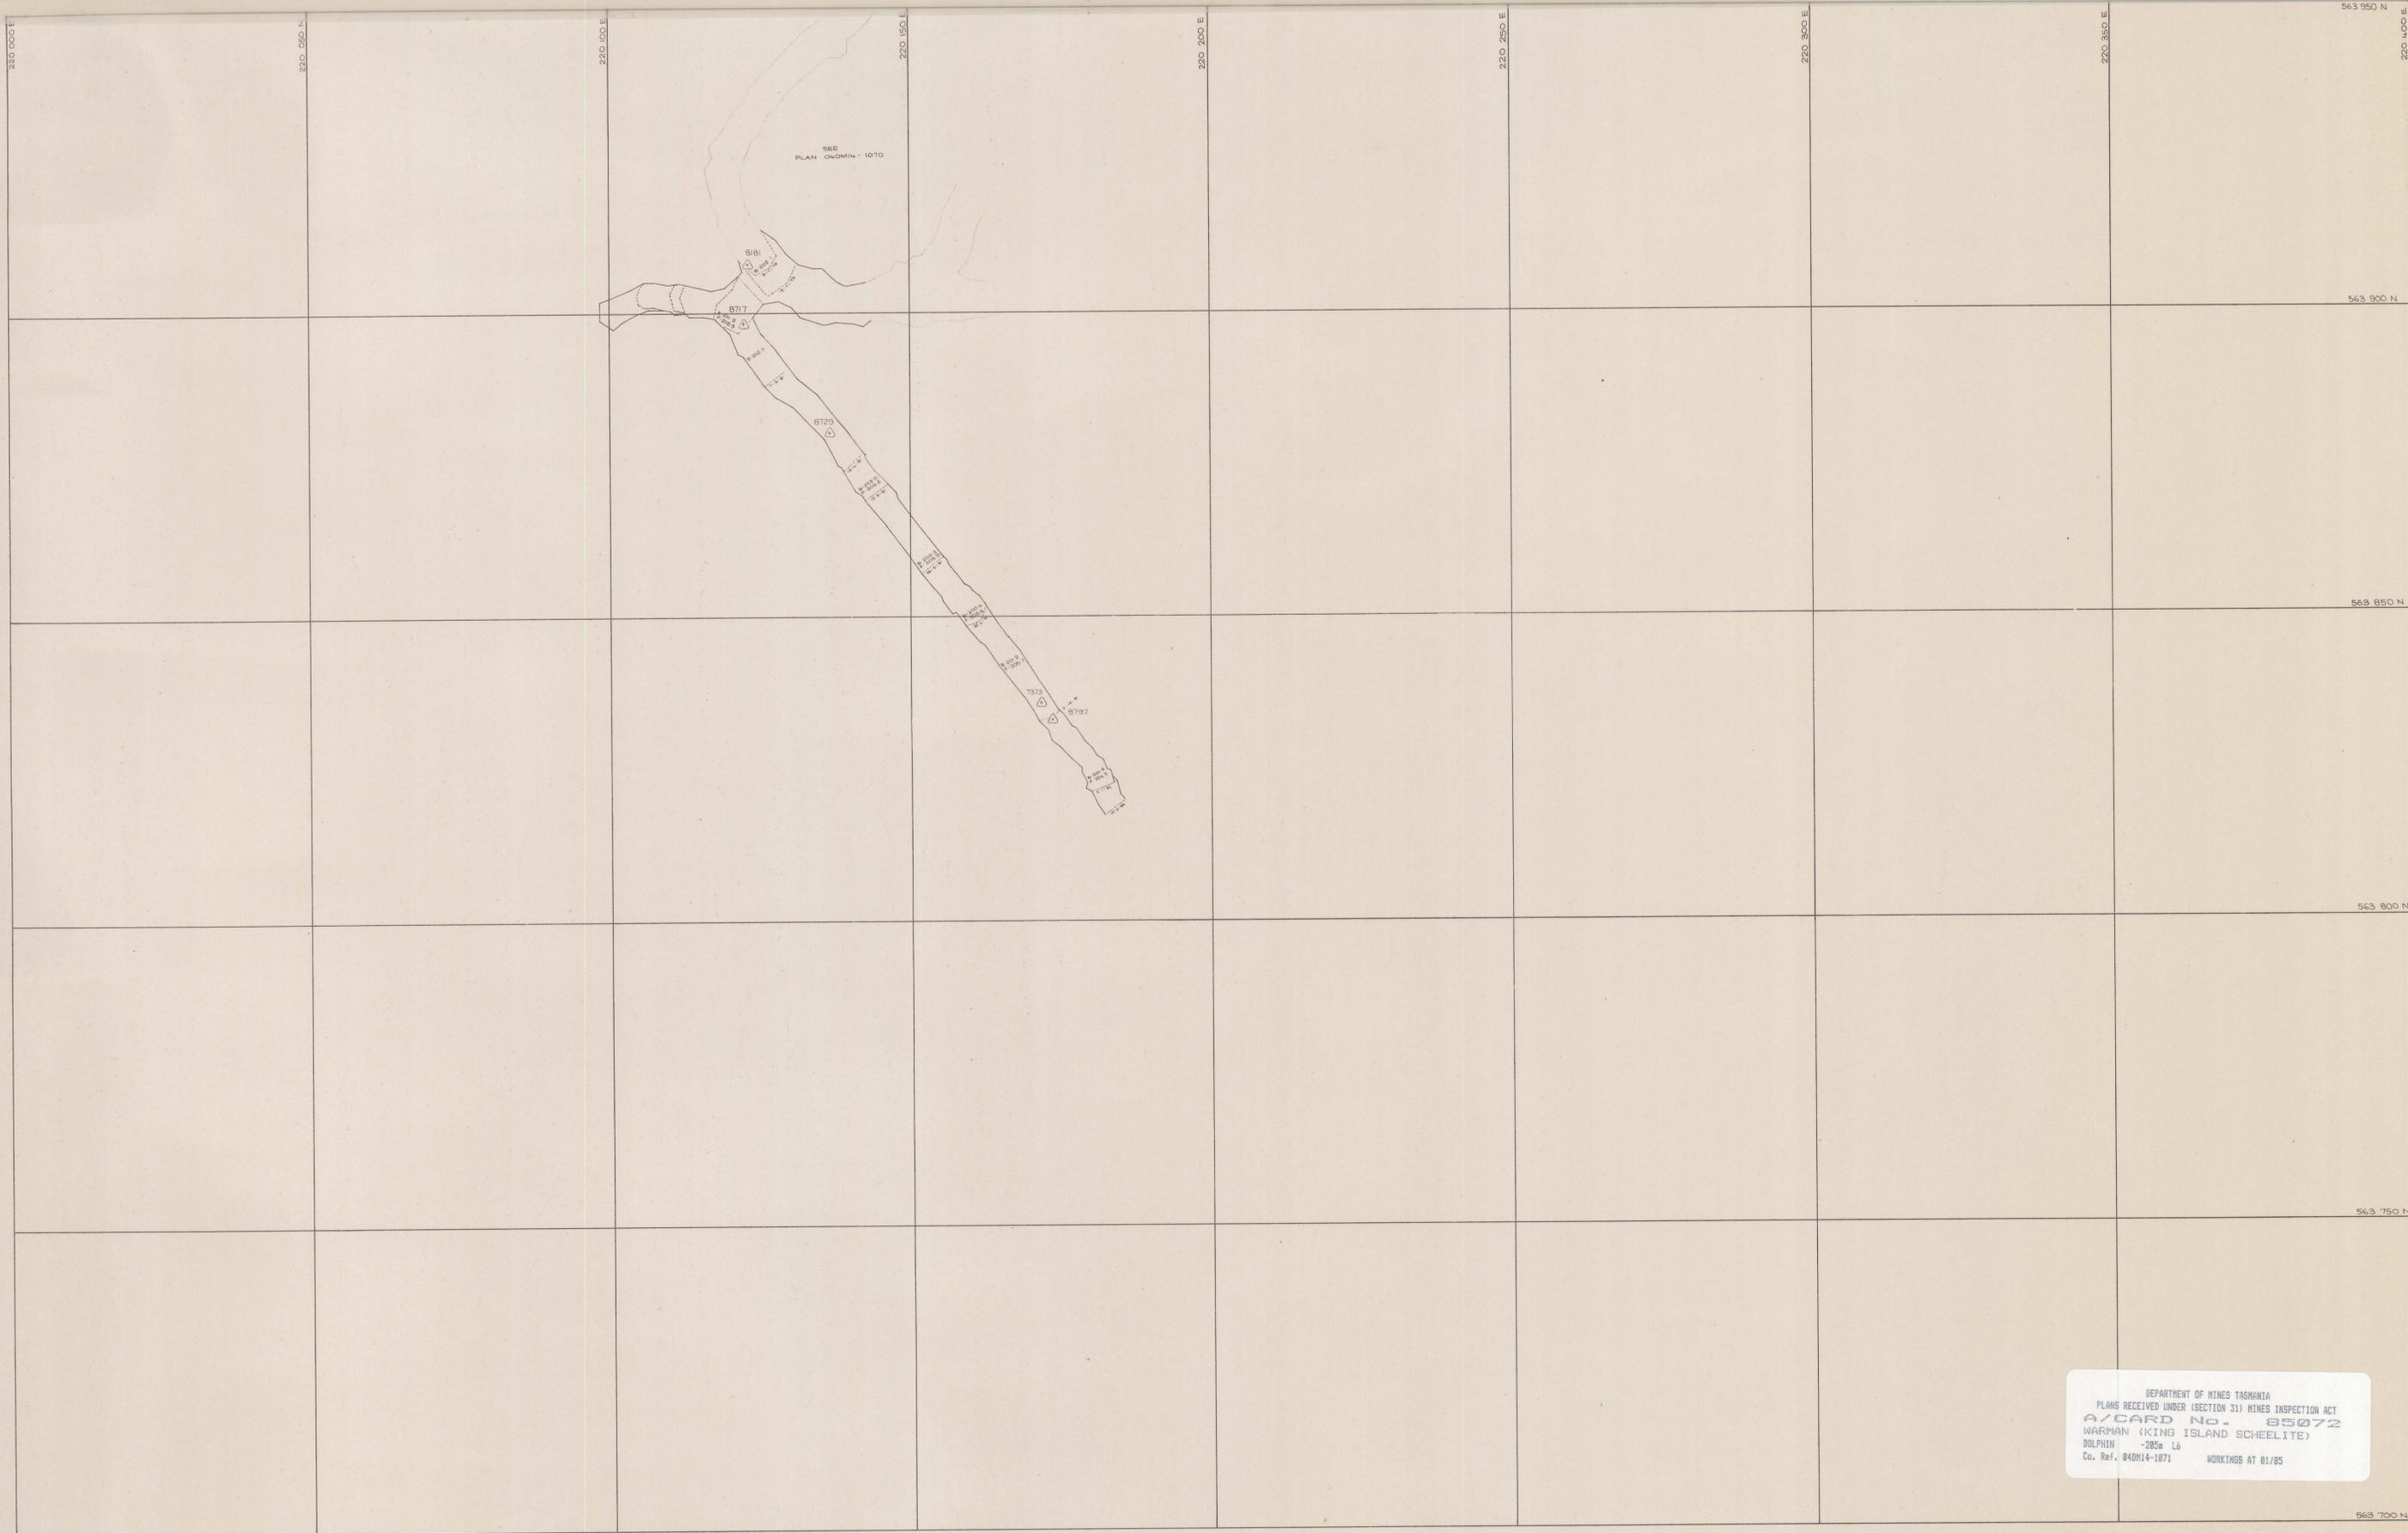


0374-096

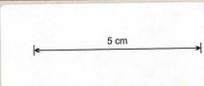

DEPARTMENT OF MINES TASMANIA  
 PLANS RECEIVED UNDER (SECTION 31) MINES INSPECTION ACT  
 A/CARD No. 83072  
 WARMAN (KING ISLAND SCHEELITE)  
 DOLPHIN -205 L6  
 Co. Ref. 04DM14-1071 WORKINGS AT 01/95

	SCALE 1:500 		LOCATION DOLPHIN MINE SUBJECT -205 L 6 DIAMOND DRILL DRIVE	 A DIVISION OF WARMAN INTERNATIONAL GRASSY KING ISLAND PLAN NUMBER 04DM14 - 1071
--	--	---	--	--