



0374-097

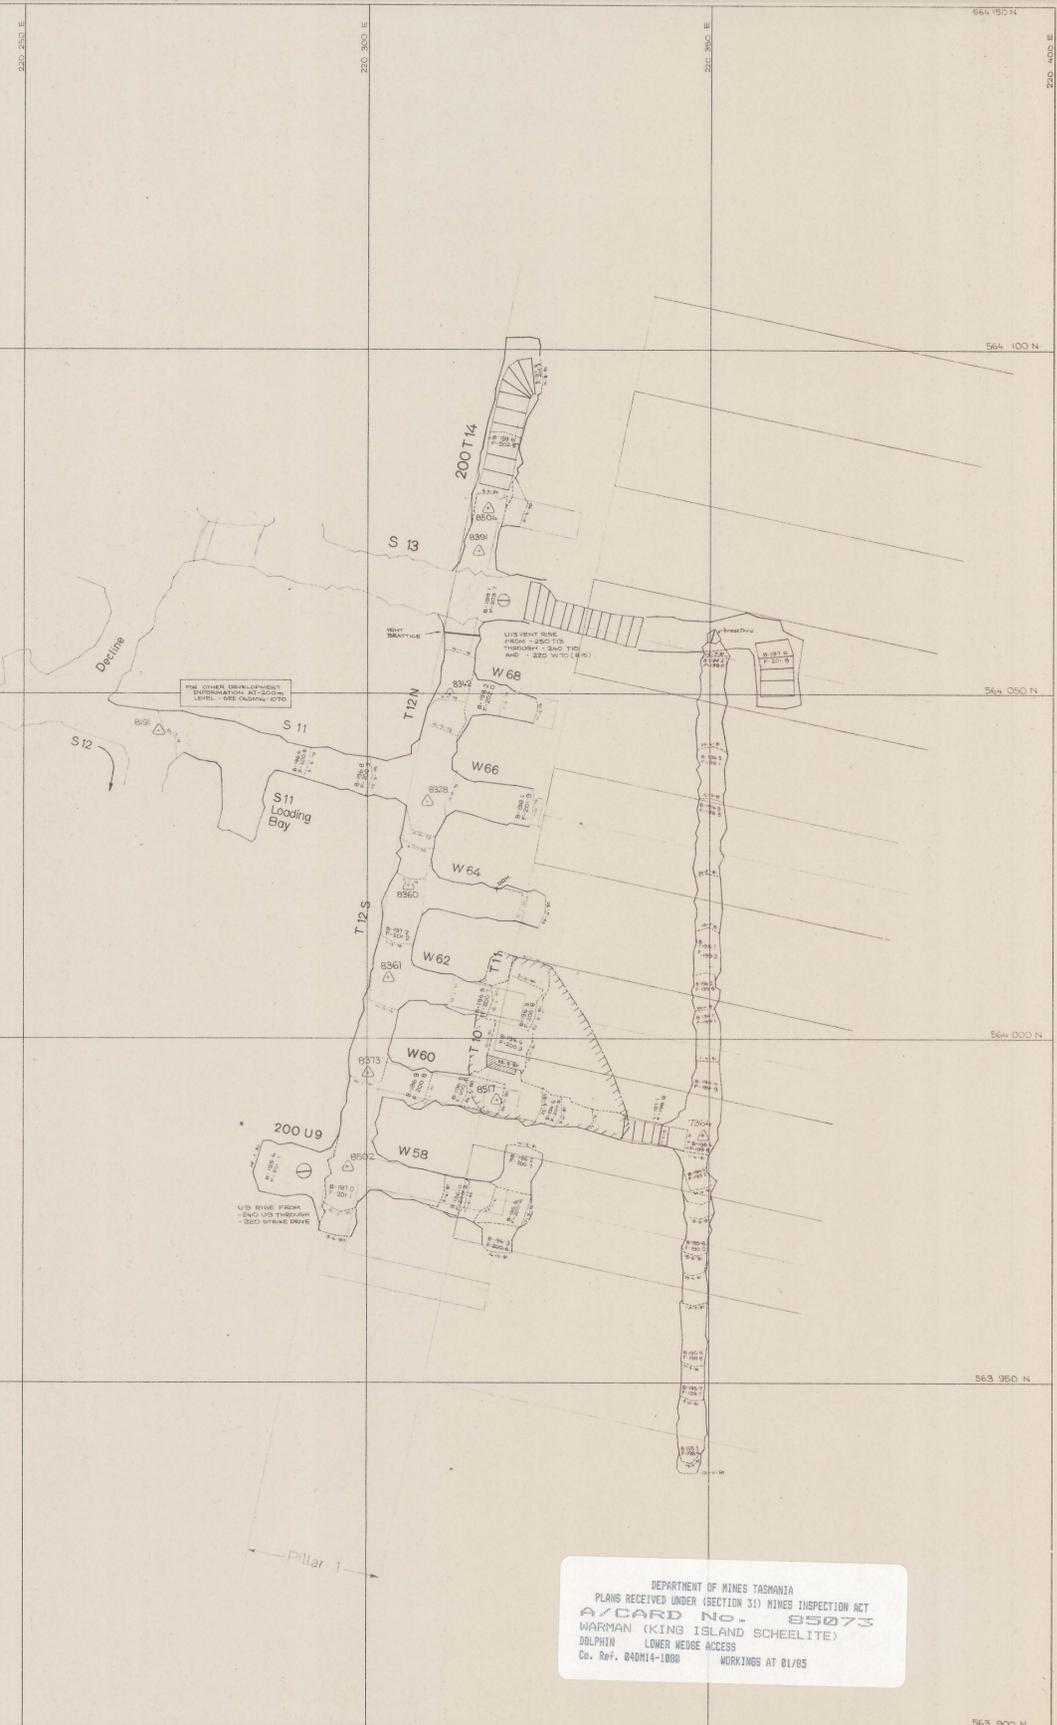

DEPARTMENT OF MINES TASMANIA
 PLANS RECEIVED UNDER (SECTION 31) MINES INSPECTION ACT
 A/CARD No. B5073
 WARMAN (KING ISLAND SCHEELITE)
 DOLPHIN LOWER WEDGE ACCESS
 Co. Ref. 04DM14-1080 WORKINGS AT 01/85

SCALE 1:500

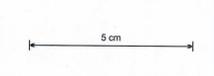

north

LOCATION DOLPHIN MINE
 SUBJECT LOWER WEDGE ACCESS
 -200m LEVEL

KIS KING ISLAND SCHEELITE
 A DIVISION OF WARMAN INTERNATIONAL
 GRASSY KING ISLAND
 PLAN NUMBER 04DM14 - 1080