


0374-101

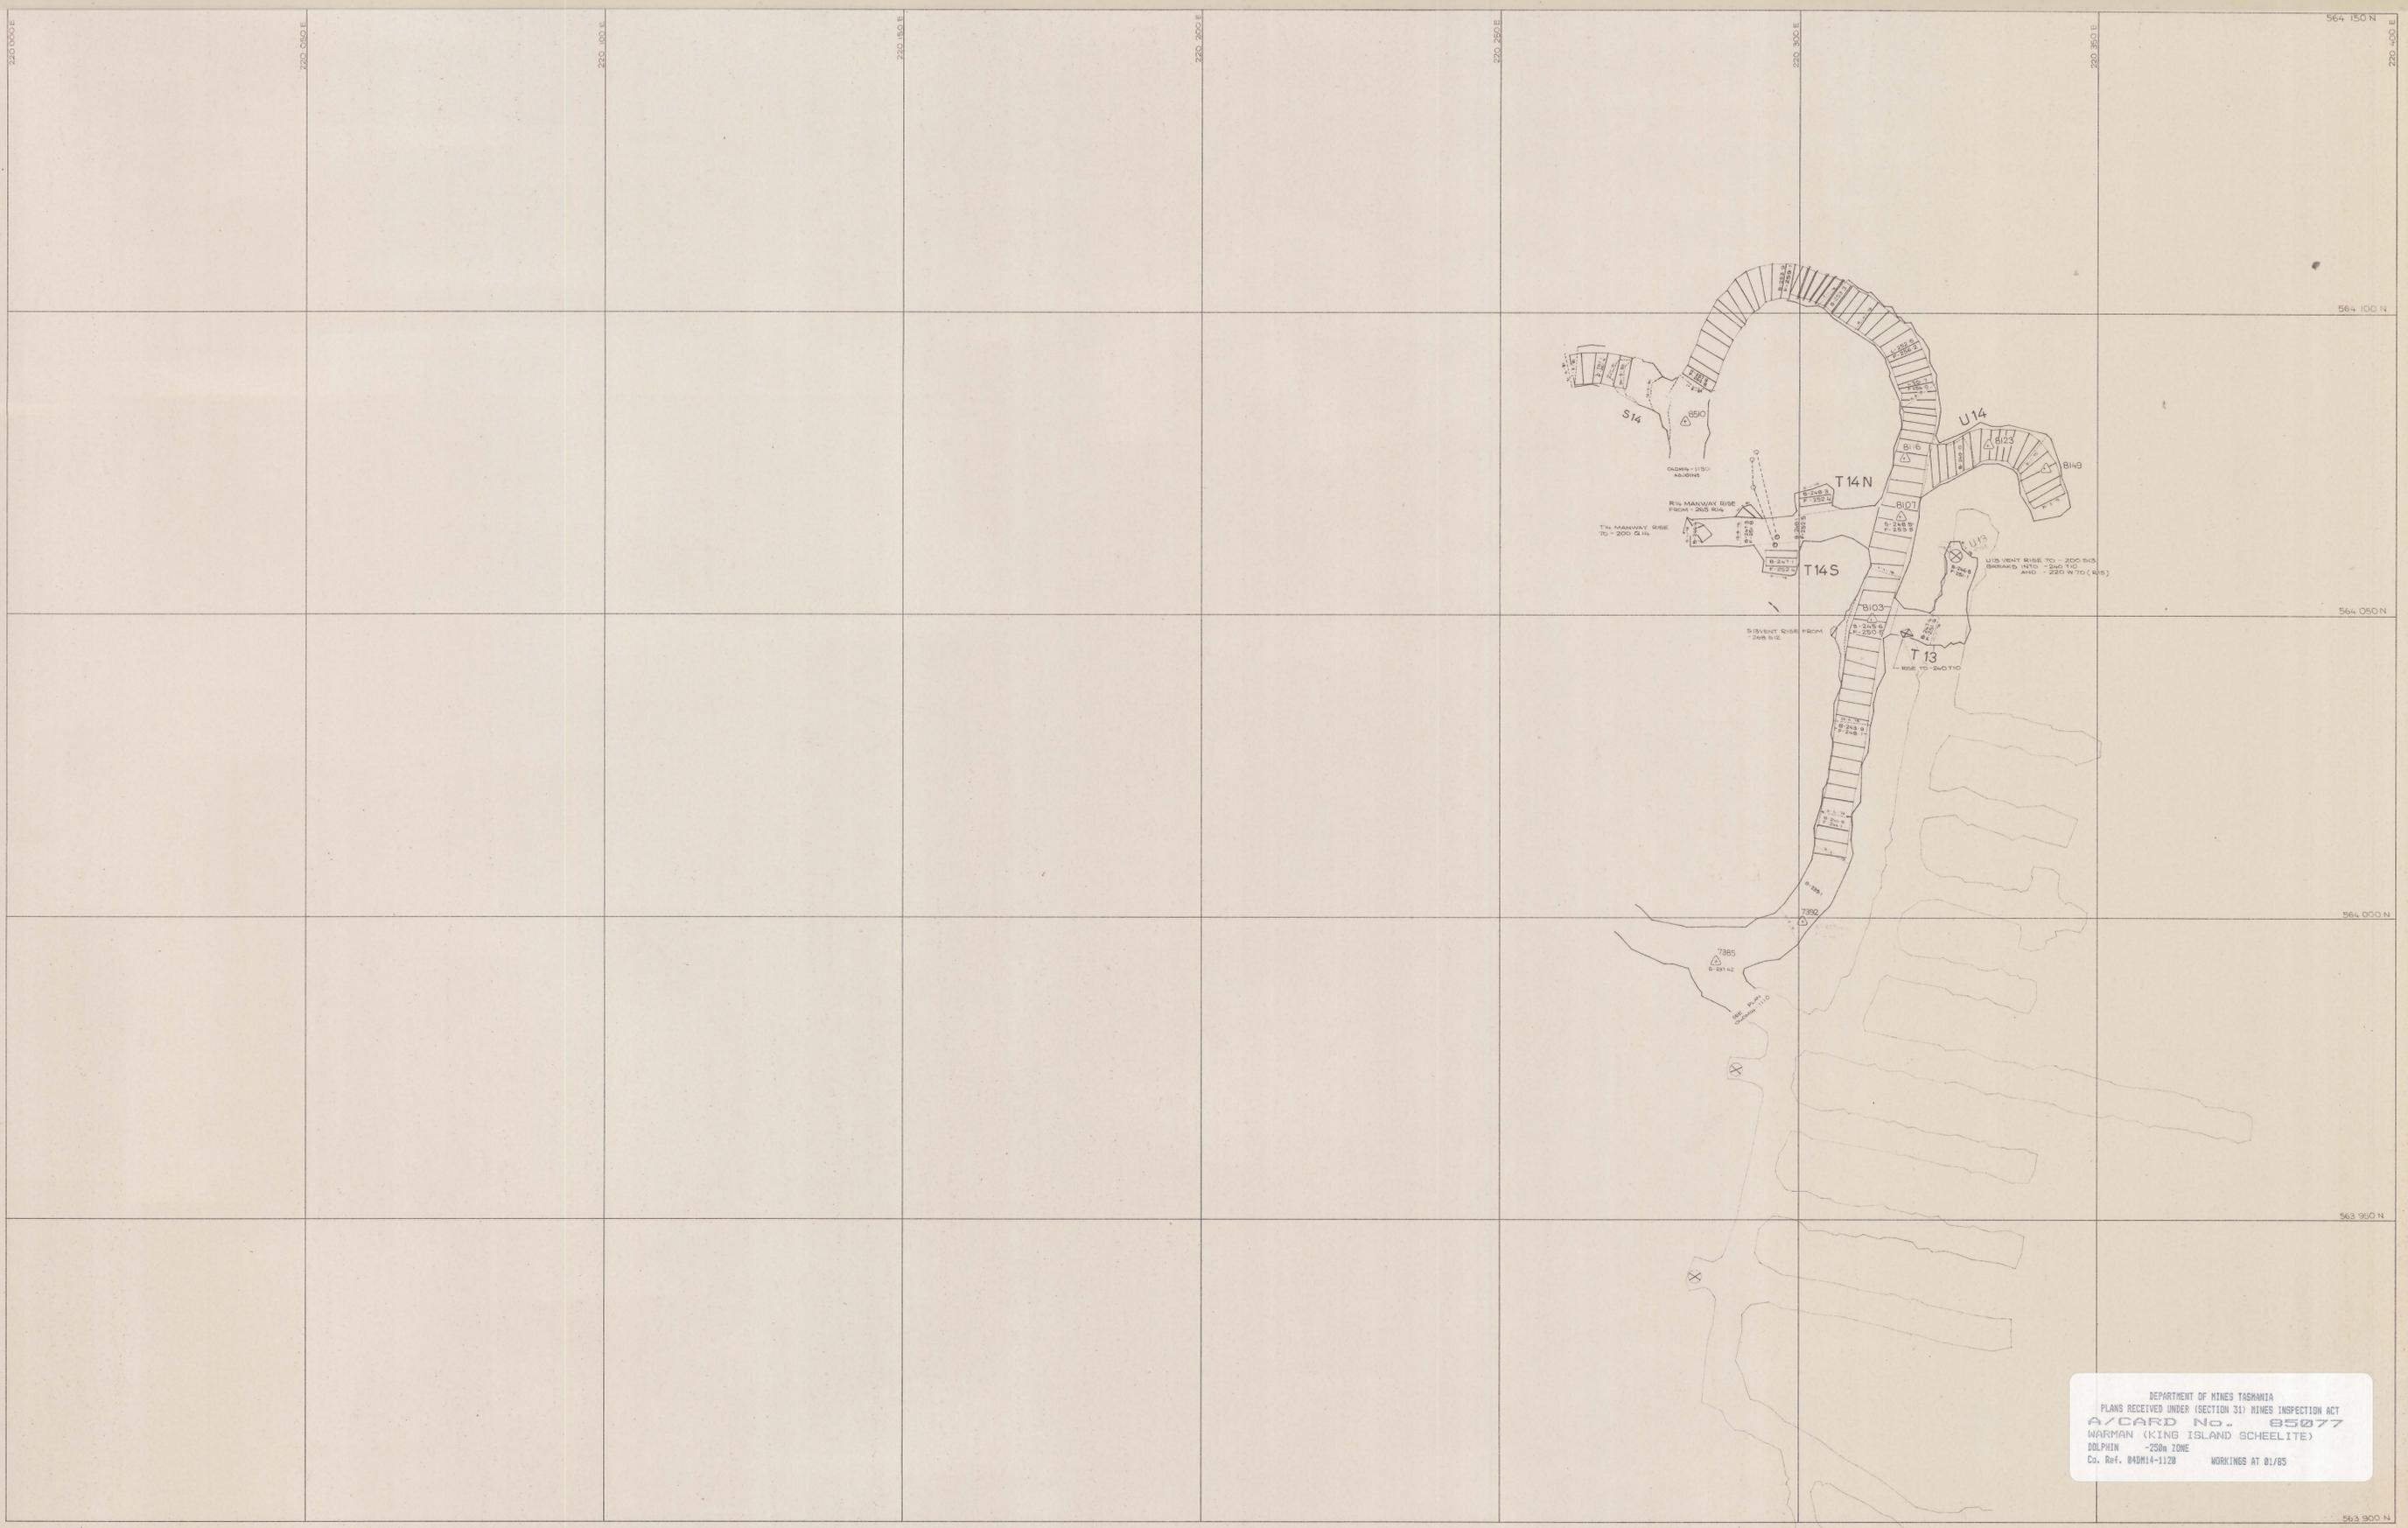

DEPARTMENT OF MINES TASMANIA
 PLANS RECEIVED UNDER (SECTION 31) MINES INSPECTION ACT
 A/CARD No. 85077
 WARMAN (KING ISLAND SCHEELITE)
 DOLPHIN - 250m ZONE
 Co. Ref. 04DM14-1120 WORKINGS AT 01/85

SCALE 1:500



north

LOCATION DOLPHIN MINE
 SUBJECT -250m ZONE

KIS KING ISLAND SCHEELITE
 A DIVISION OF WARMAN INTERNATIONAL
 GRASSY KING ISLAND
 PLAN NUMBER 04DM14 - 1120