


0374_1014

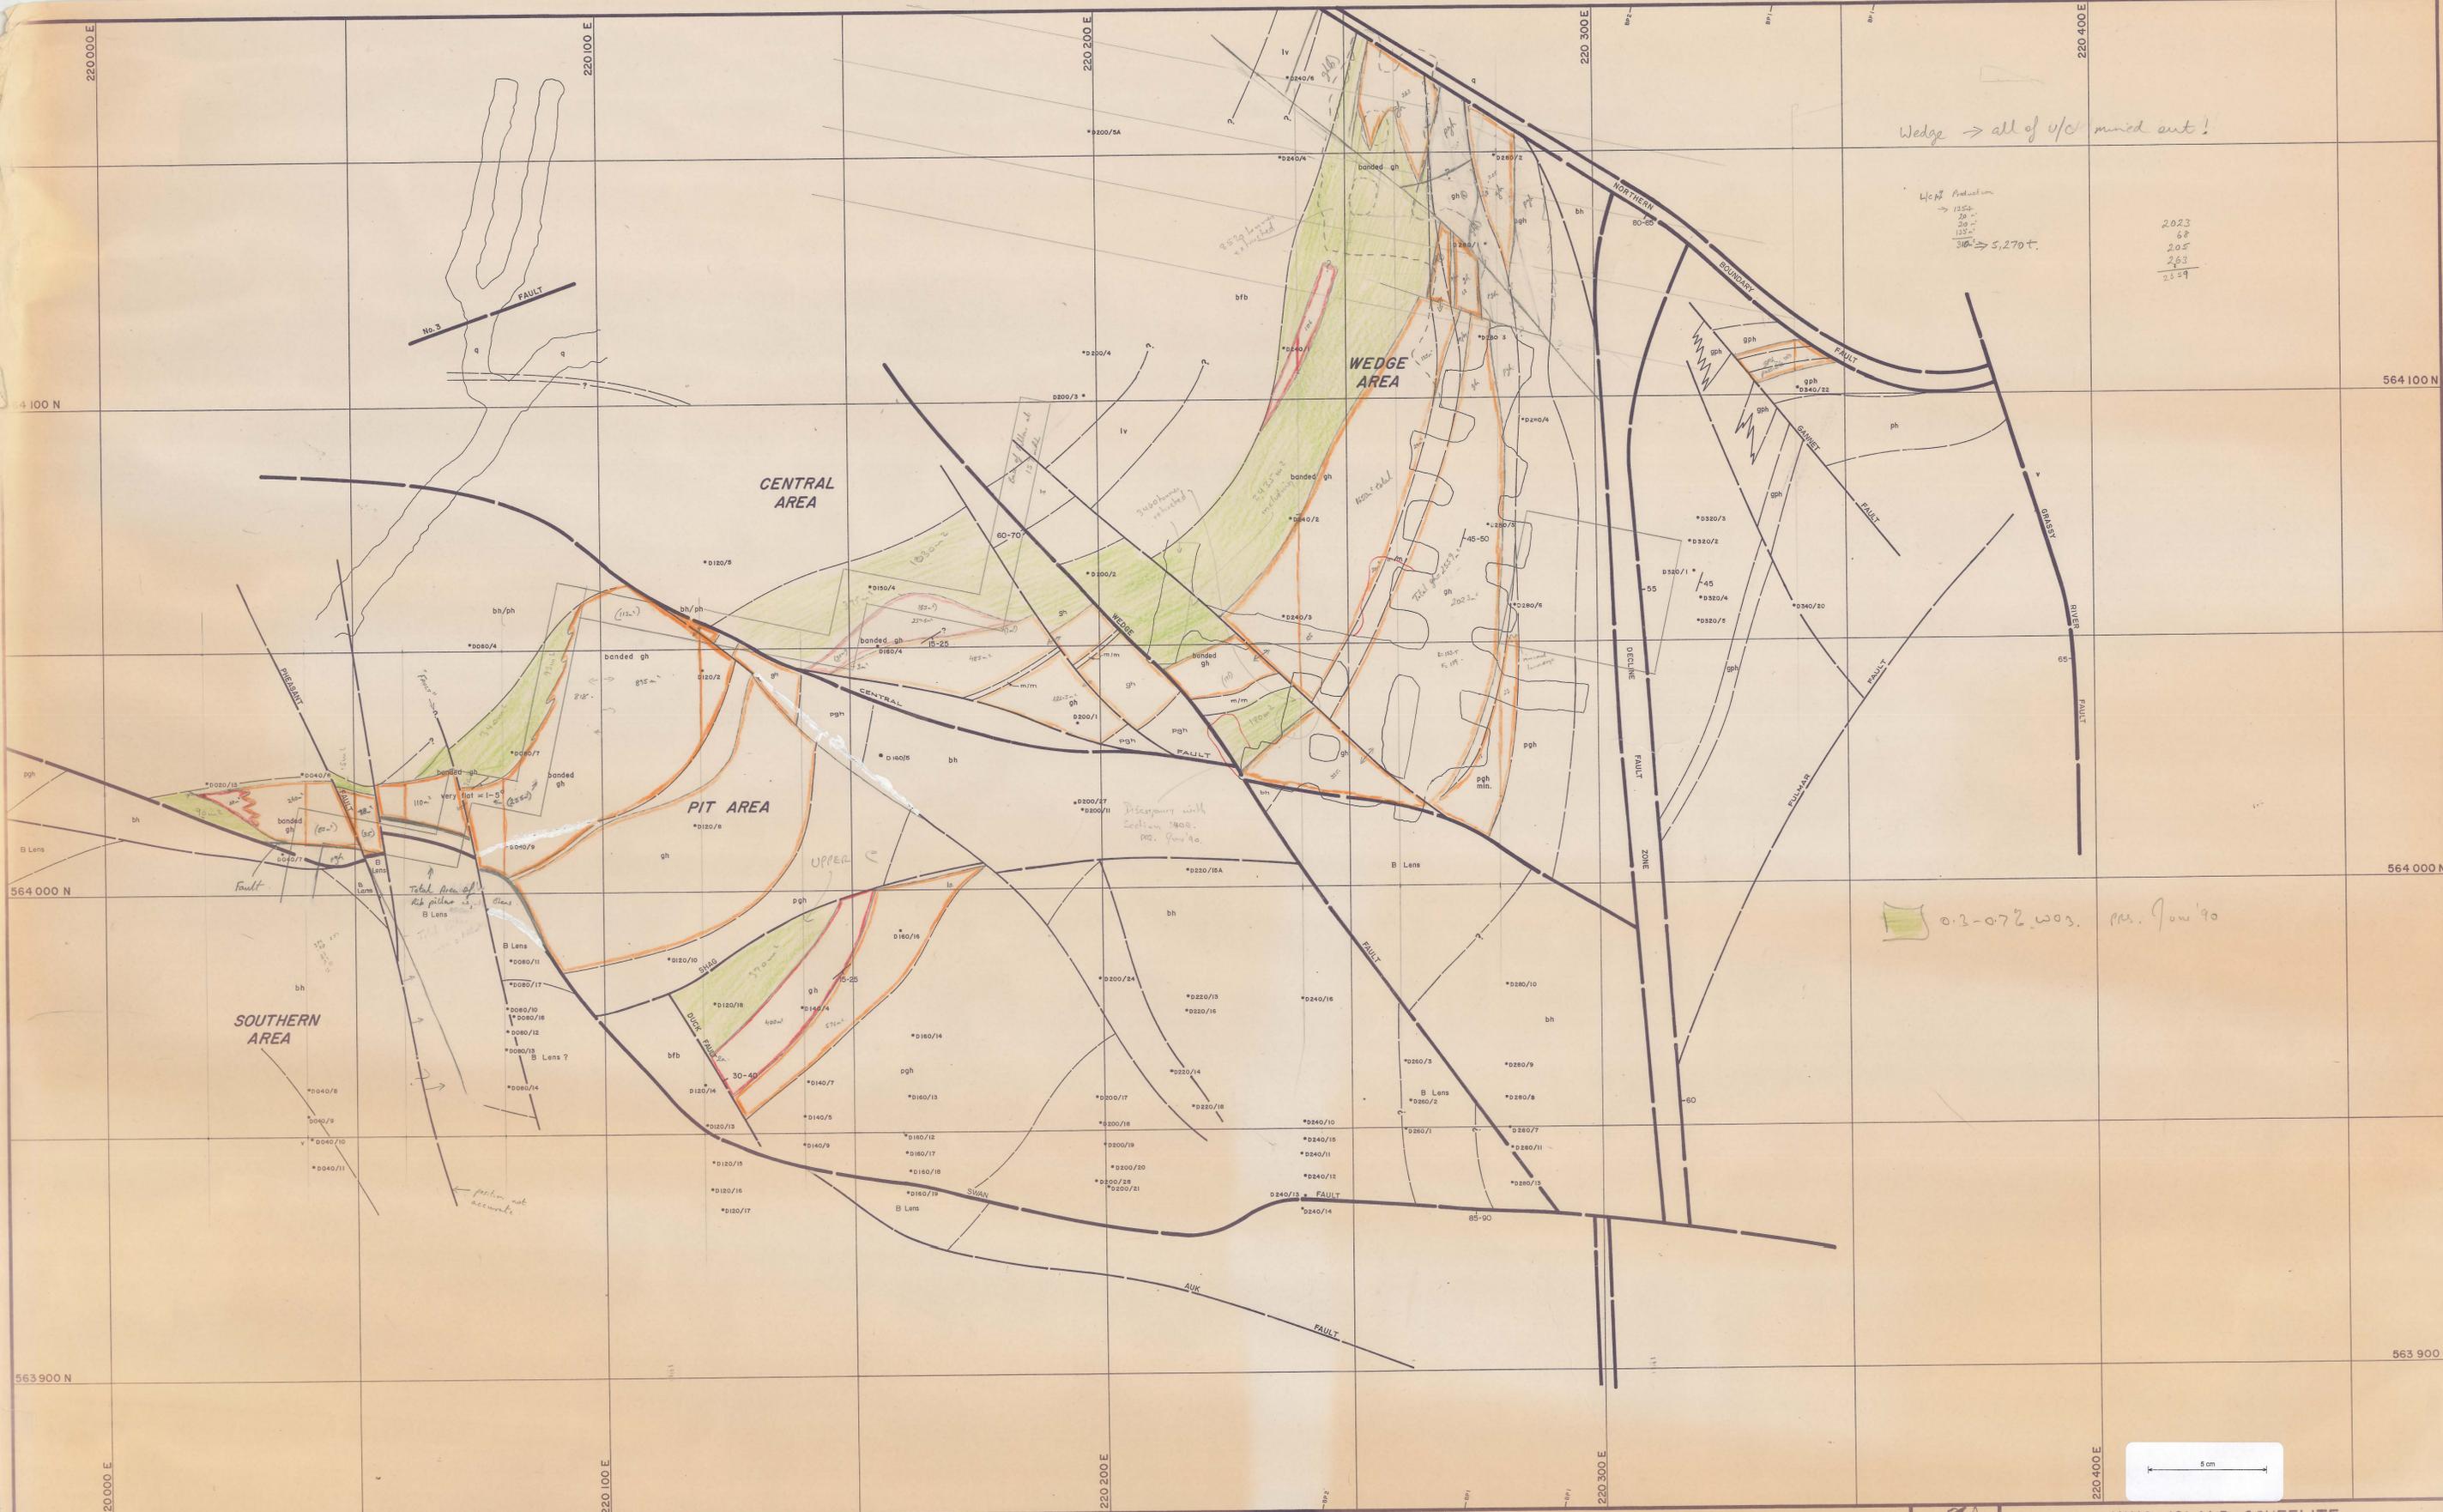

Wedge -> all of u/c mined out!

Left Production
 135t
 20t
 133t
 300t -> 5,270t

2023
68
205
283
2339

0.2-0.72 w.o.s. m.s. June 90

LEGEND:

Upper metavolcanics	Banded footwall beds	Strike and dip
Banded hornfels	Biotite pyroxene hornfels	Joint, inclined
Marble	Lower metavolcanics	Joint, vertical
Biotite hornfels	Quartzite	Fault
Pyroxene hornfels	Aplite	Roadway R.L. -127.3m
Hornfels	Adamellite	

DATE: 10th JUN 1989
 GEOLOGIST: S.O.S.
 DRAWN: [Signature]
 CHECKED: [Signature]

KING ISLAND SCHEELITE
 No. KG2-06-160 E
 SCALE: 1:500
 10 JUN 1989
 DOLPHIN MINE
 GEOLOGICAL LEVEL PLAN
 - 160m R.L.

0374_1014