



0374-102

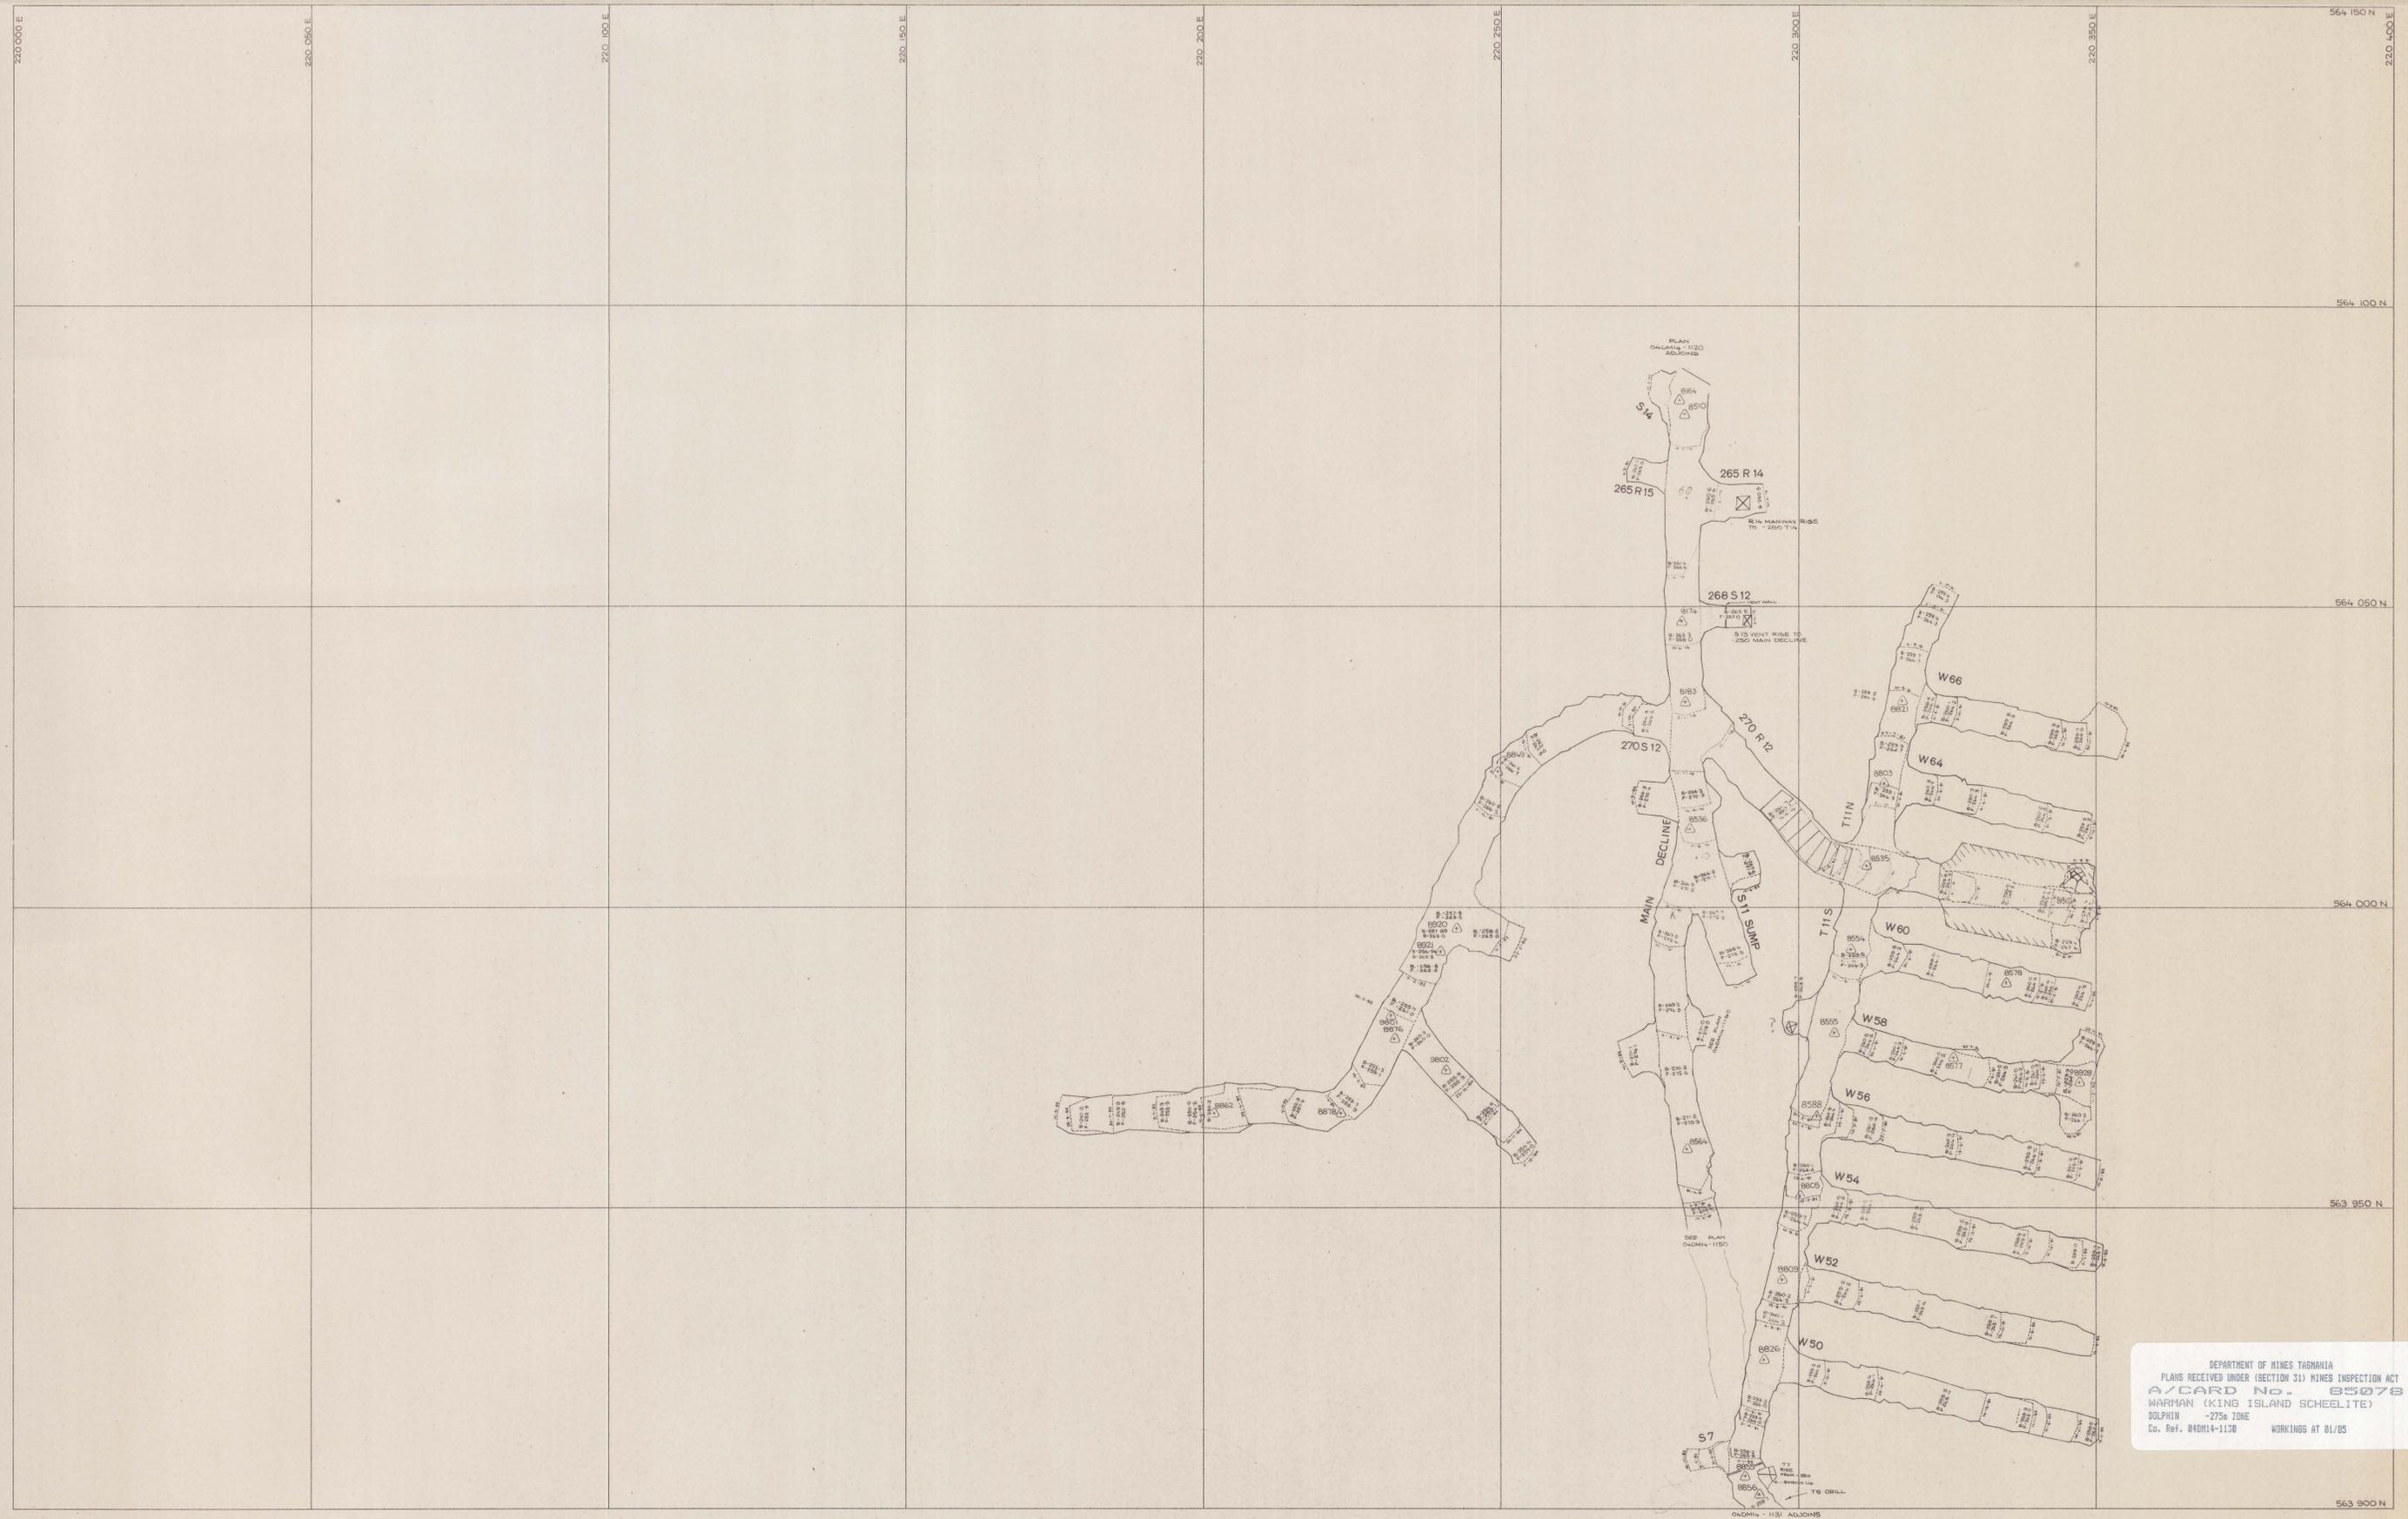

DEPARTMENT OF MINES TASMANIA
 PLANS RECEIVED UNDER (SECTION 31) MINES INSPECTION ACT
 A/CARD No. 85078
 WARMAN (KING ISLAND SCHEELITE)
 DOLPHIN -275m ZONE
 Co. Ref. 04DM14-1130 WORKINGS AT 01/05

SCALE 1:500

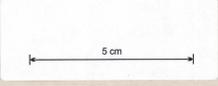

LOCATION DOLPHIN MINE

SUBJECT -275 m ZONE

north

KIS KING ISLAND SCHEELITE
 A DIVISION OF WARMAN INTERNATIONAL

GRASSY KING ISLAND

PLAN NUMBER 04DM14 - 1130