


0374_1029

UPPER PIT

13th Lift

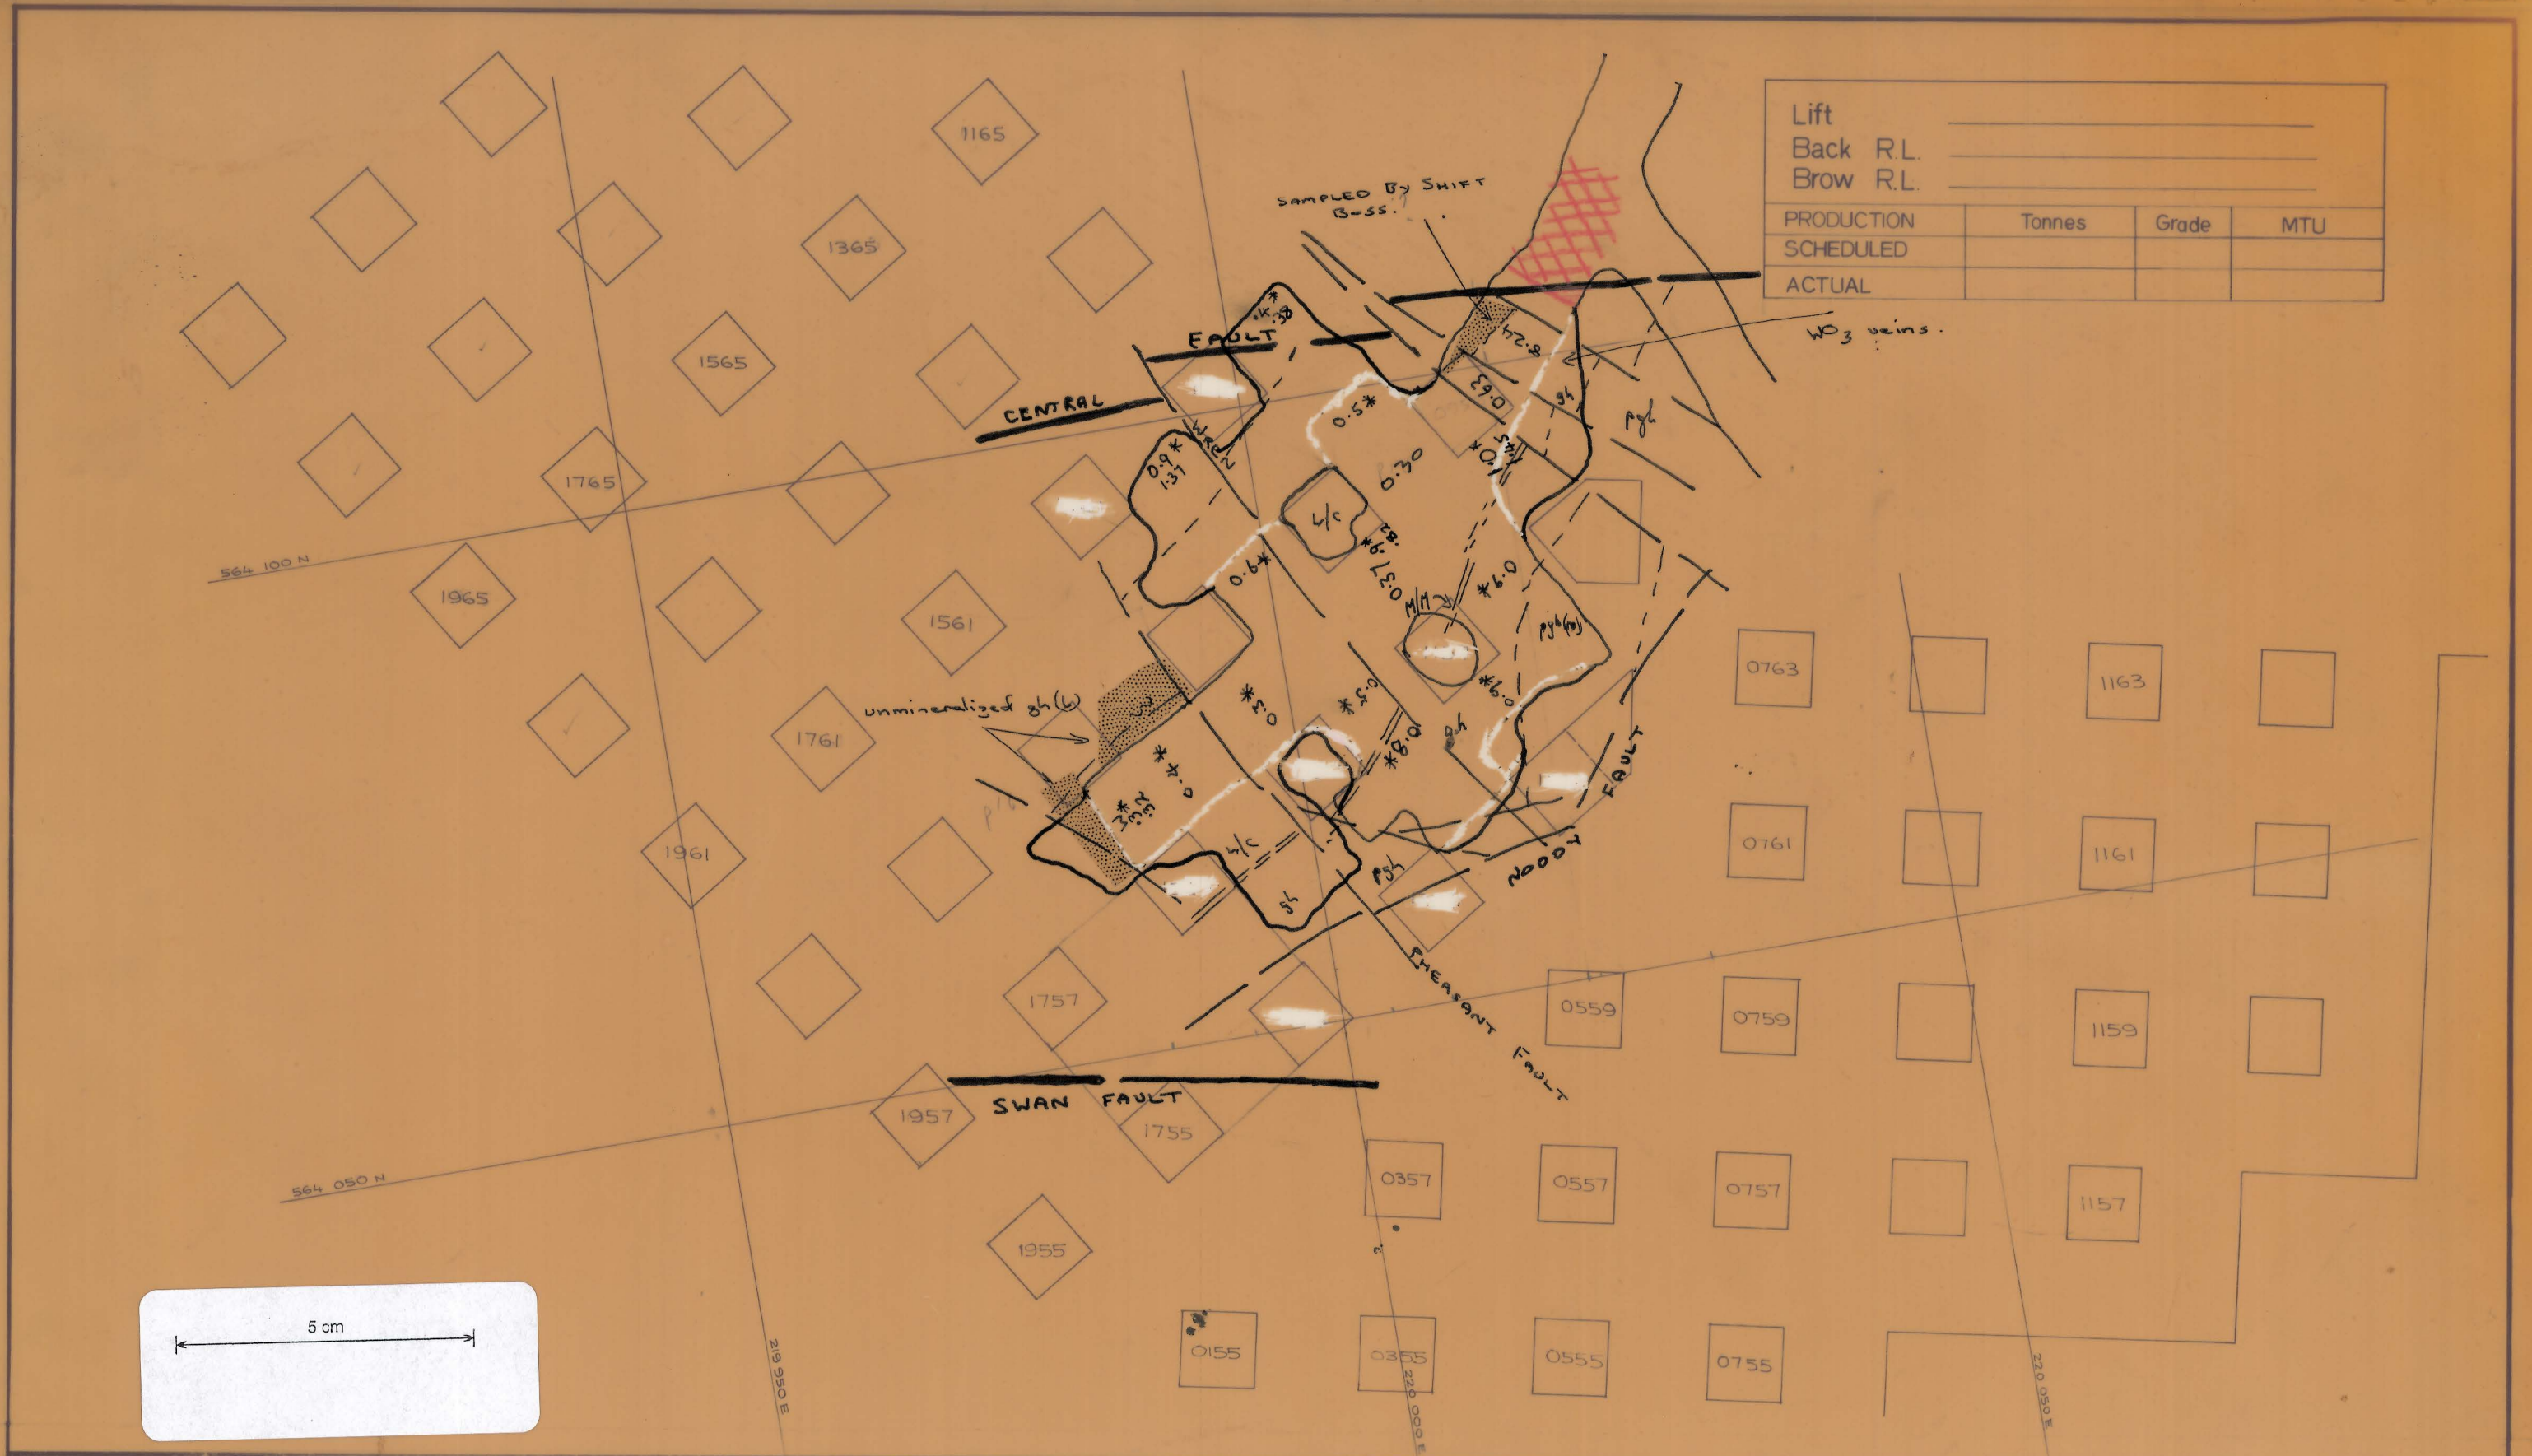

Lift			
Back R.L.			
Brow R.L.			
PRODUCTION	Tonnes	Grade	MTU
SCHEDULED			
ACTUAL			

SCALE 1:500

0374_1029



north

LOCATION

DOLPHIN MINE

SUBJECT

PIT STOPE 13th LIFT

PERIOD

197 /7

KIS KING ISLAND SCHEELITE
A DIVISION OF WARMAN INTERNATIONAL

GRASSY

KING ISLAND

PLAN NUMBER

06DMO4-3001