


0374_1031

C Pit
LIFT 11
-116m - 113m

0374_1031

Lift	_____		
Back R.L.	_____		
Brow R.L.	_____		
PRODUCTION	Tonnes	Grade	MTU
SCHEDULED			
ACTUAL			

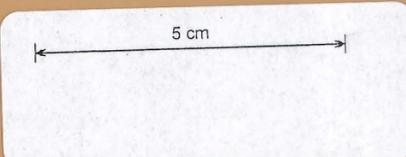

SCALE 1:500

LOCATION DOLPHIN MINE
 SUBJECT PIT STOPE 11 LIFT
 PERIOD 9
 1979/78



- * Lamp Estimate
- Mining Limit
- Waste Mined Discarded
- Waste Mined

KIS KING ISLAND SCHEELITE
 A DIVISION OF KARMAN INTERNATIONAL
 GRASSY KING ISLAND
 PLAN NUMBER 06DMO4-2001