


0374_1034

C-PIT
GRAB SAMPLES

7TH LIFT
-128 + 0 -125 m RL

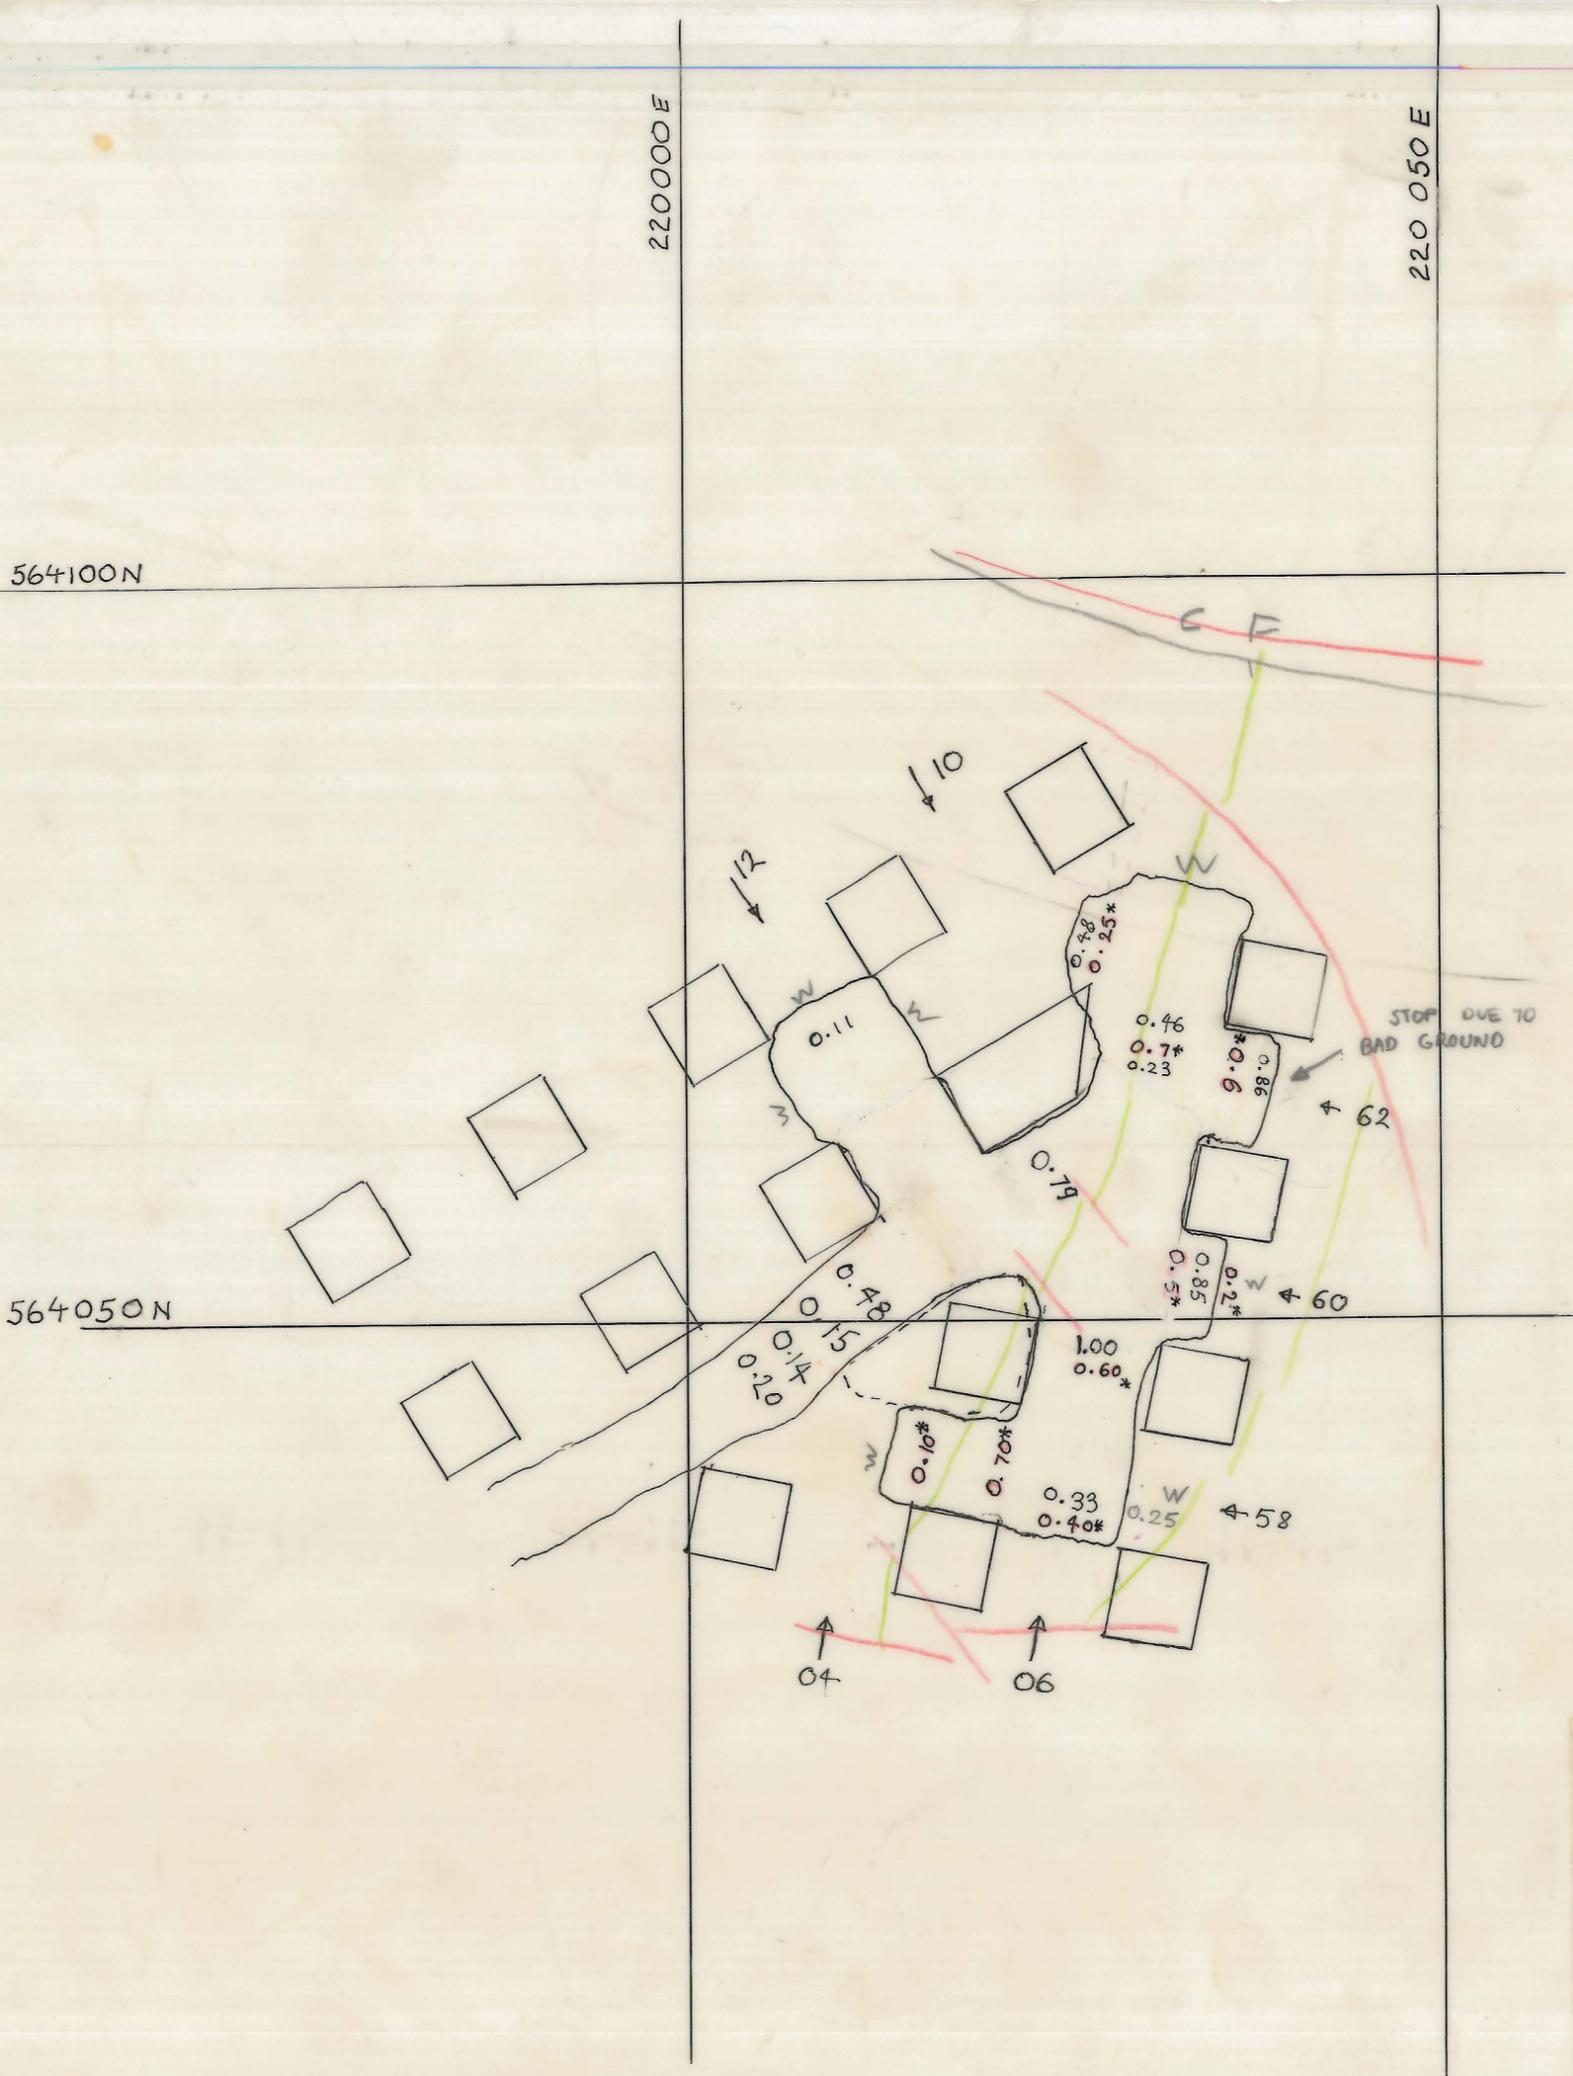

0374_1034

5 cm

* LAMP VALUE

KING ISLAND SCHEELITE

| | |
|--|----------|
| DATE: | SCALE: |
| MINE: DOLPHIN | DWG/NO.: |
| GRAB SAMPLES C-PIT | |
| 7 TH LIFT -128 to -125 m R.L. | |
| GRAB SAMPLES FROM APPROX =126 m RL | |
| PRELIMINARY | FINAL |