


0374\_1035

C-PIT  
6<sup>TH</sup> LIFT

GRAB SAMPLES  
-131 to -128 m RL

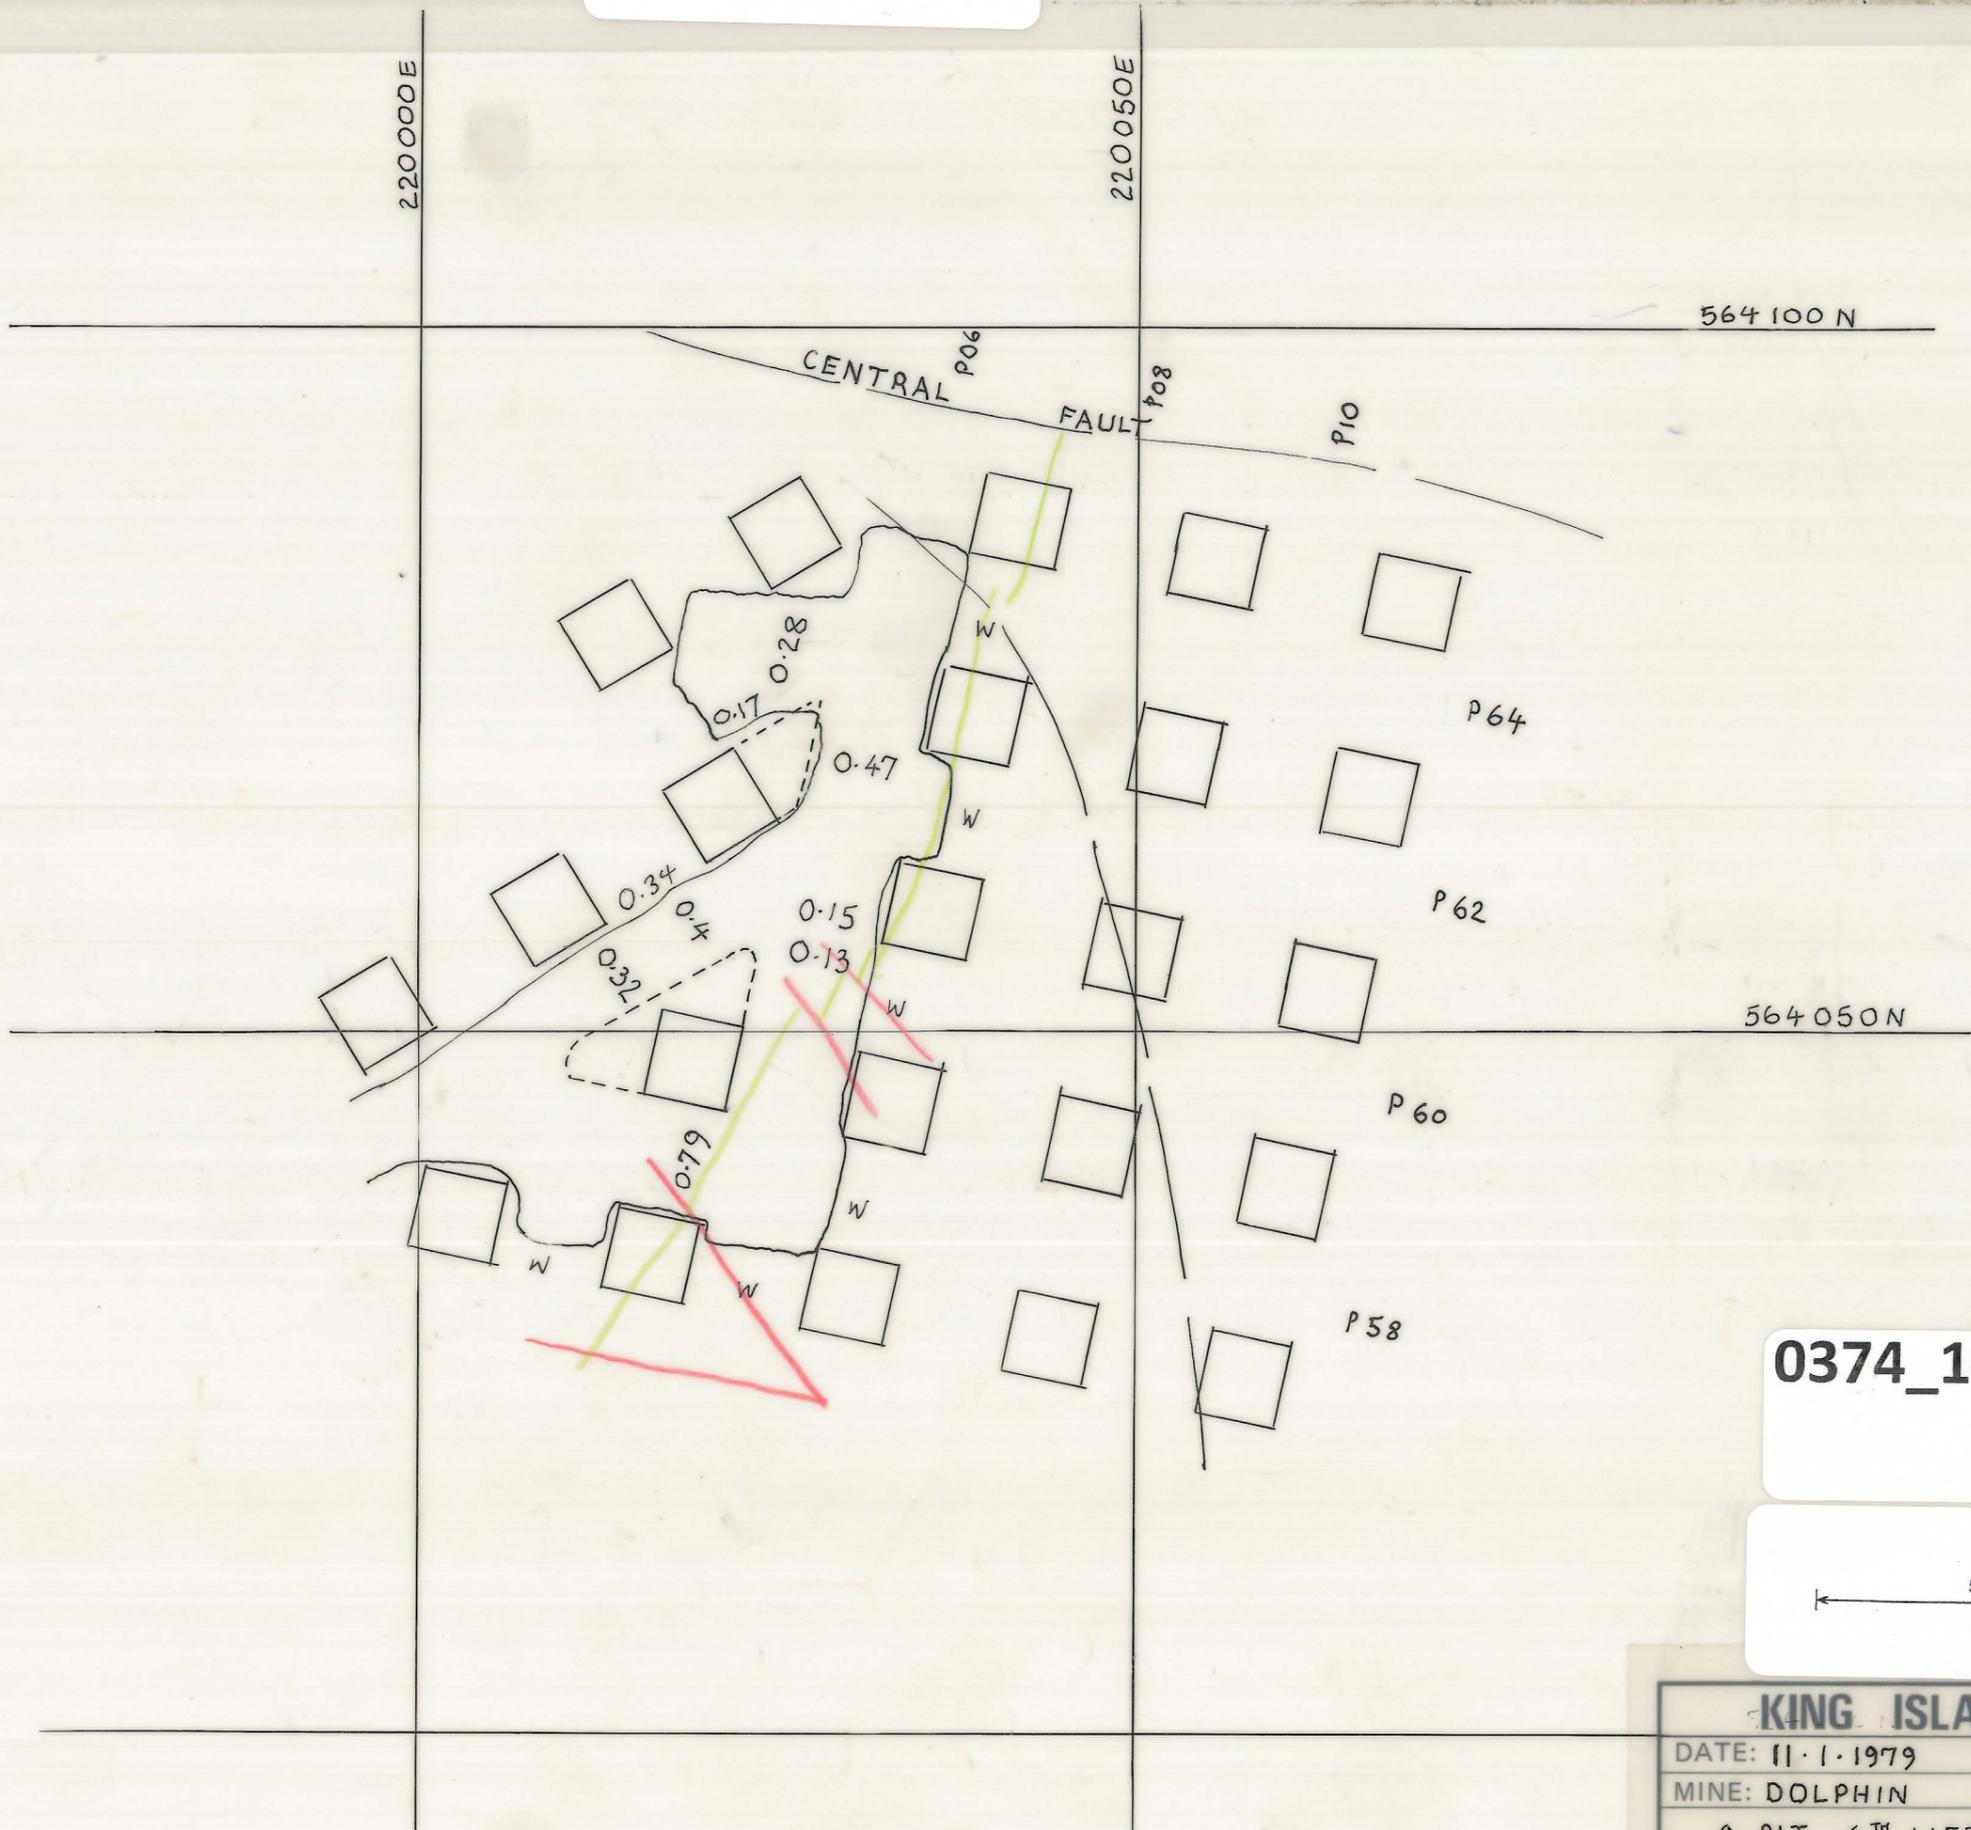

0374\_1035

5 cm

<b>KING ISLAND SCHEELITE</b>	
DATE: 11.1.1979	SCALE: 1:500
MINE: DOLPHIN	DWG/NO.:
C-PIT 6 <sup>TH</sup> LIFT	
-131 To -128 m R.L.	
GRAB SAMPLES FROM -129 m R.L. (APPROX)	
PRELIMINARY	FINAL