
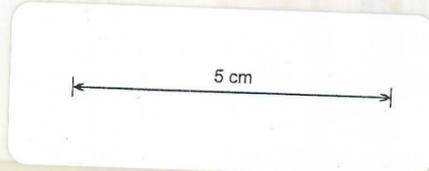


0374_1036

C-PIT
5TH LIFT -134 to -131

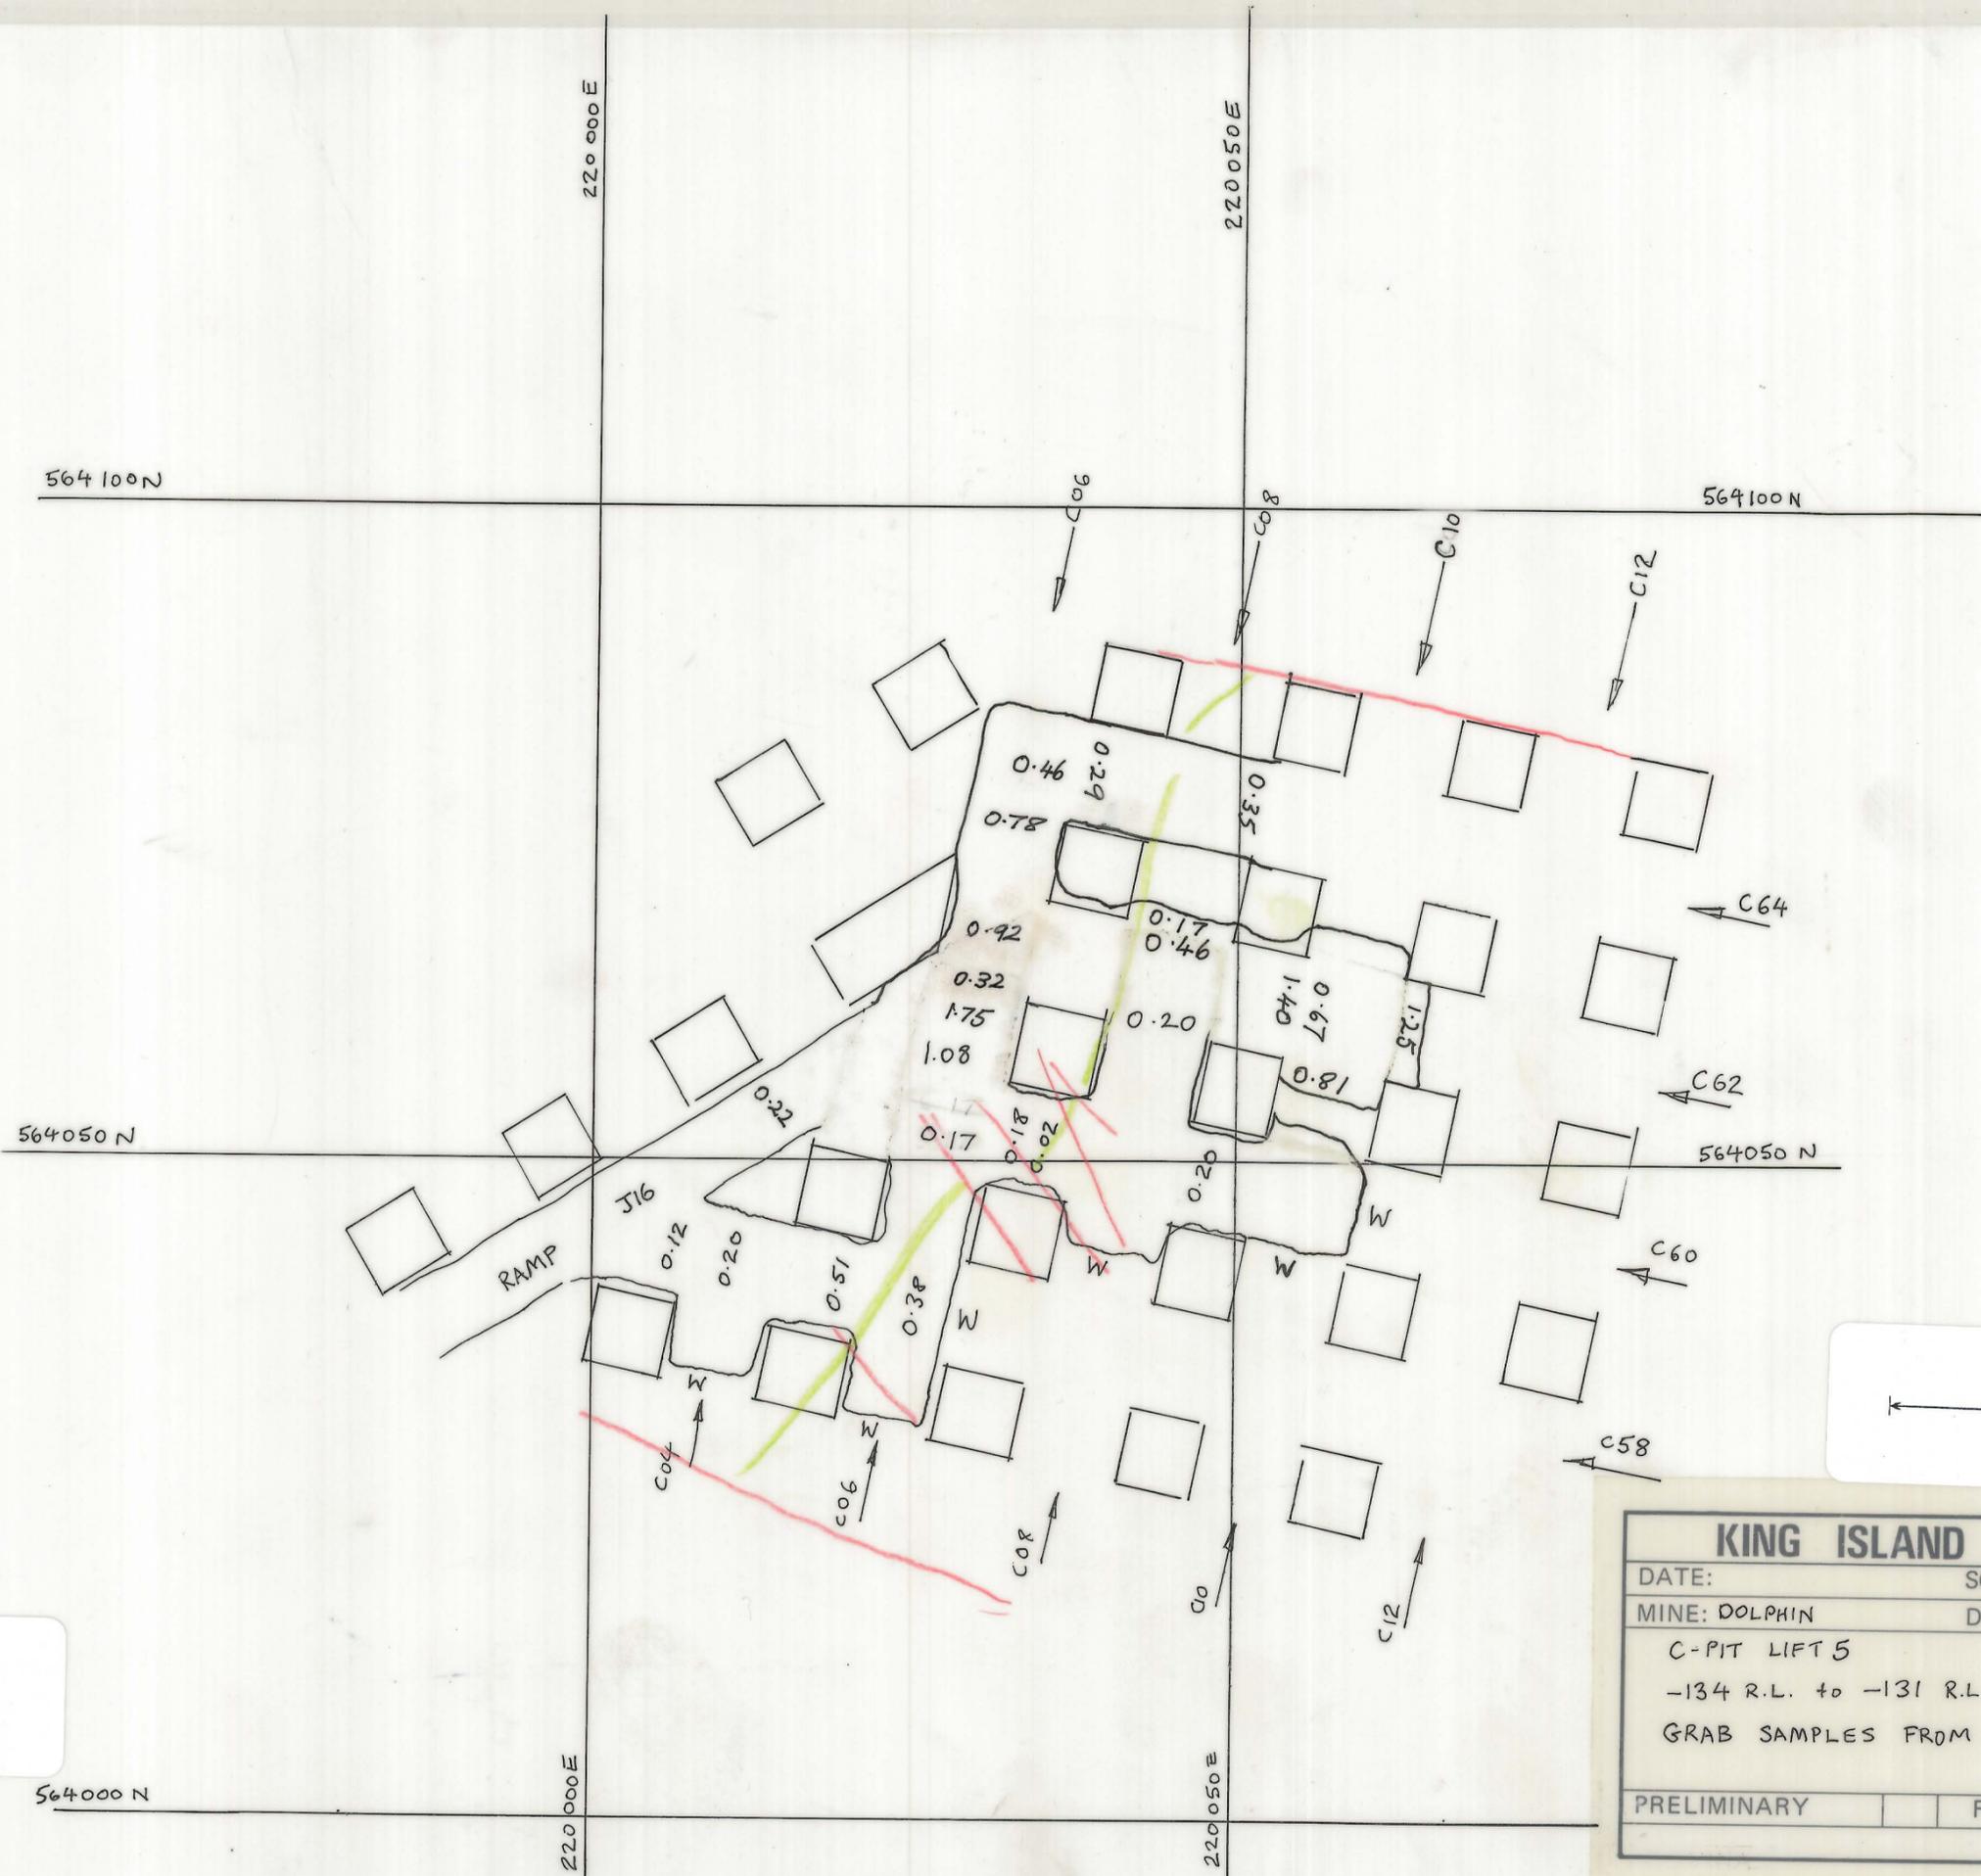

0374_1036

KING ISLAND SCHEELITE	
DATE:	SCALE: 1:500
MINE: DOLPHIN	DWG/NO.:
C-PIT LIFT 5 -134 R.L. to -131 R.L. GRAB SAMPLES FROM -132 RL (APPROX)	
PRELIMINARY	FINAL