


0374_1045

010
LOWER PIT
LIFT 8

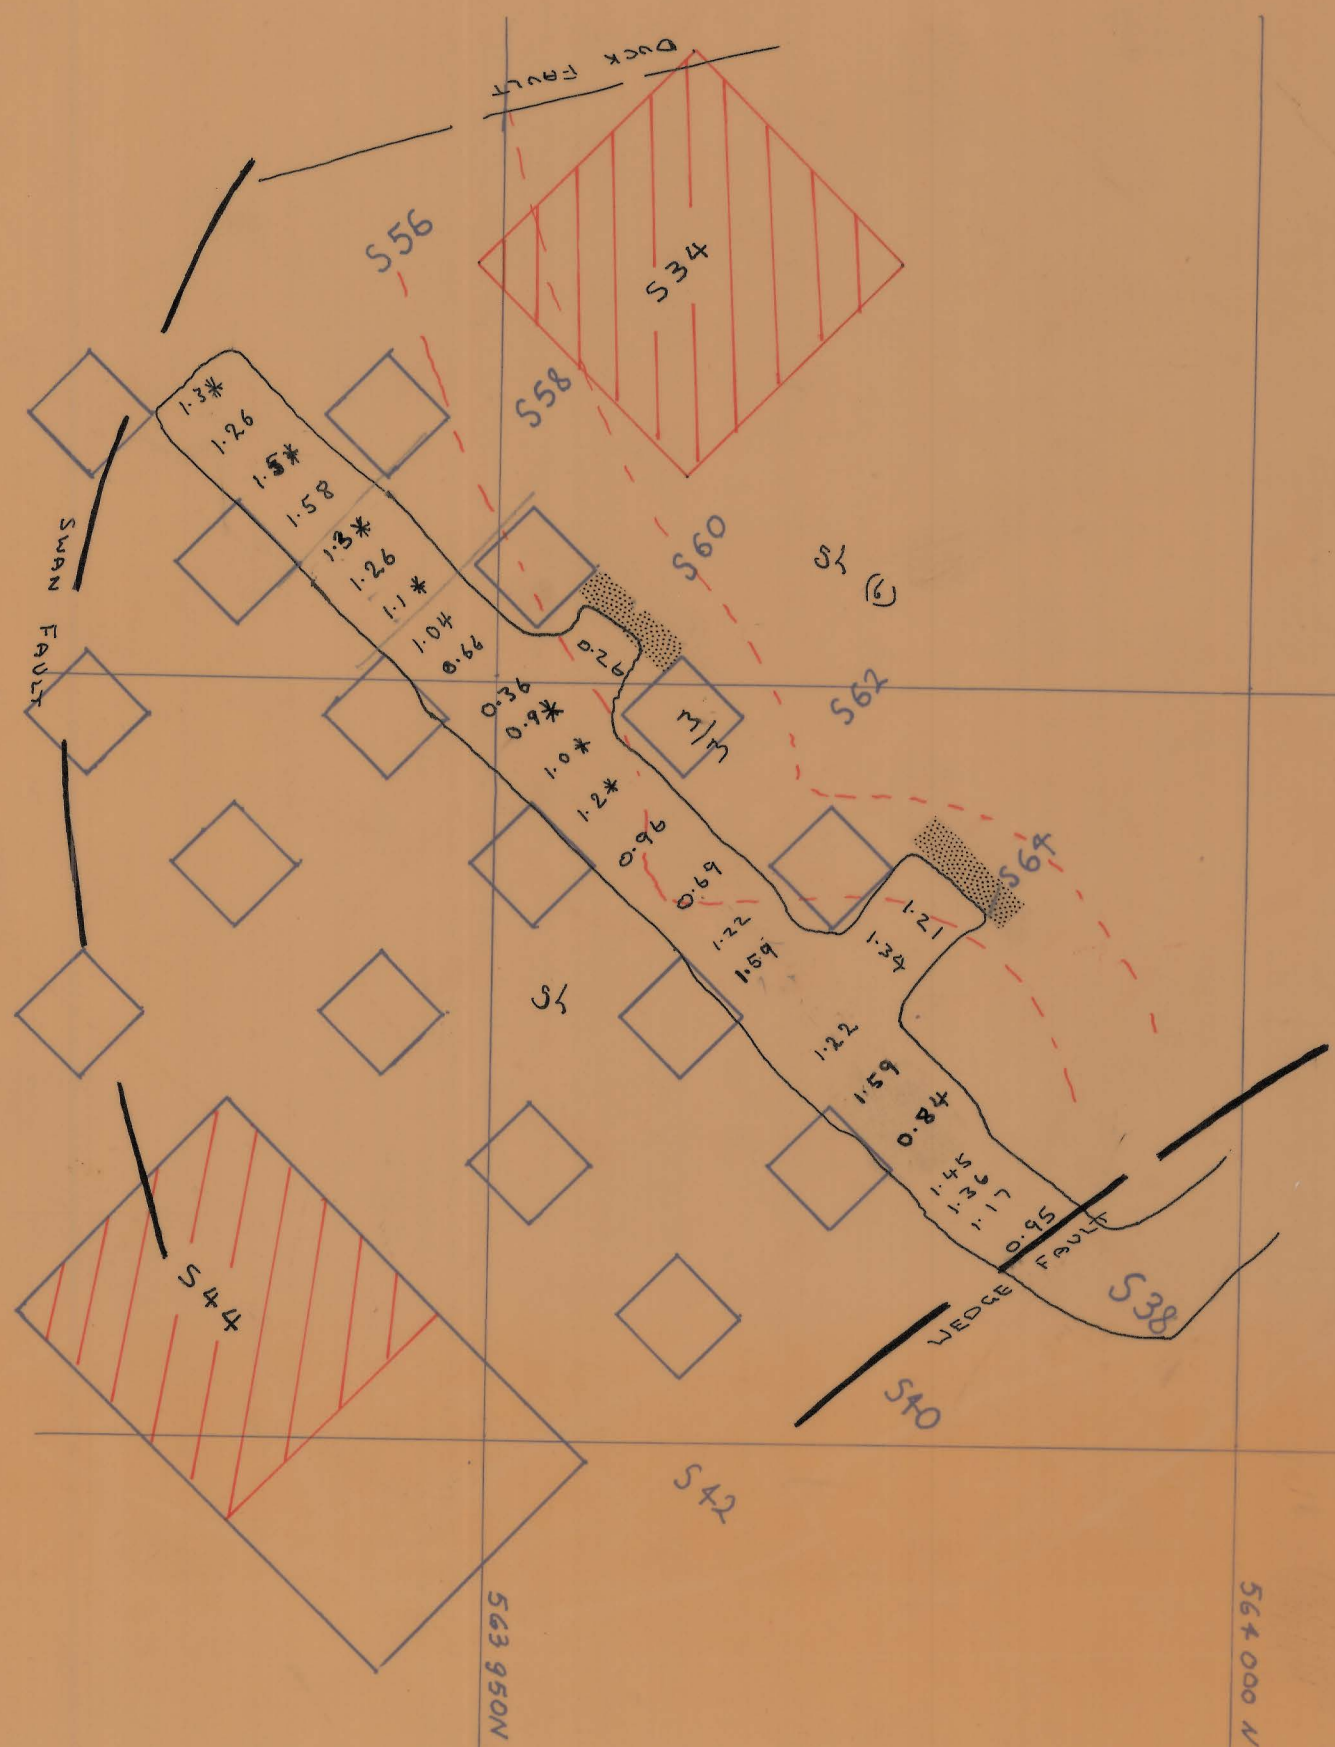

0374_1045

KIS KING ISLAND SCHEELITE
A DIVISION OF WARMAN TECHNOLOGY

GRASSY DOLPHIN LOWER PIT KING ISLAND

PLAN NUMBER

LIFT No.