
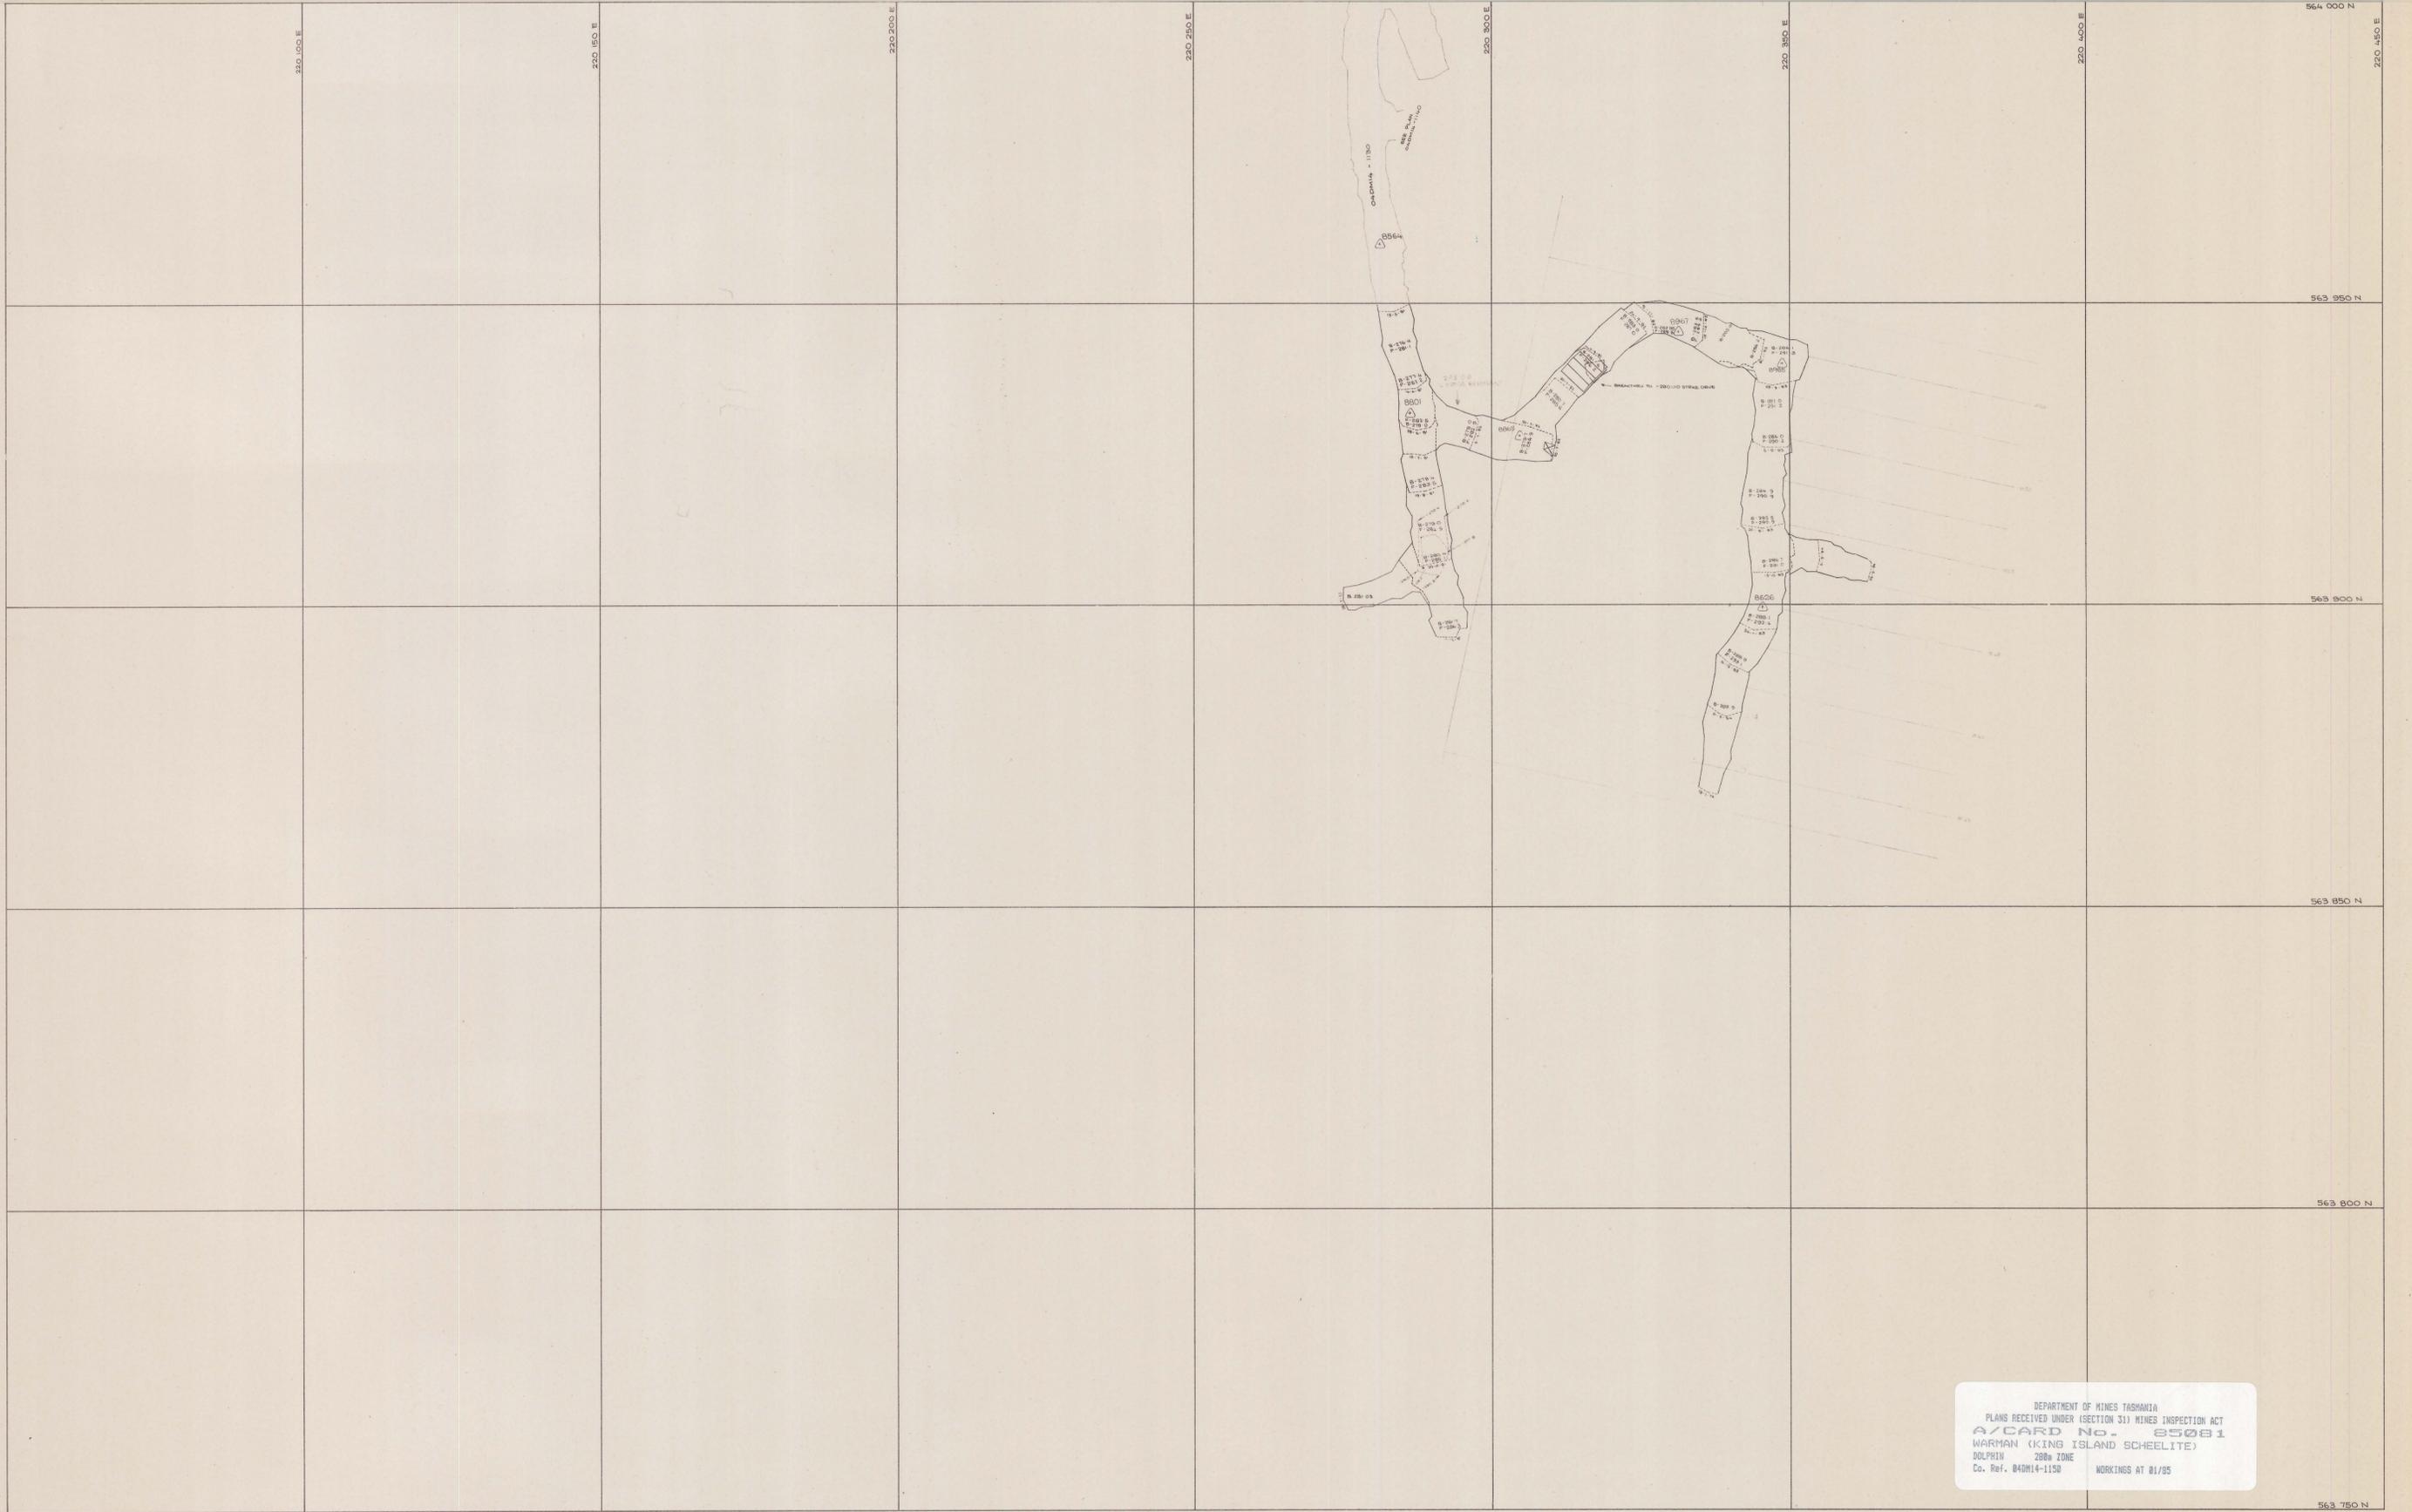
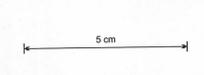


104-105

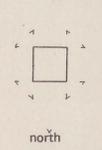

DEPARTMENT OF MINES TASMANIA
 PLANS RECEIVED UNDER (SECTION 31) MINES INSPECTION ACT
 A/CARD No. 85081
 WARMAN (KING ISLAND SCHEELITE)
 DOLPHIN 280m ZONE
 Co. Ref. 04DM14-1150 WORKINGS AT 01/05

SCALE 1: 500 	 north	LOCATION DOLPHIN MINE	 KING ISLAND SCHEELITE A DIVISION OF WARMAN INTERNATIONAL GRASSY KING ISLAND PLAN NUMBER 04DM14 - 1150
		SUBJECT - 280m ZONE	