


0374_1054

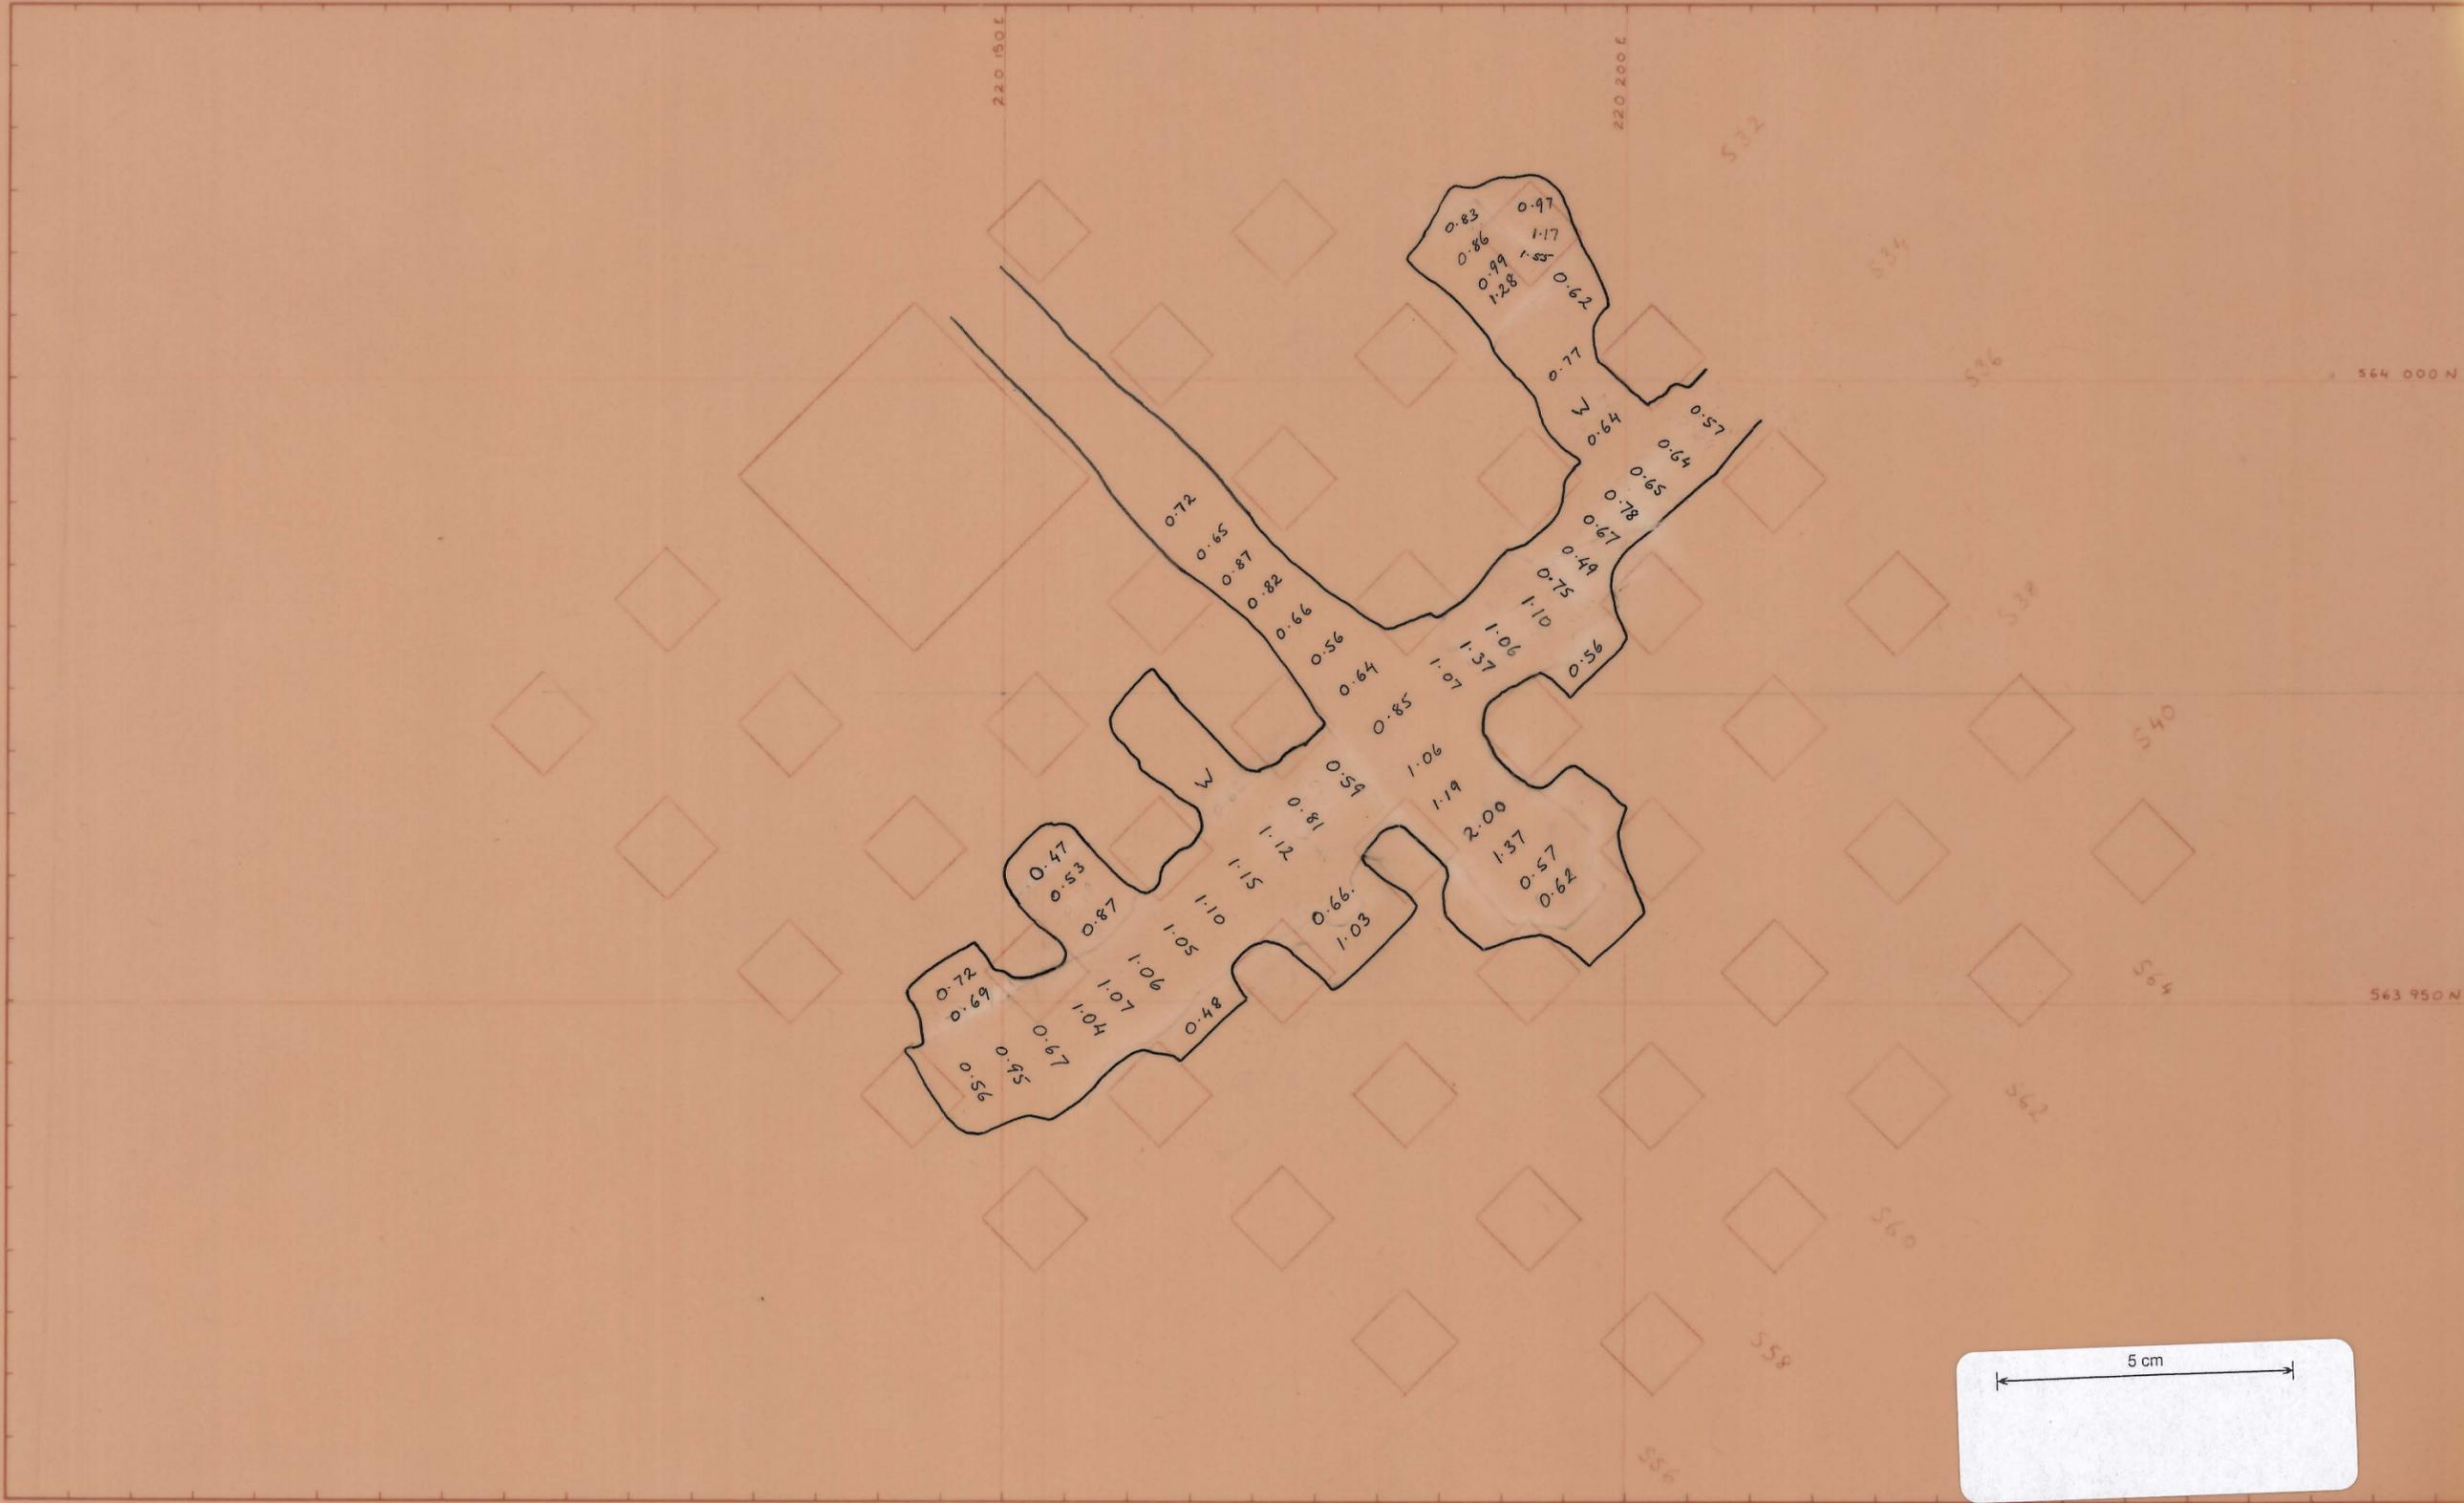

0374_1054

REF PLAN

GEOLOGY

SURVEY

PLANNING

ROCK MEC

GRADE CON

DRAFTING

T.S.S

SCALE 1:500

KIS KING ISLAND SCHEELITE GRASSY KING ISLAND

LOWER PIT STOPE

LIFT 14

DRAWING NUMBER