


0374_1055

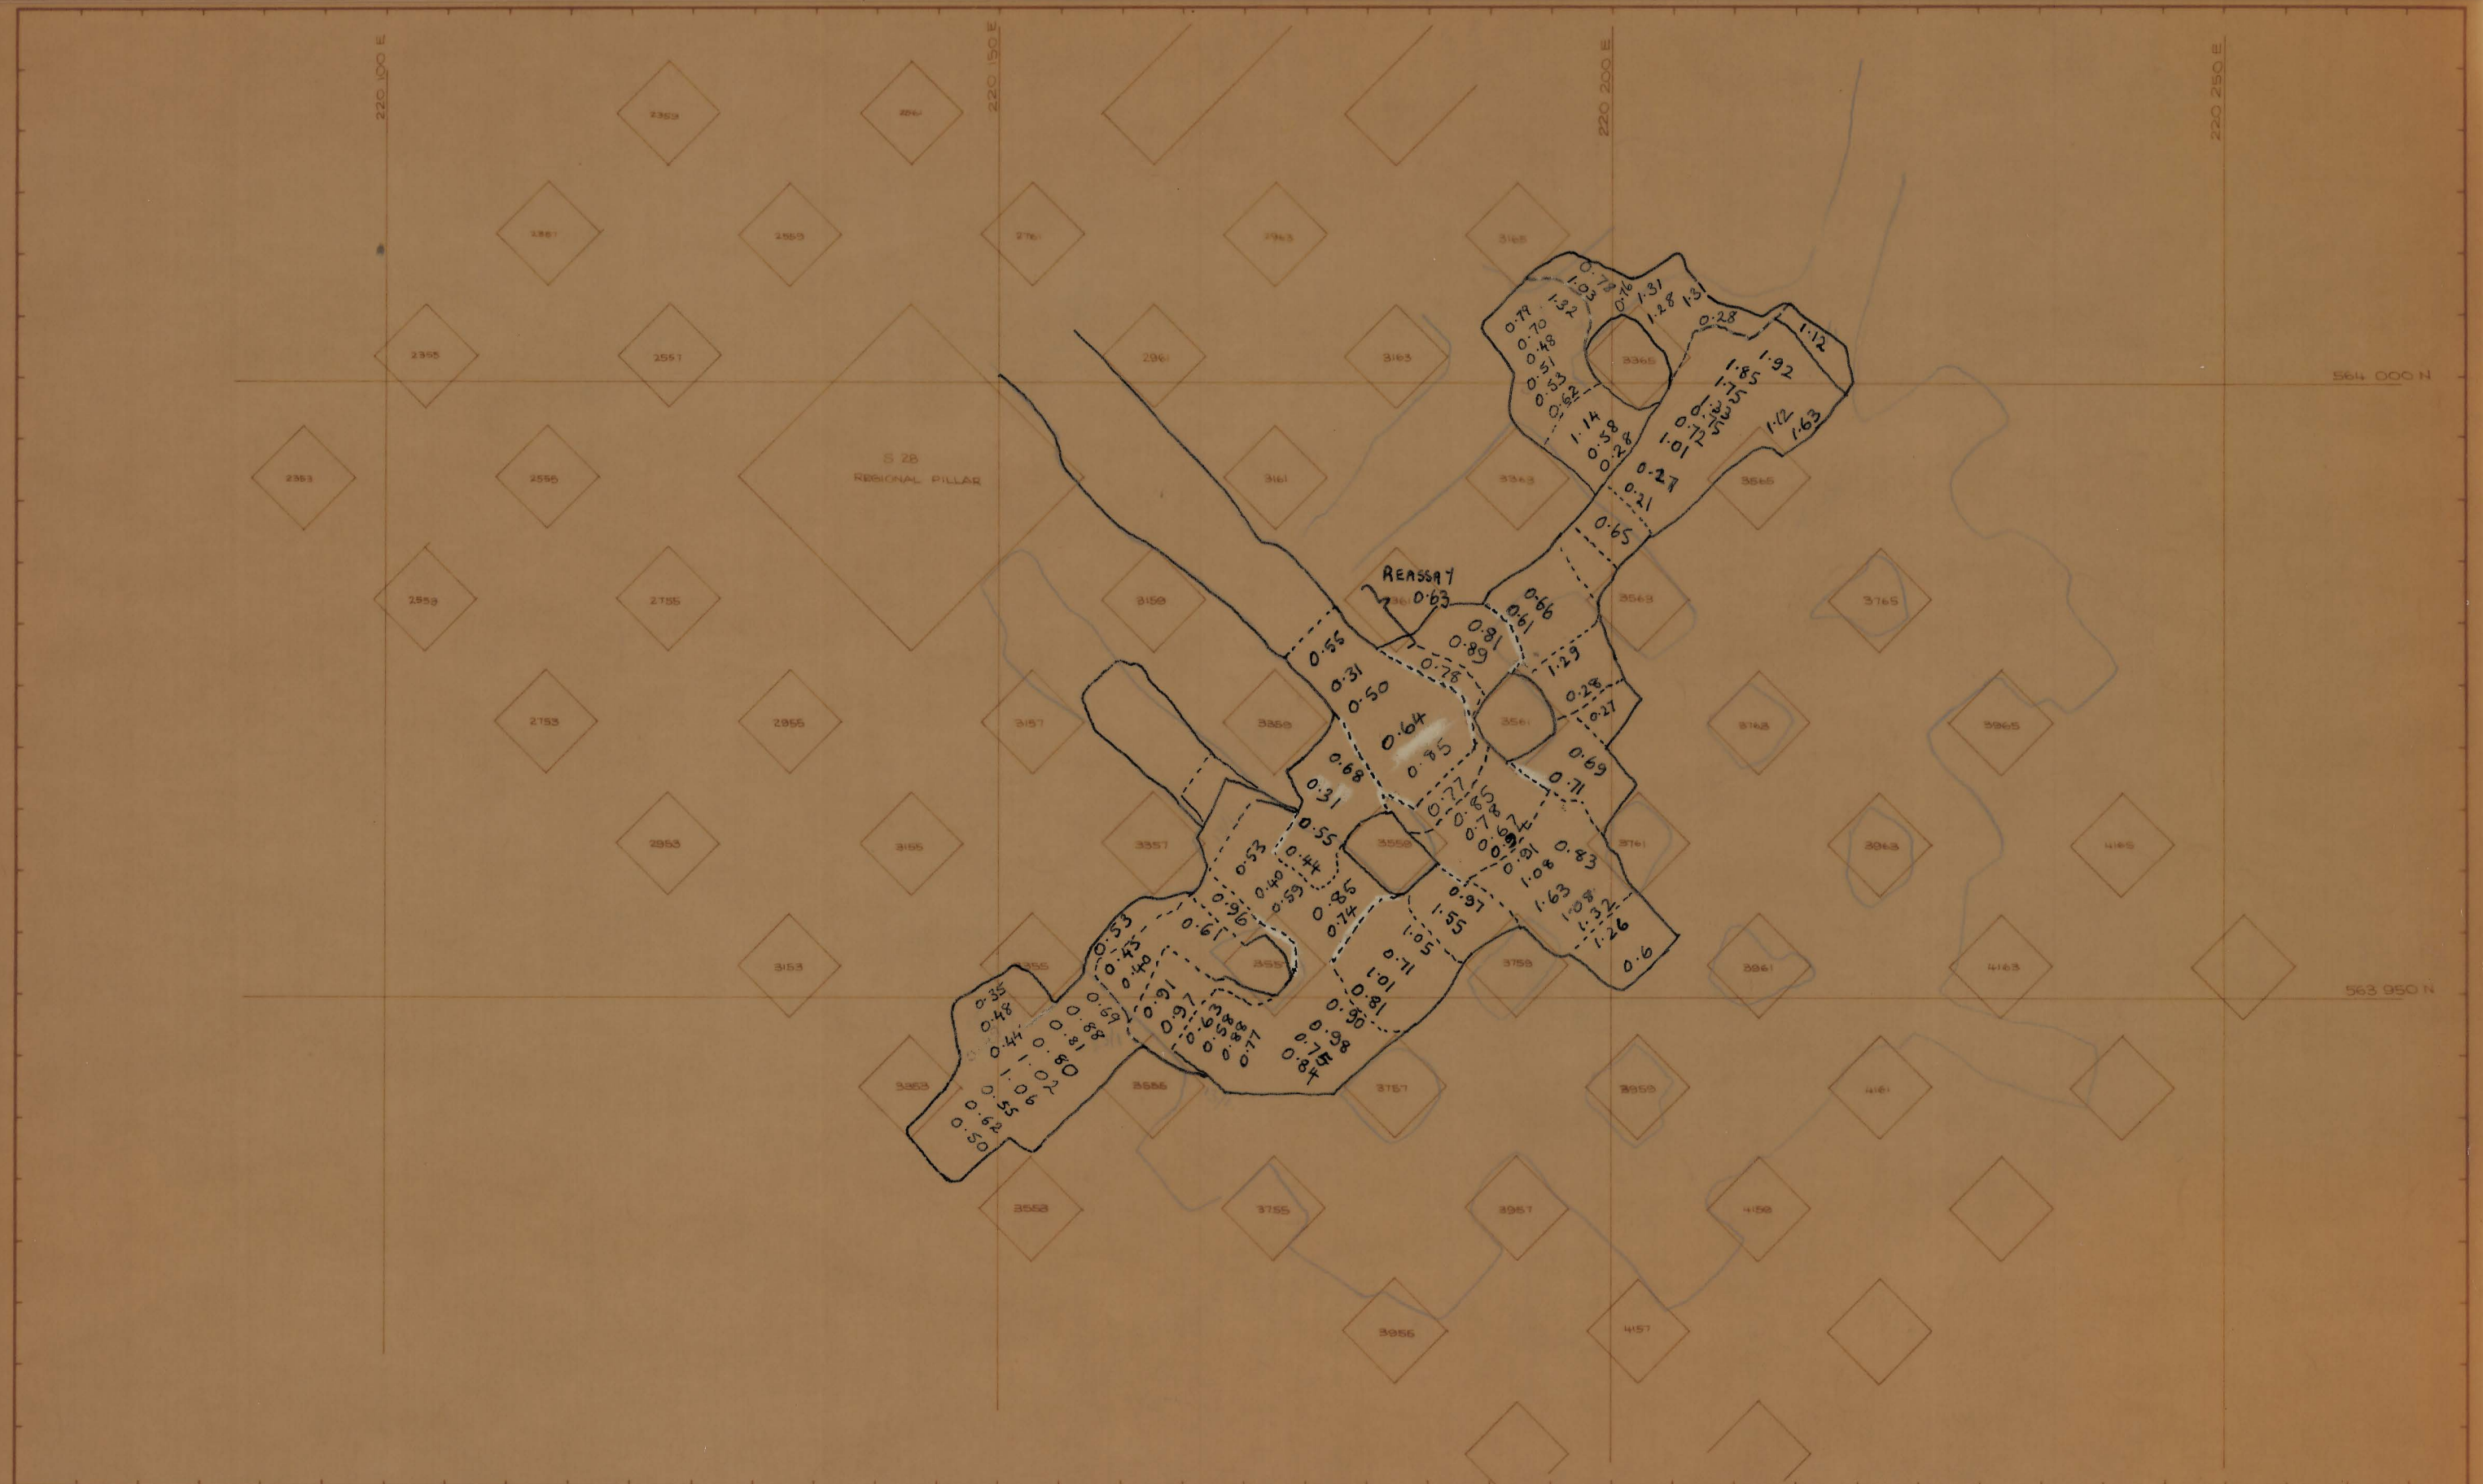

0374_1055

REF PLAN

GEOLOGY

SURVEY

PLANNING

ROCK MEC.

GRADE CON.

DRAFTING

T.S.S.

SCALE 1: 500

KIS KING ISLAND SCHEELITE
GRASSY KING ISLAND

LOWER PIT STOPE

LIFT 12

DRAWING NUMBER

5 cm