
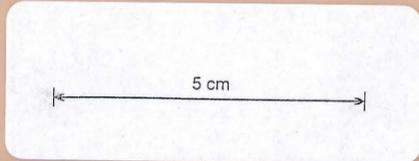


0374_1056

Lower Pit
LIFT II

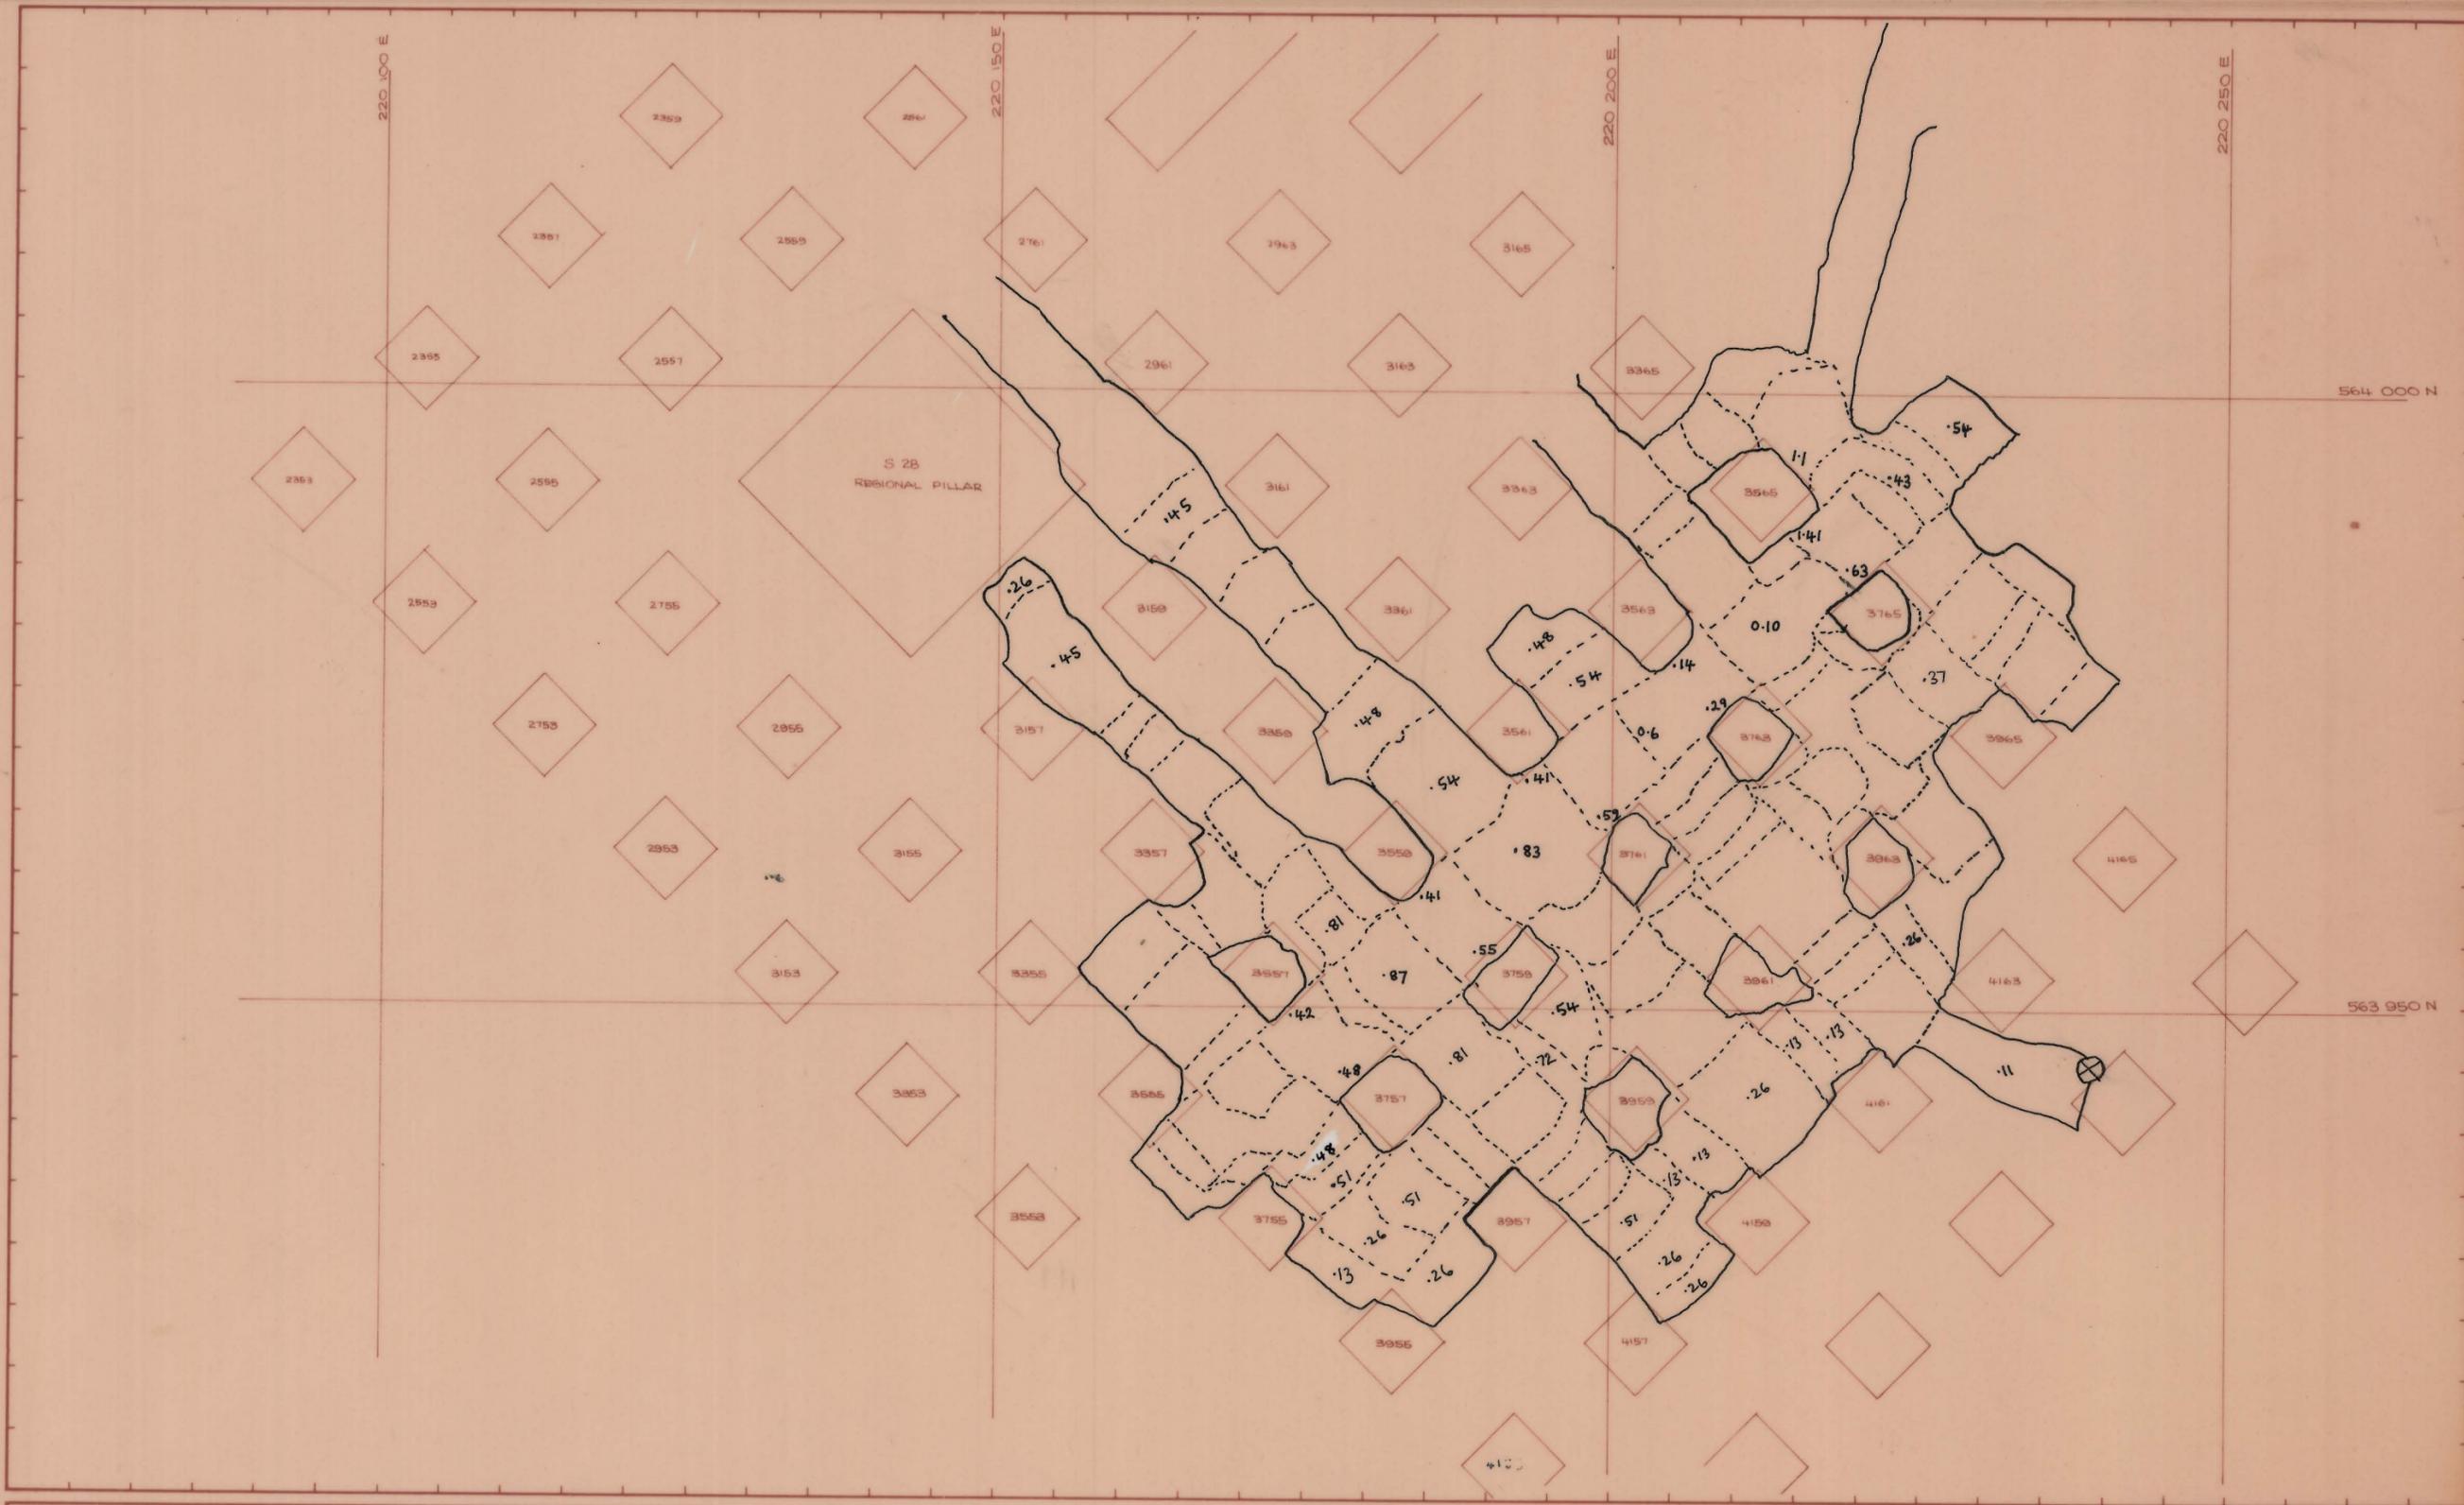

0374_1056

REF PLAN	GEOLOGY		SCALE 1: 500	
	SURVEY			
	PLANNING		LOWER PIT STOPE LIFT II DRAWING NUMBER	
	ROCK MEC.			
	GRADE CON			
DRAFTING			* - ASSUMED POSITIONS BY ASSAY DATE.	
T.S.S				