


0374_1057



0374_1057

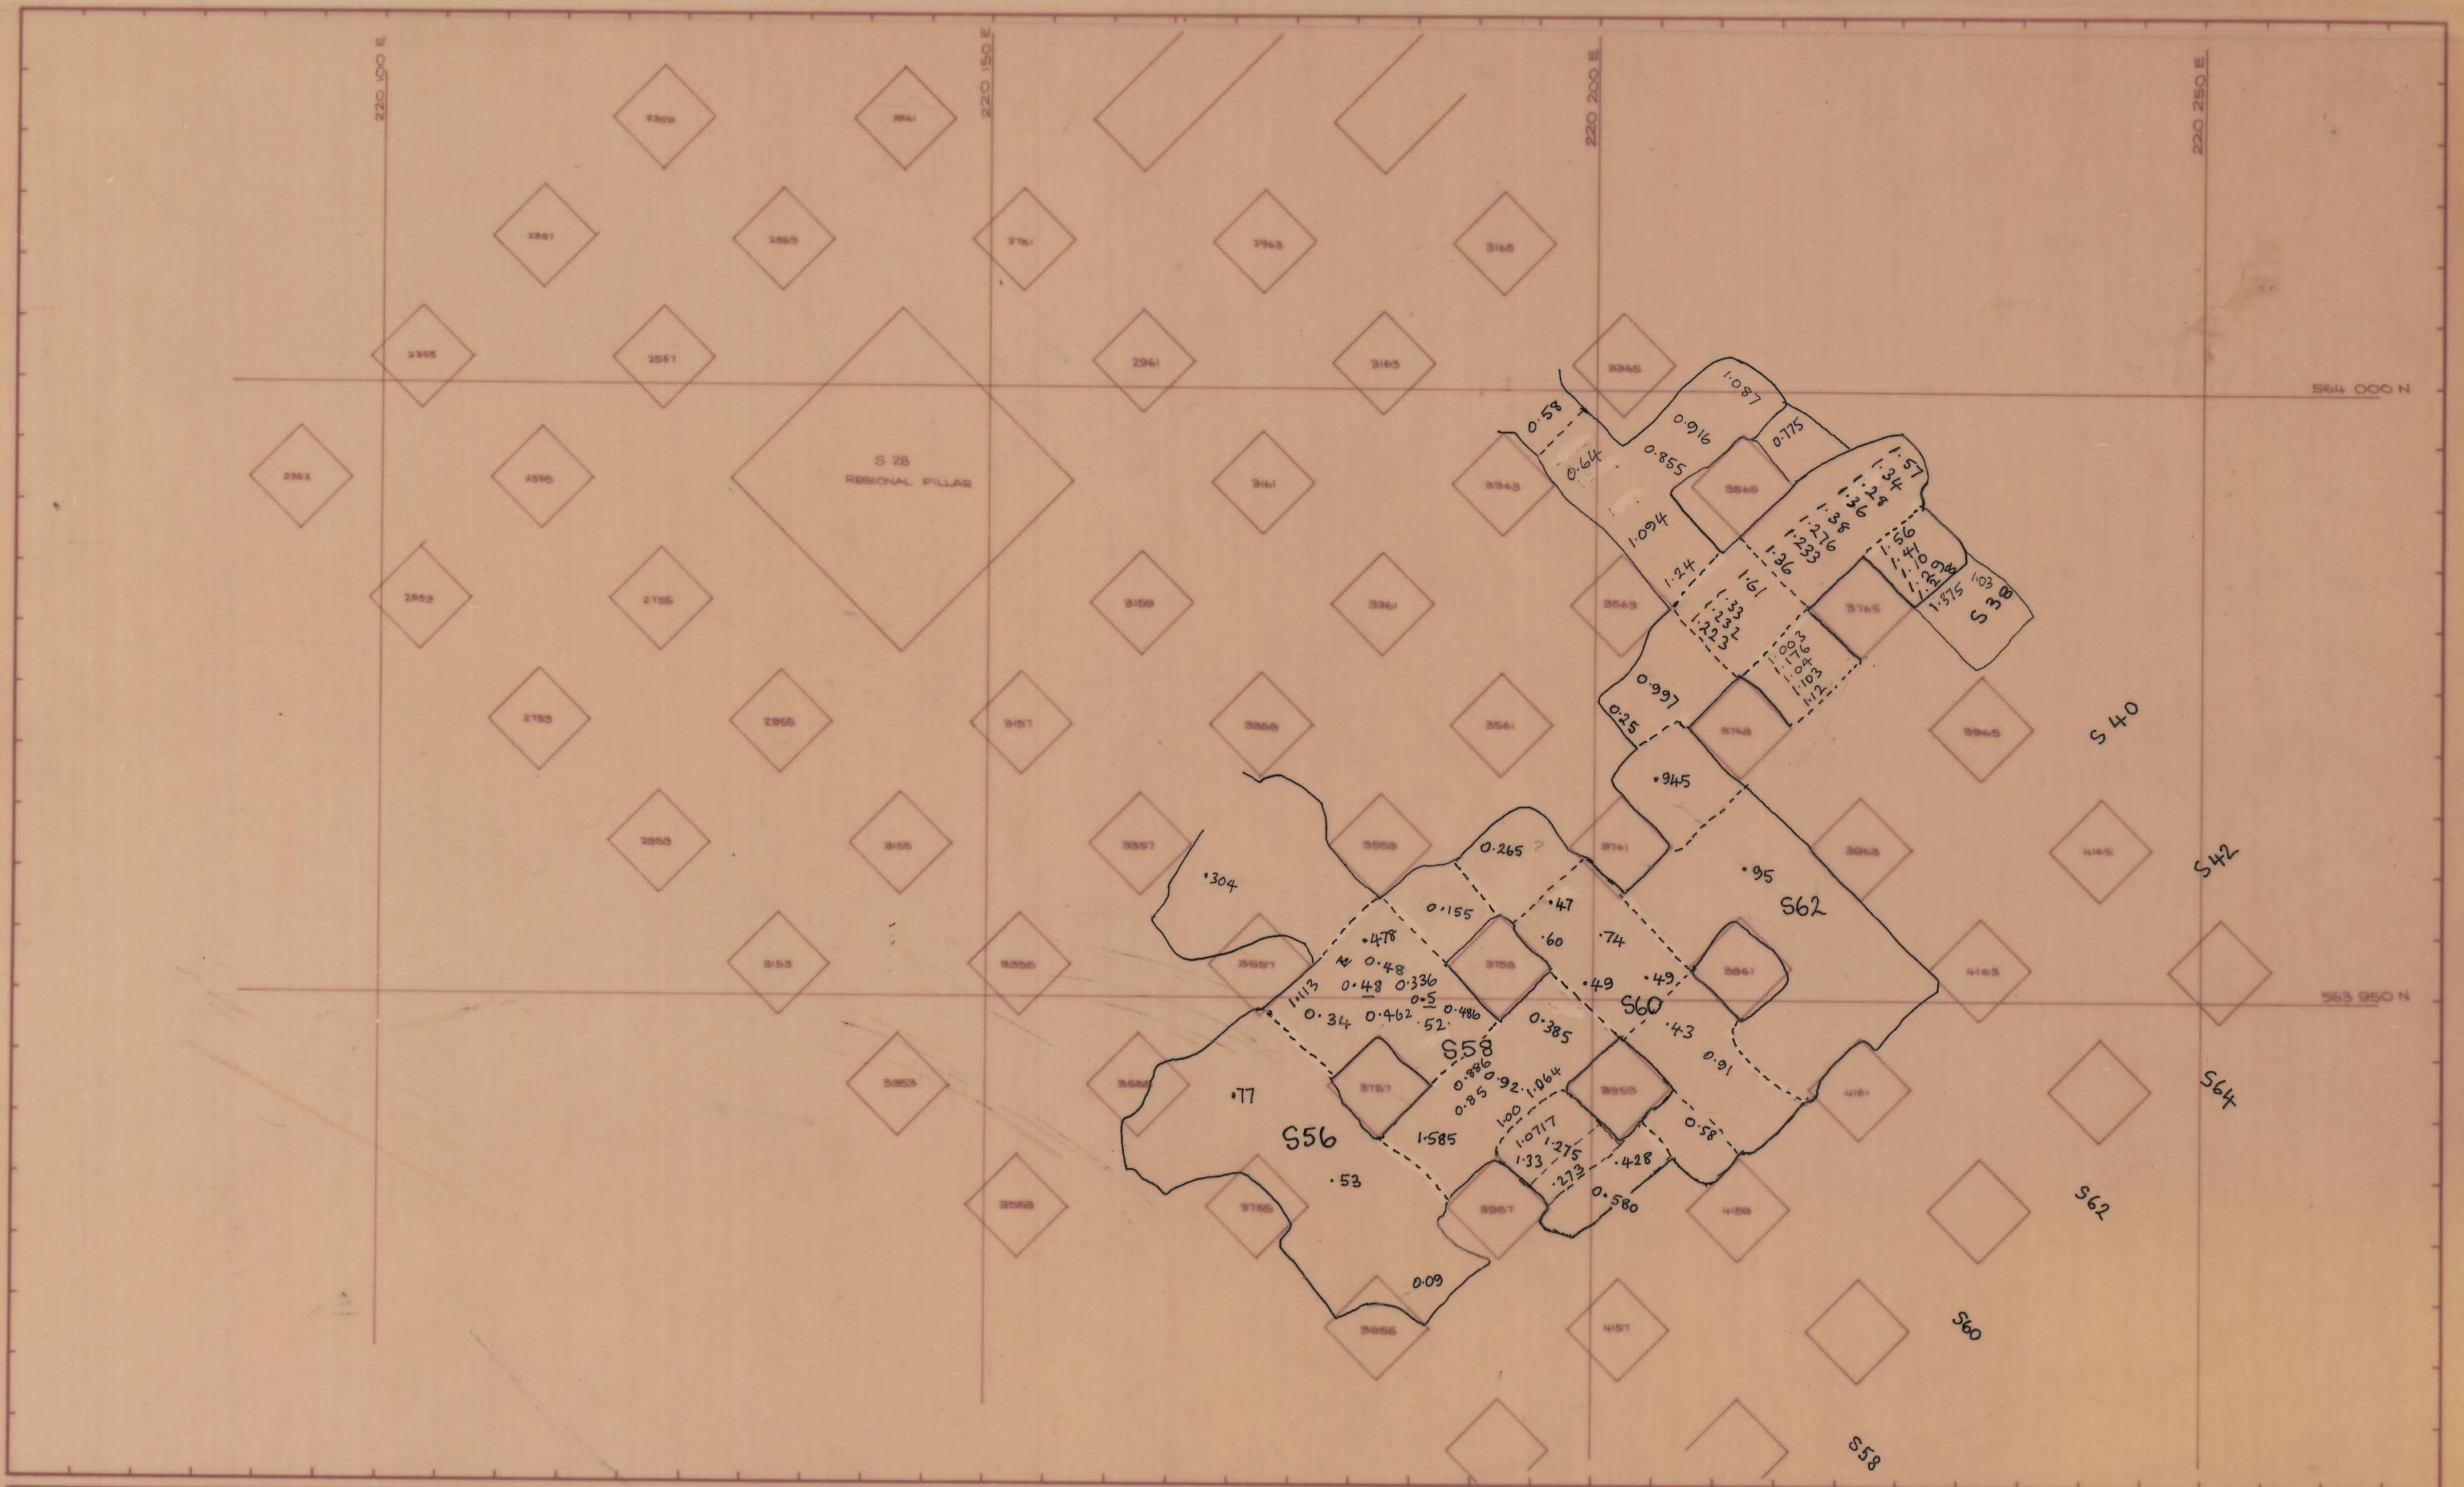

REF. PLAN	GEOLOGY	SCALE 1: 500	 KING ISLAND SCHEELITE GRASSY KING ISLAND
	SURVEY		LOWER PIT STOPE LIFT 10 FLOOR STRIPPING + SILL BENCHING
	PLANNING		
	ROCK MEC.		
	GRADE CON.	AD Judge 1986/7	
	DRAFTING		
	T.S.S.	DRAWING NUMBER	