



0374_1059

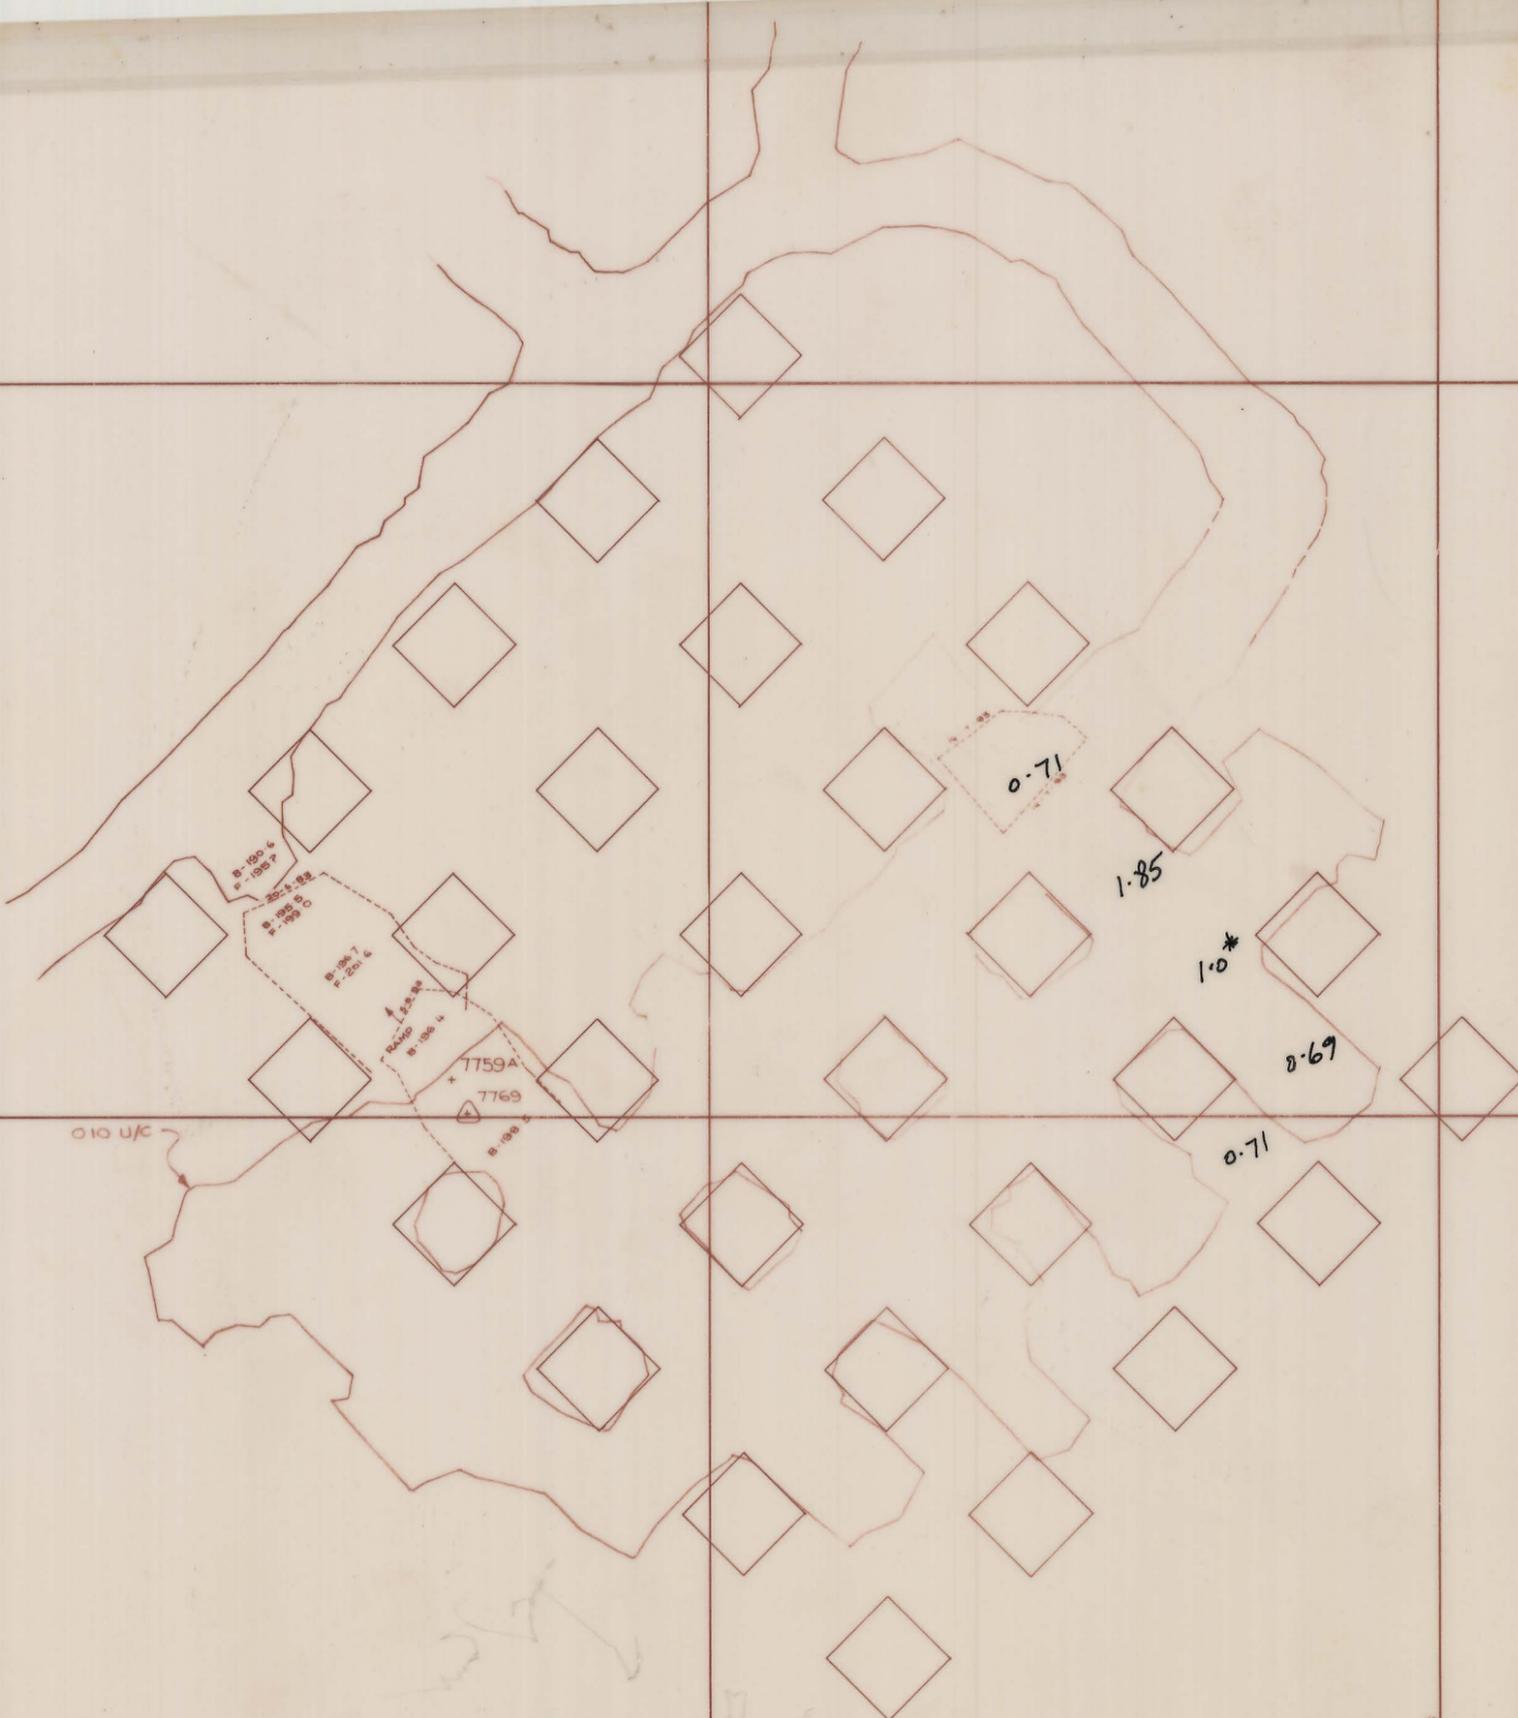

LOWER PIT
SILL REMOVAL

0374_1059

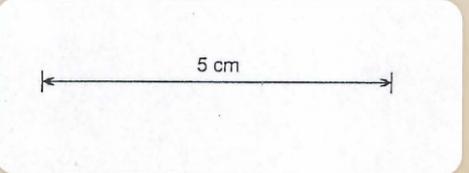

SCALE 1: 500

LOCATION