



0374\_1063

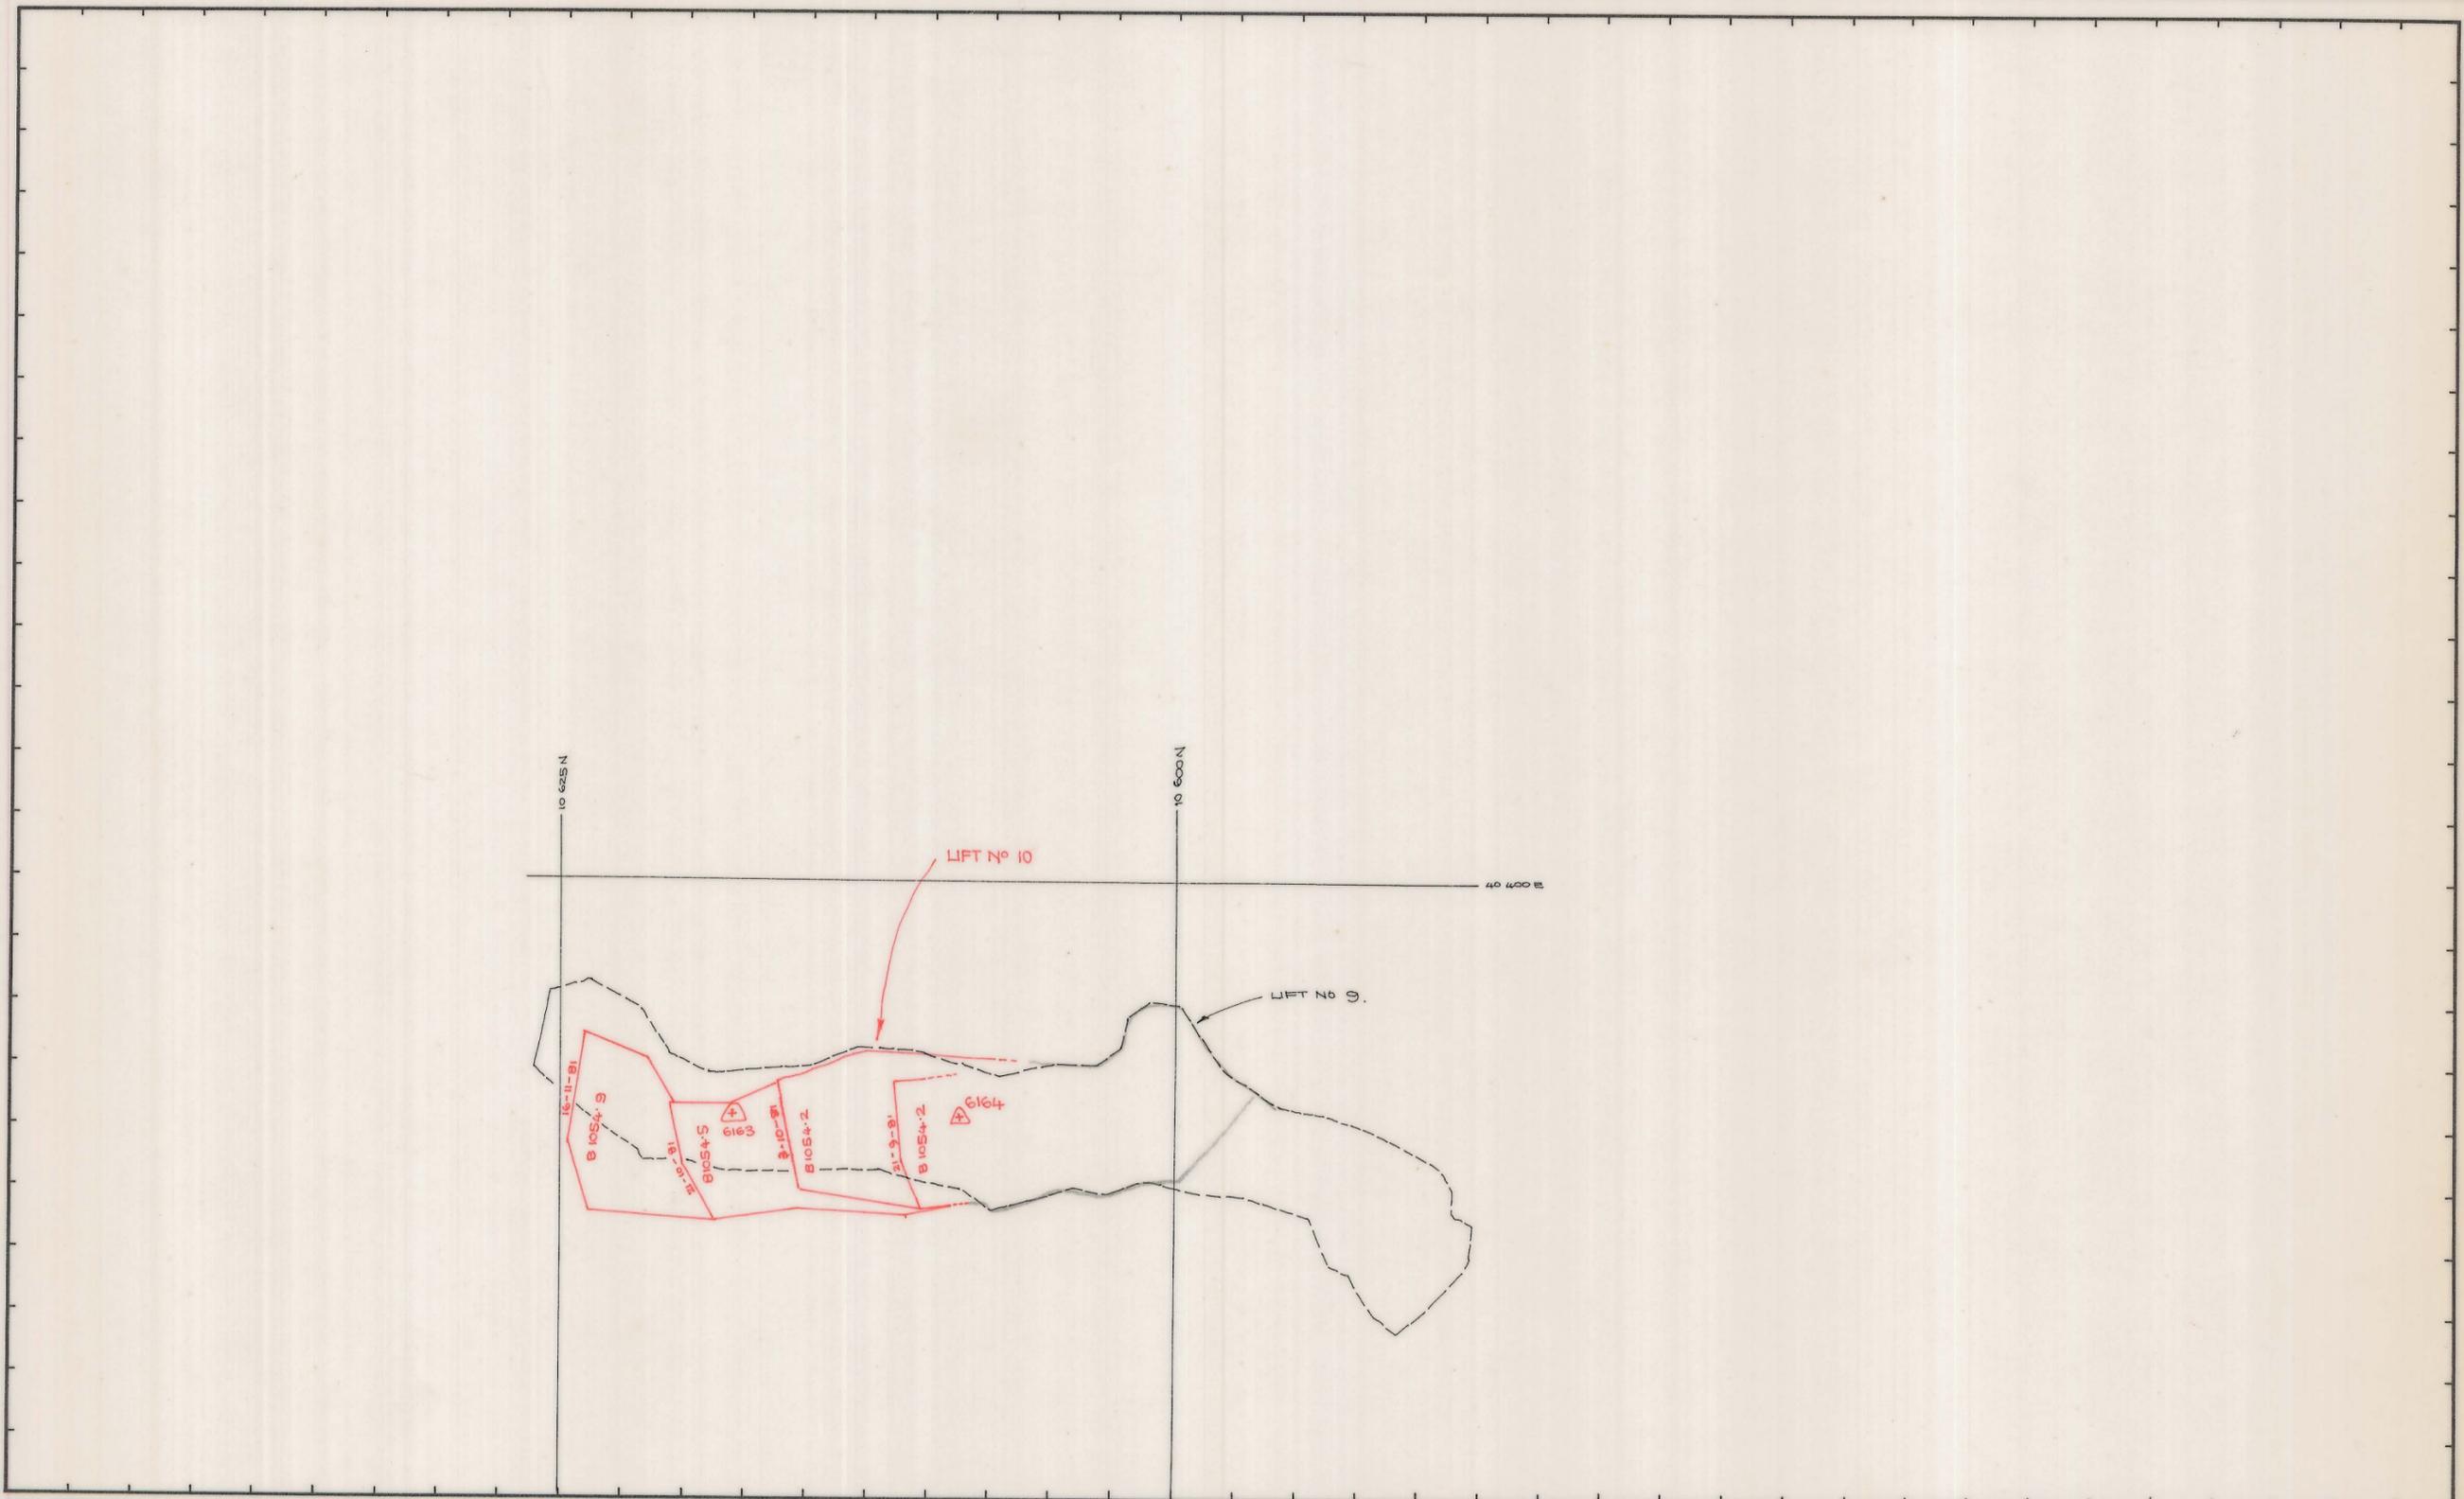

0374\_1063

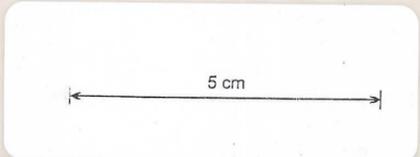

REF. PLAN	GEOLOGY			SCALE 1:	
	SURVEY				
	PLANNING			DRAWING NUMBER	
	ROCK MEC.				
	GRADE CON.				
	DRAFTING				
T.S.S.					