


0374\_1067

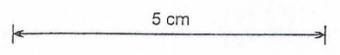

REF PLAN


NOTE

- A - RL ON UNDERSIDE OF SET ARCH.
- B - RL OF DRIVE BACK
- F - RL OF DRIVE FLOOR

GEOLOGY

SURVEY	J. Cook
PLANNING	
ROCK MEC.	
GRADE CON.	
DRAFTING	B Collins
T.S.S.	

SCALE 1:100

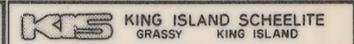

-240 S10 DRILL DRIVE

DRAWING NUMBER