
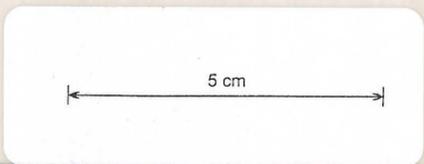


0374\_1068

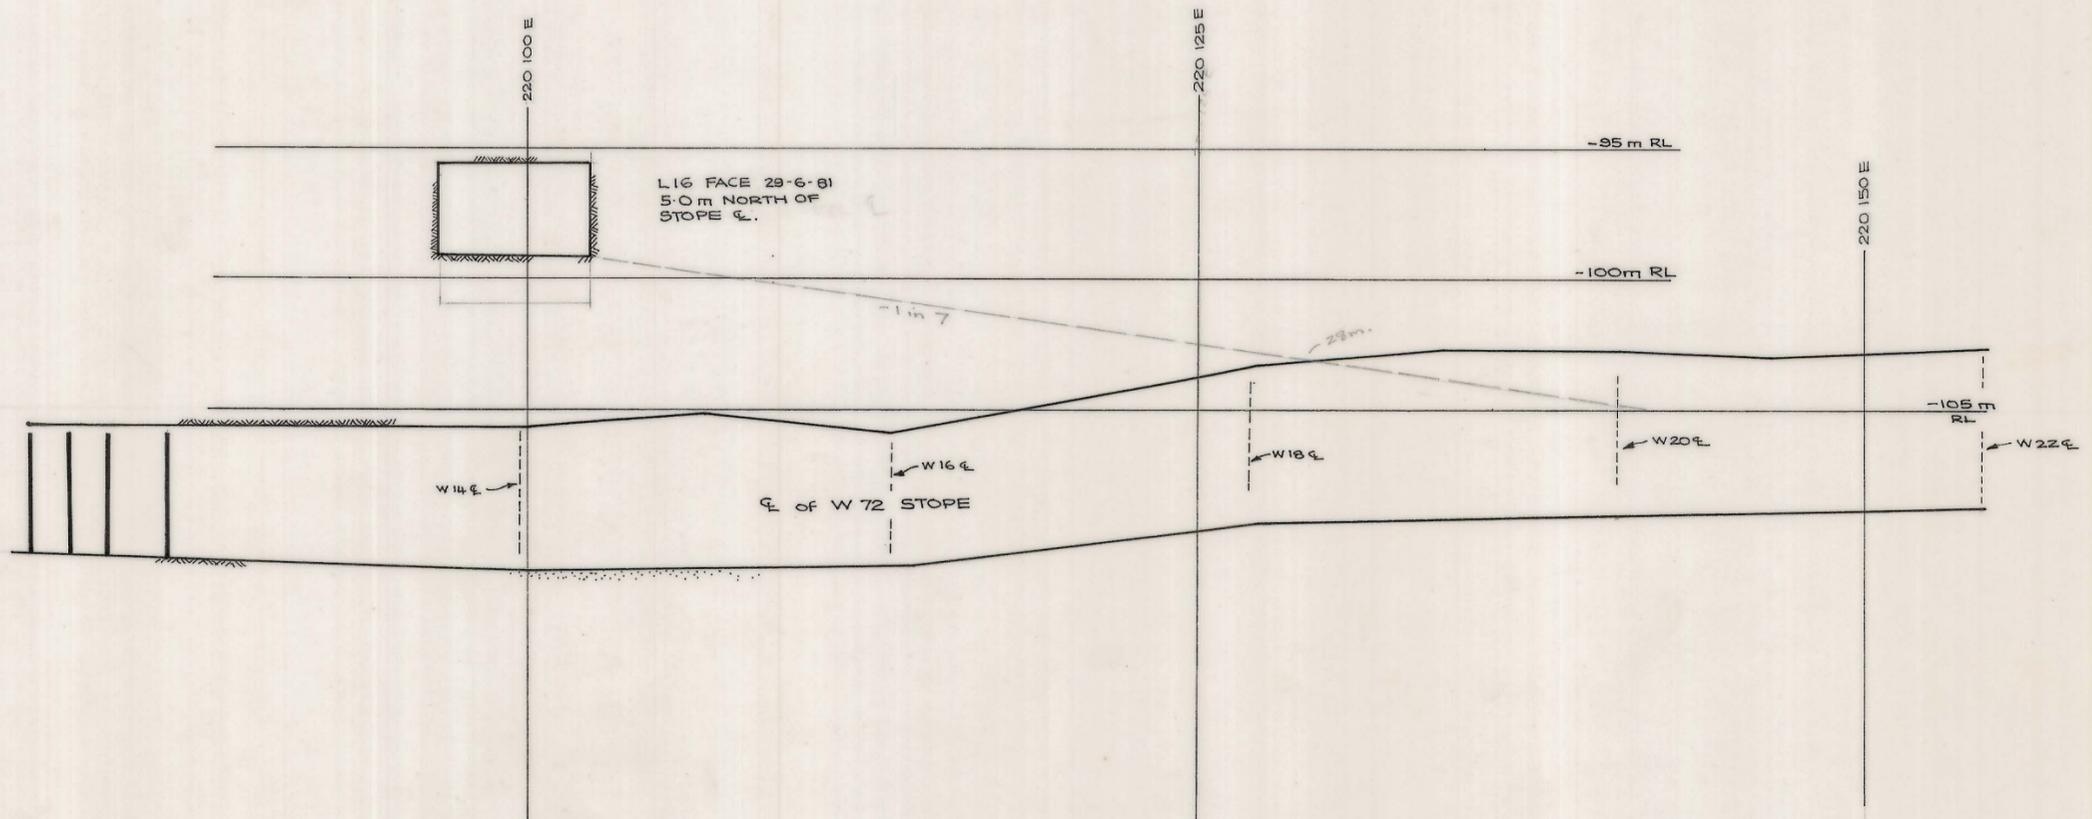

0374\_1068

REF PLAN 04DM12-155 107, 155 105 & 04DM13-155 106

GEOLOGY	
SURVEY	
PLANNING	
ROCK MEC.	
GRADE CON.	
DRAFTING	
T.S.S.	

SCALE 1:250



SECTION ALONG W 72  
C CENTRAL STOPE

DRAWING NUMBER