



0374_1069

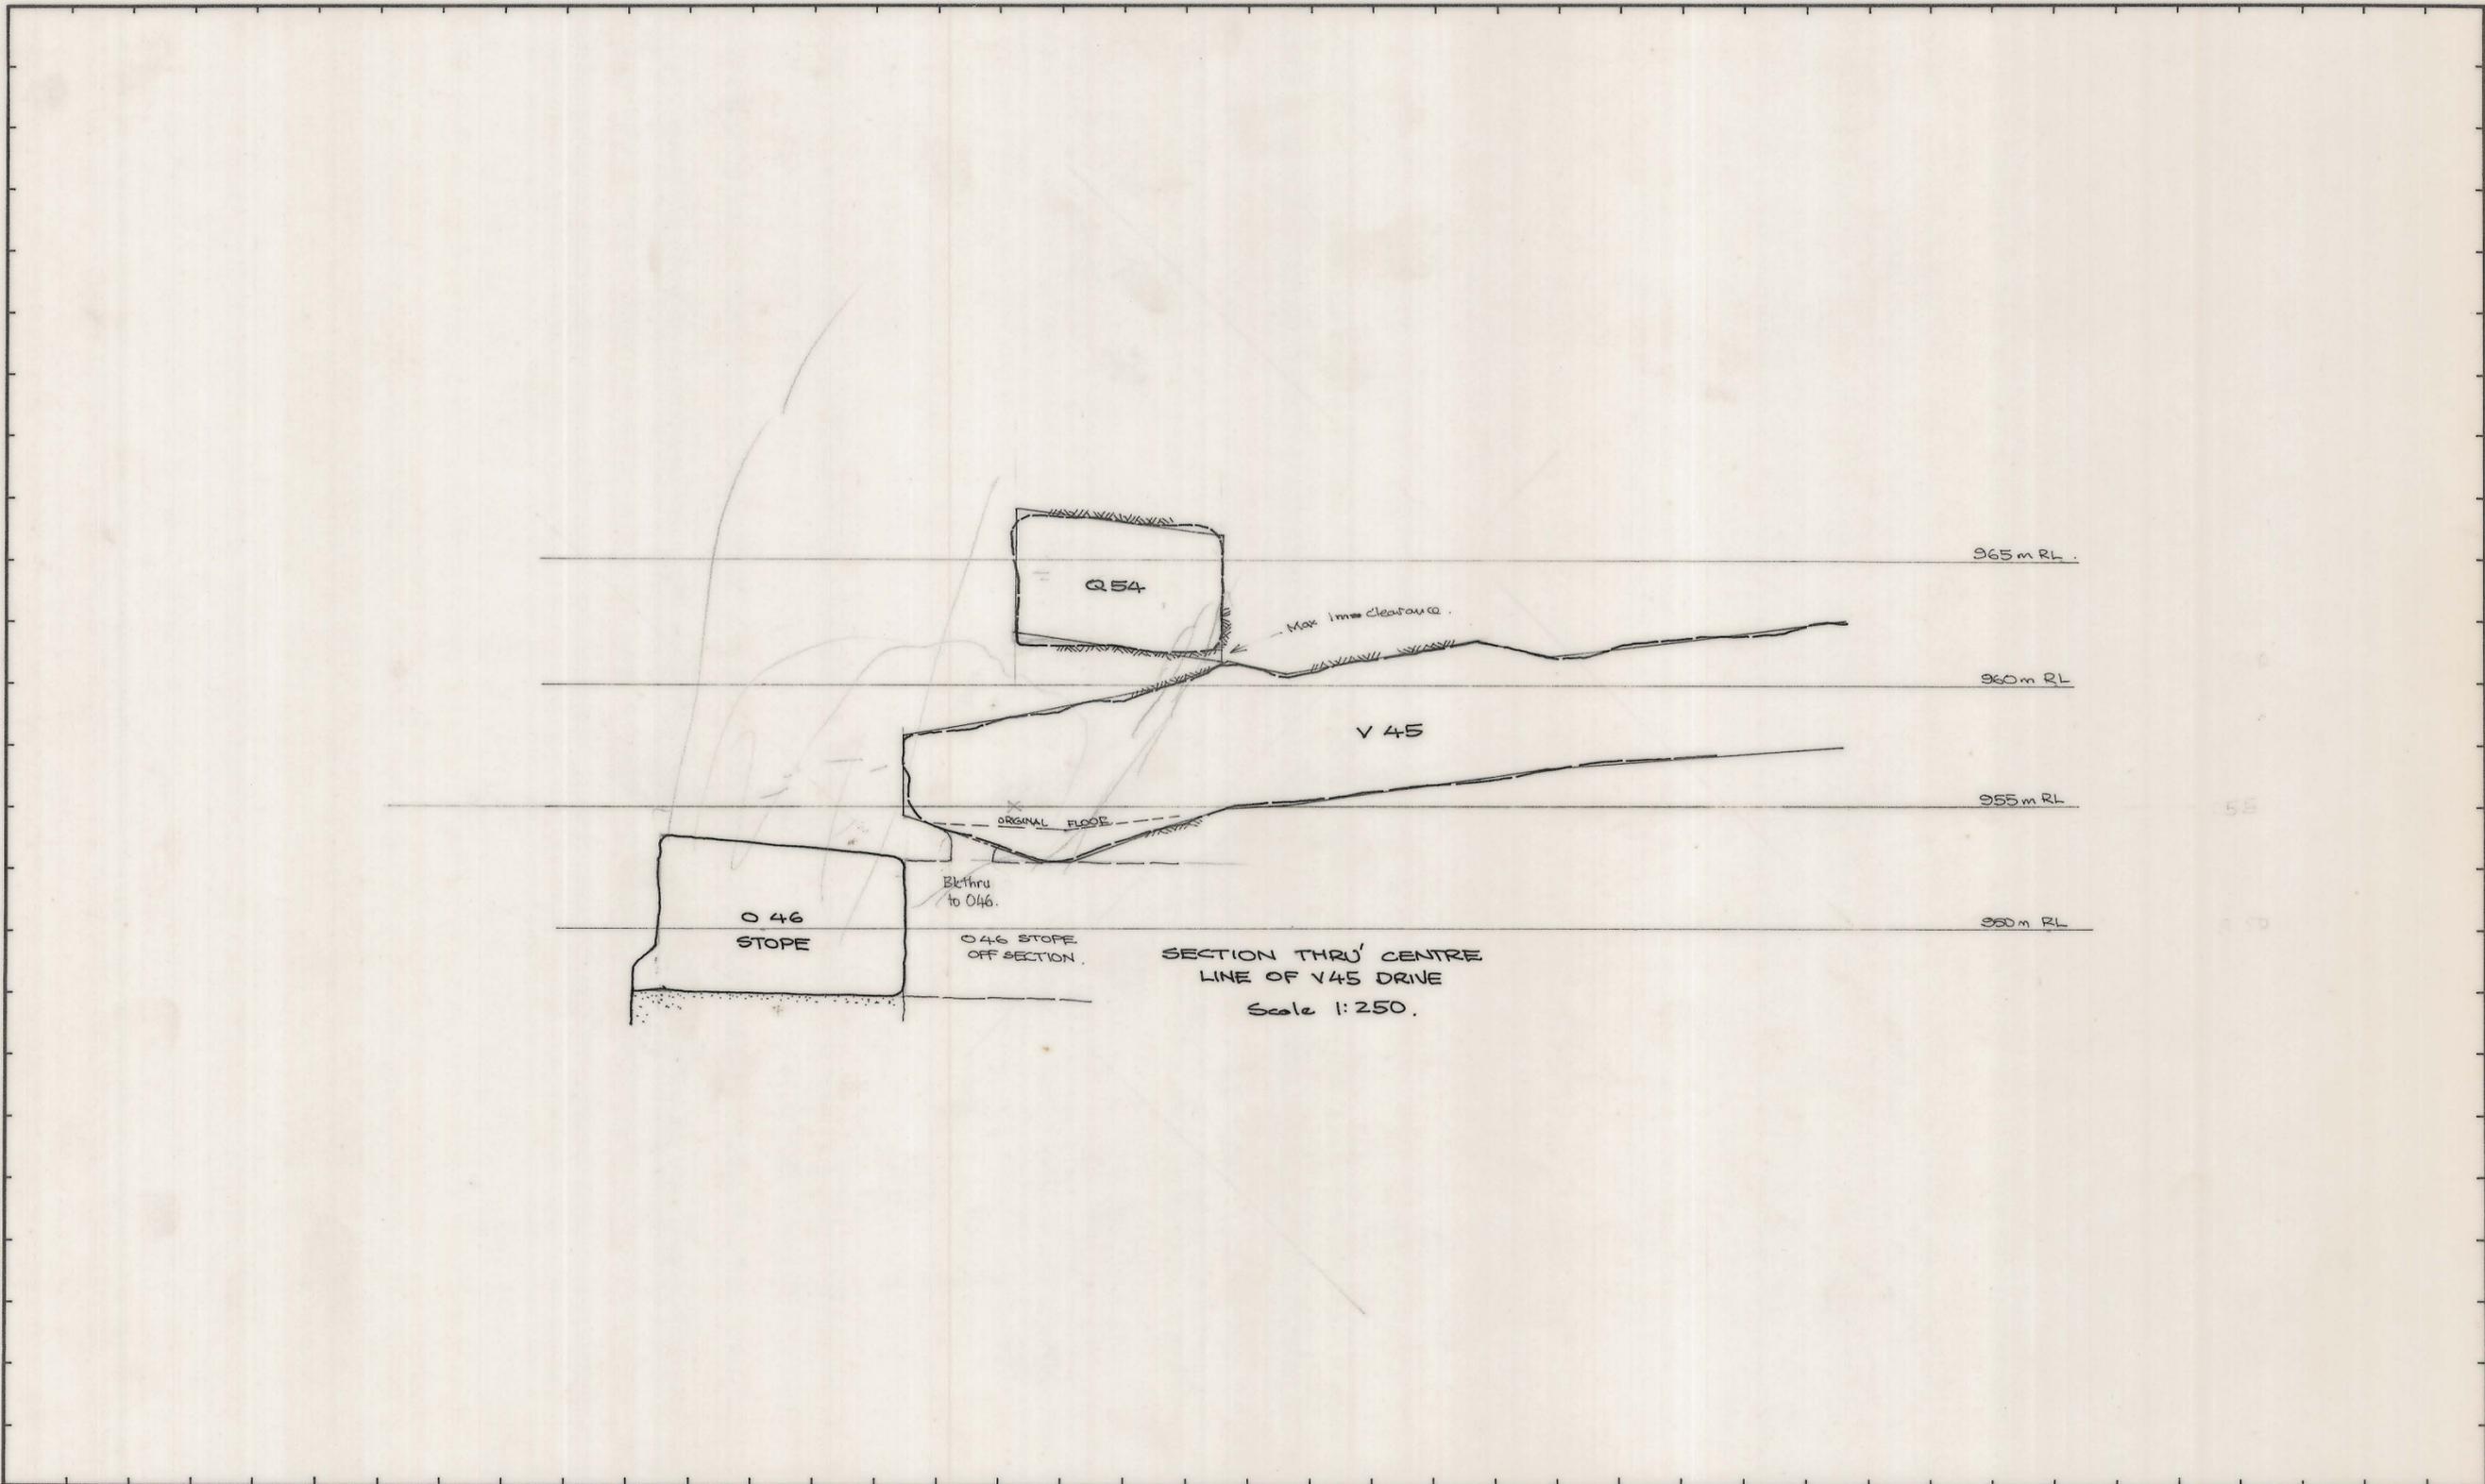

0374_1069

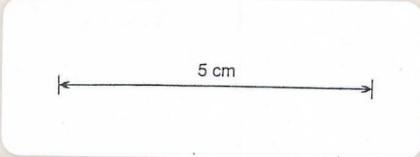

REF. PLAN	GEOLOGY			SCALE 1:	
	SURVEY				
	PLANNING				
	ROCK MEC.				
	GRADE CON.				
	DRAFTING				
T.S.S.			DRAWING NUMBER		