
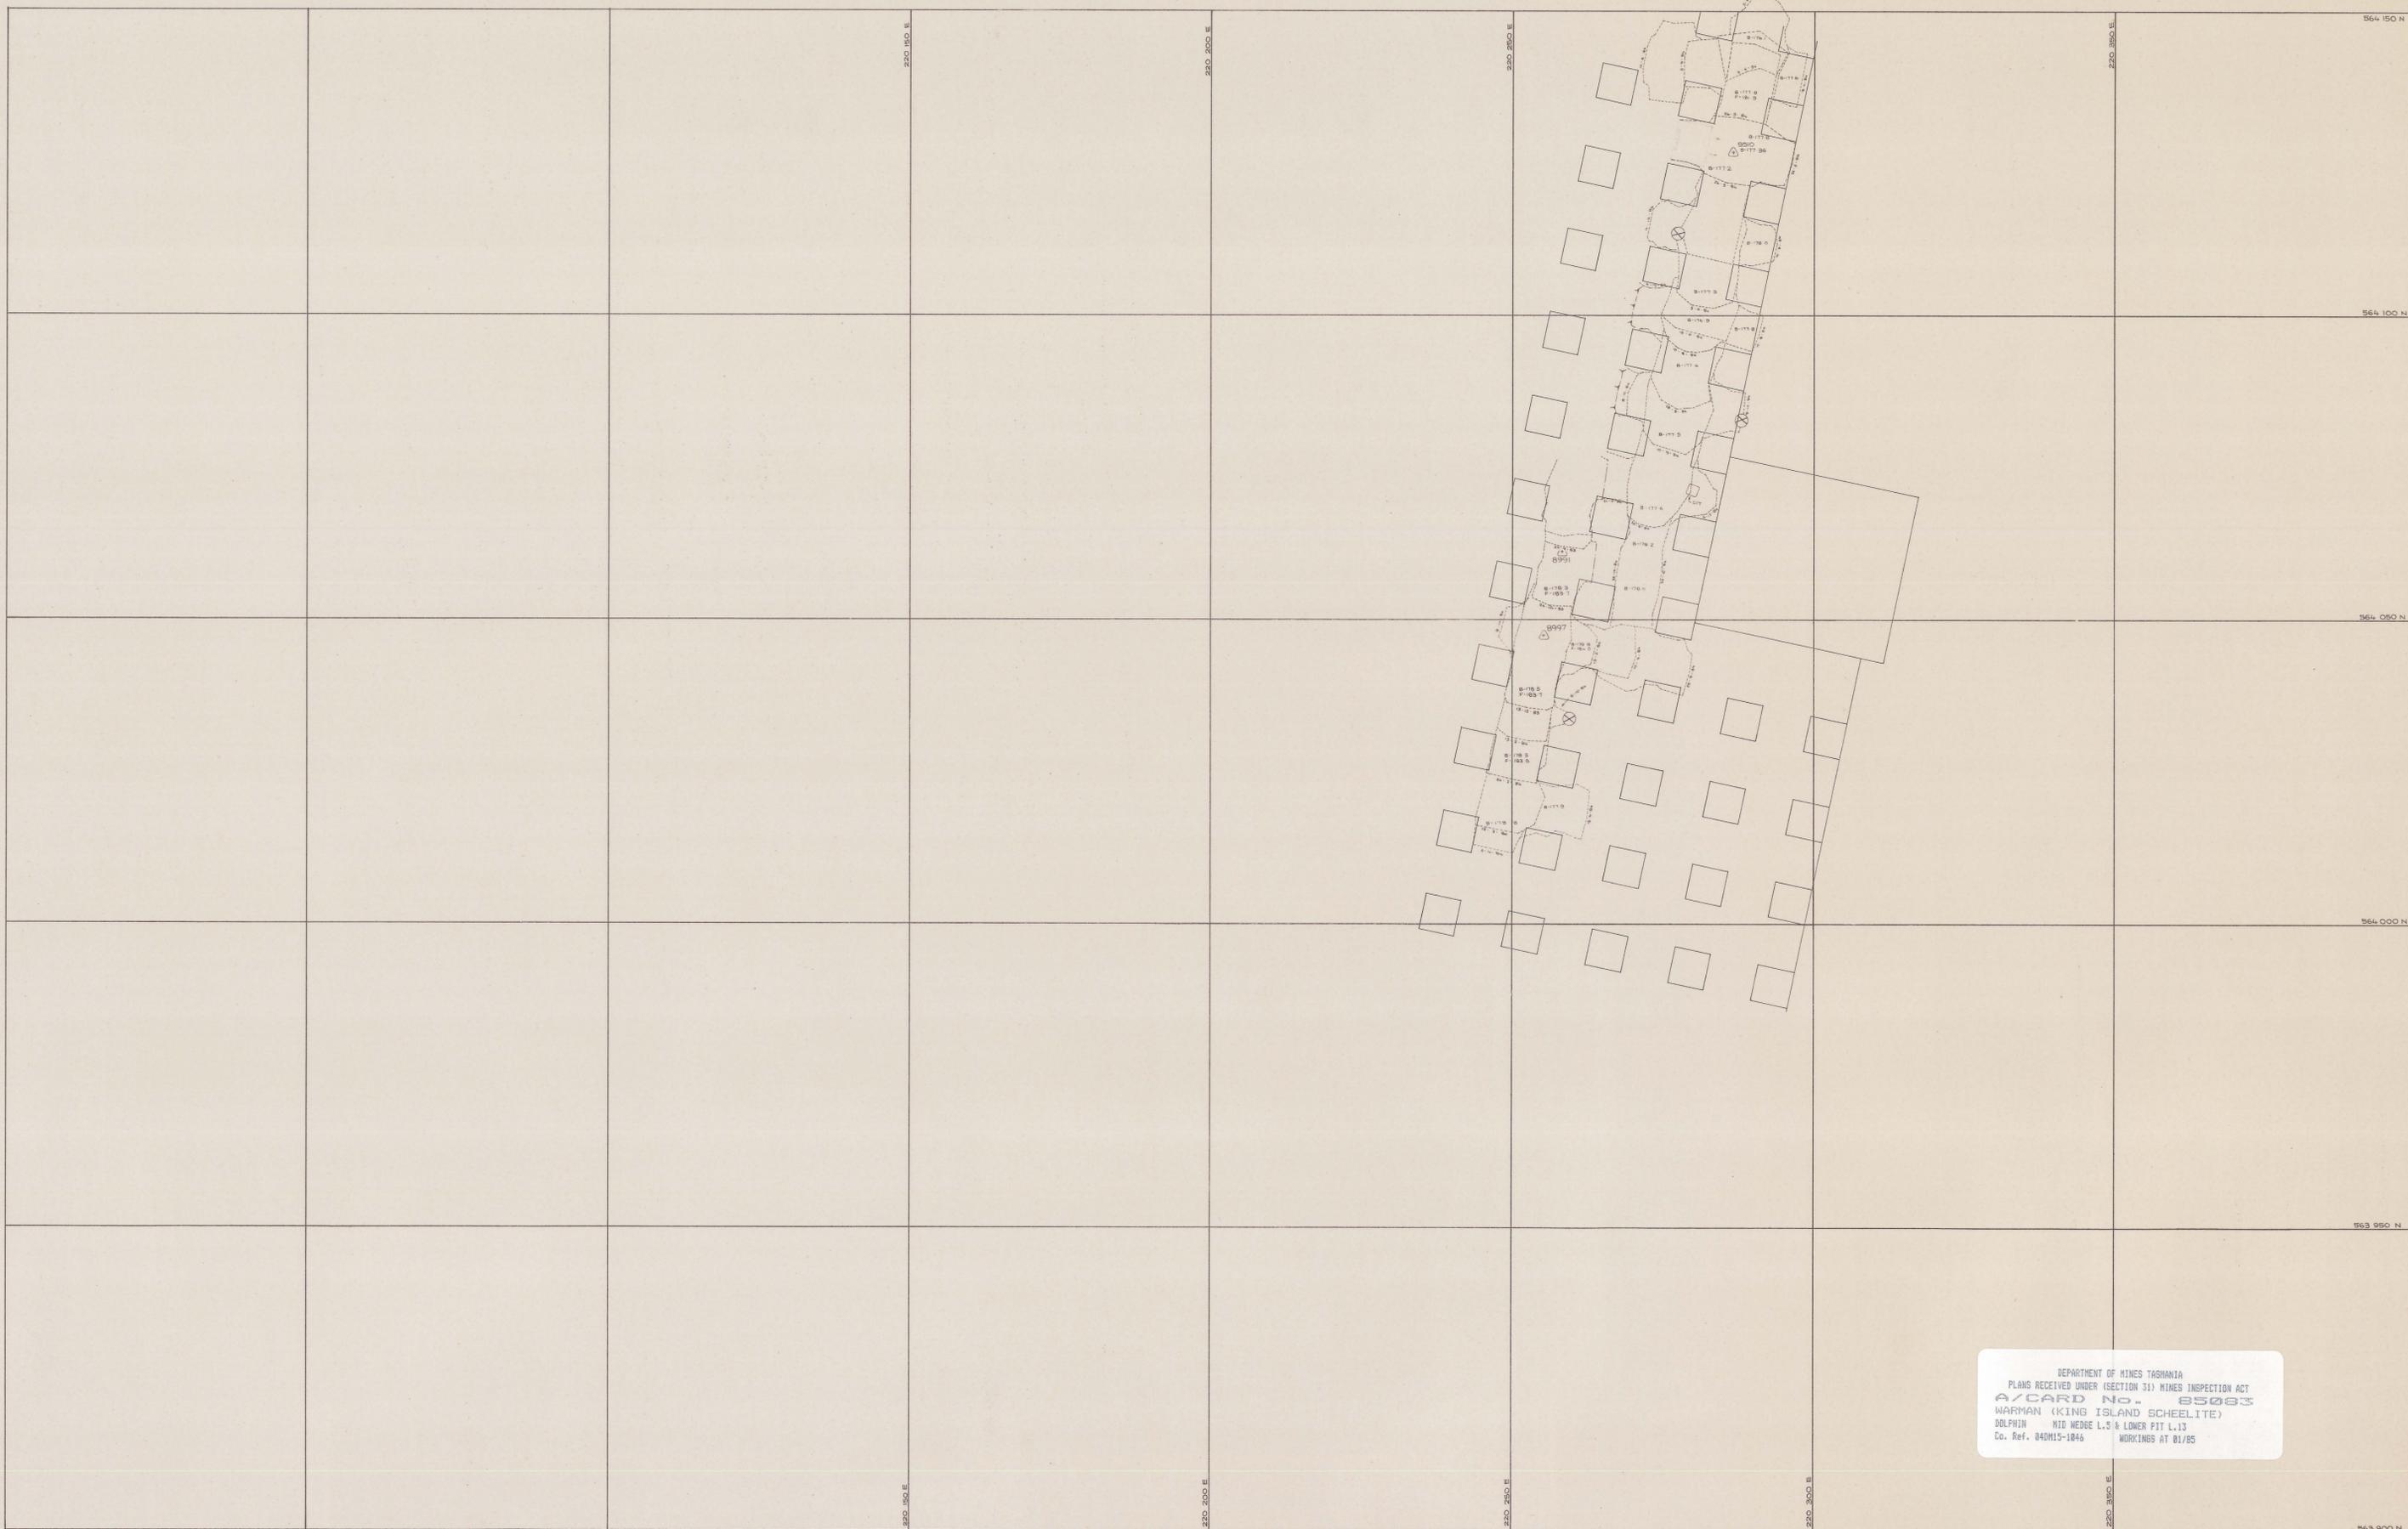


104 - 107

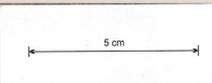

DEPARTMENT OF MINES TASMANIA
 PLANS RECEIVED UNDER (SECTION 31) MINES INSPECTION ACT
A/CARD No. 85083
 WARMAN (KING ISLAND SCHEELITE)
 DOLPHIN MID WEDGE L.5 & LOWER PIT L.13
 Co. Ref. 84DM15-1046 WORKINGS AT 01/85

	SCALE 1: 500 	 <p>north</p>	LOCATION DOLPHIN MINE SUBJECT MID WEDGE LIFT N° 5 LOWER PIT LIFT N° 13	 <p>KING ISLAND SCHEELITE A DIVISION OF WARMAN INTERNATIONAL</p> <p>GRASSY KING ISLAND</p> <p>PLAN NUMBER 04DM15 - 1046</p>
--	---	--	--	--