


0374\_1070

LOWER PIT  
LIFT 1



0374\_1070

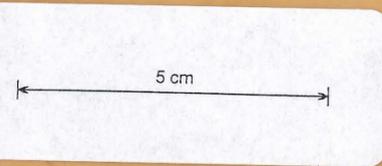

-  MINING LIMIT
-  WASTE MINED DISCARDED
-  WASTE

\* LAMPED VALUES

N 1