


0374_1072

LOWER PIT STOPE
3rd LIFT -215m RL
ACCESS N7

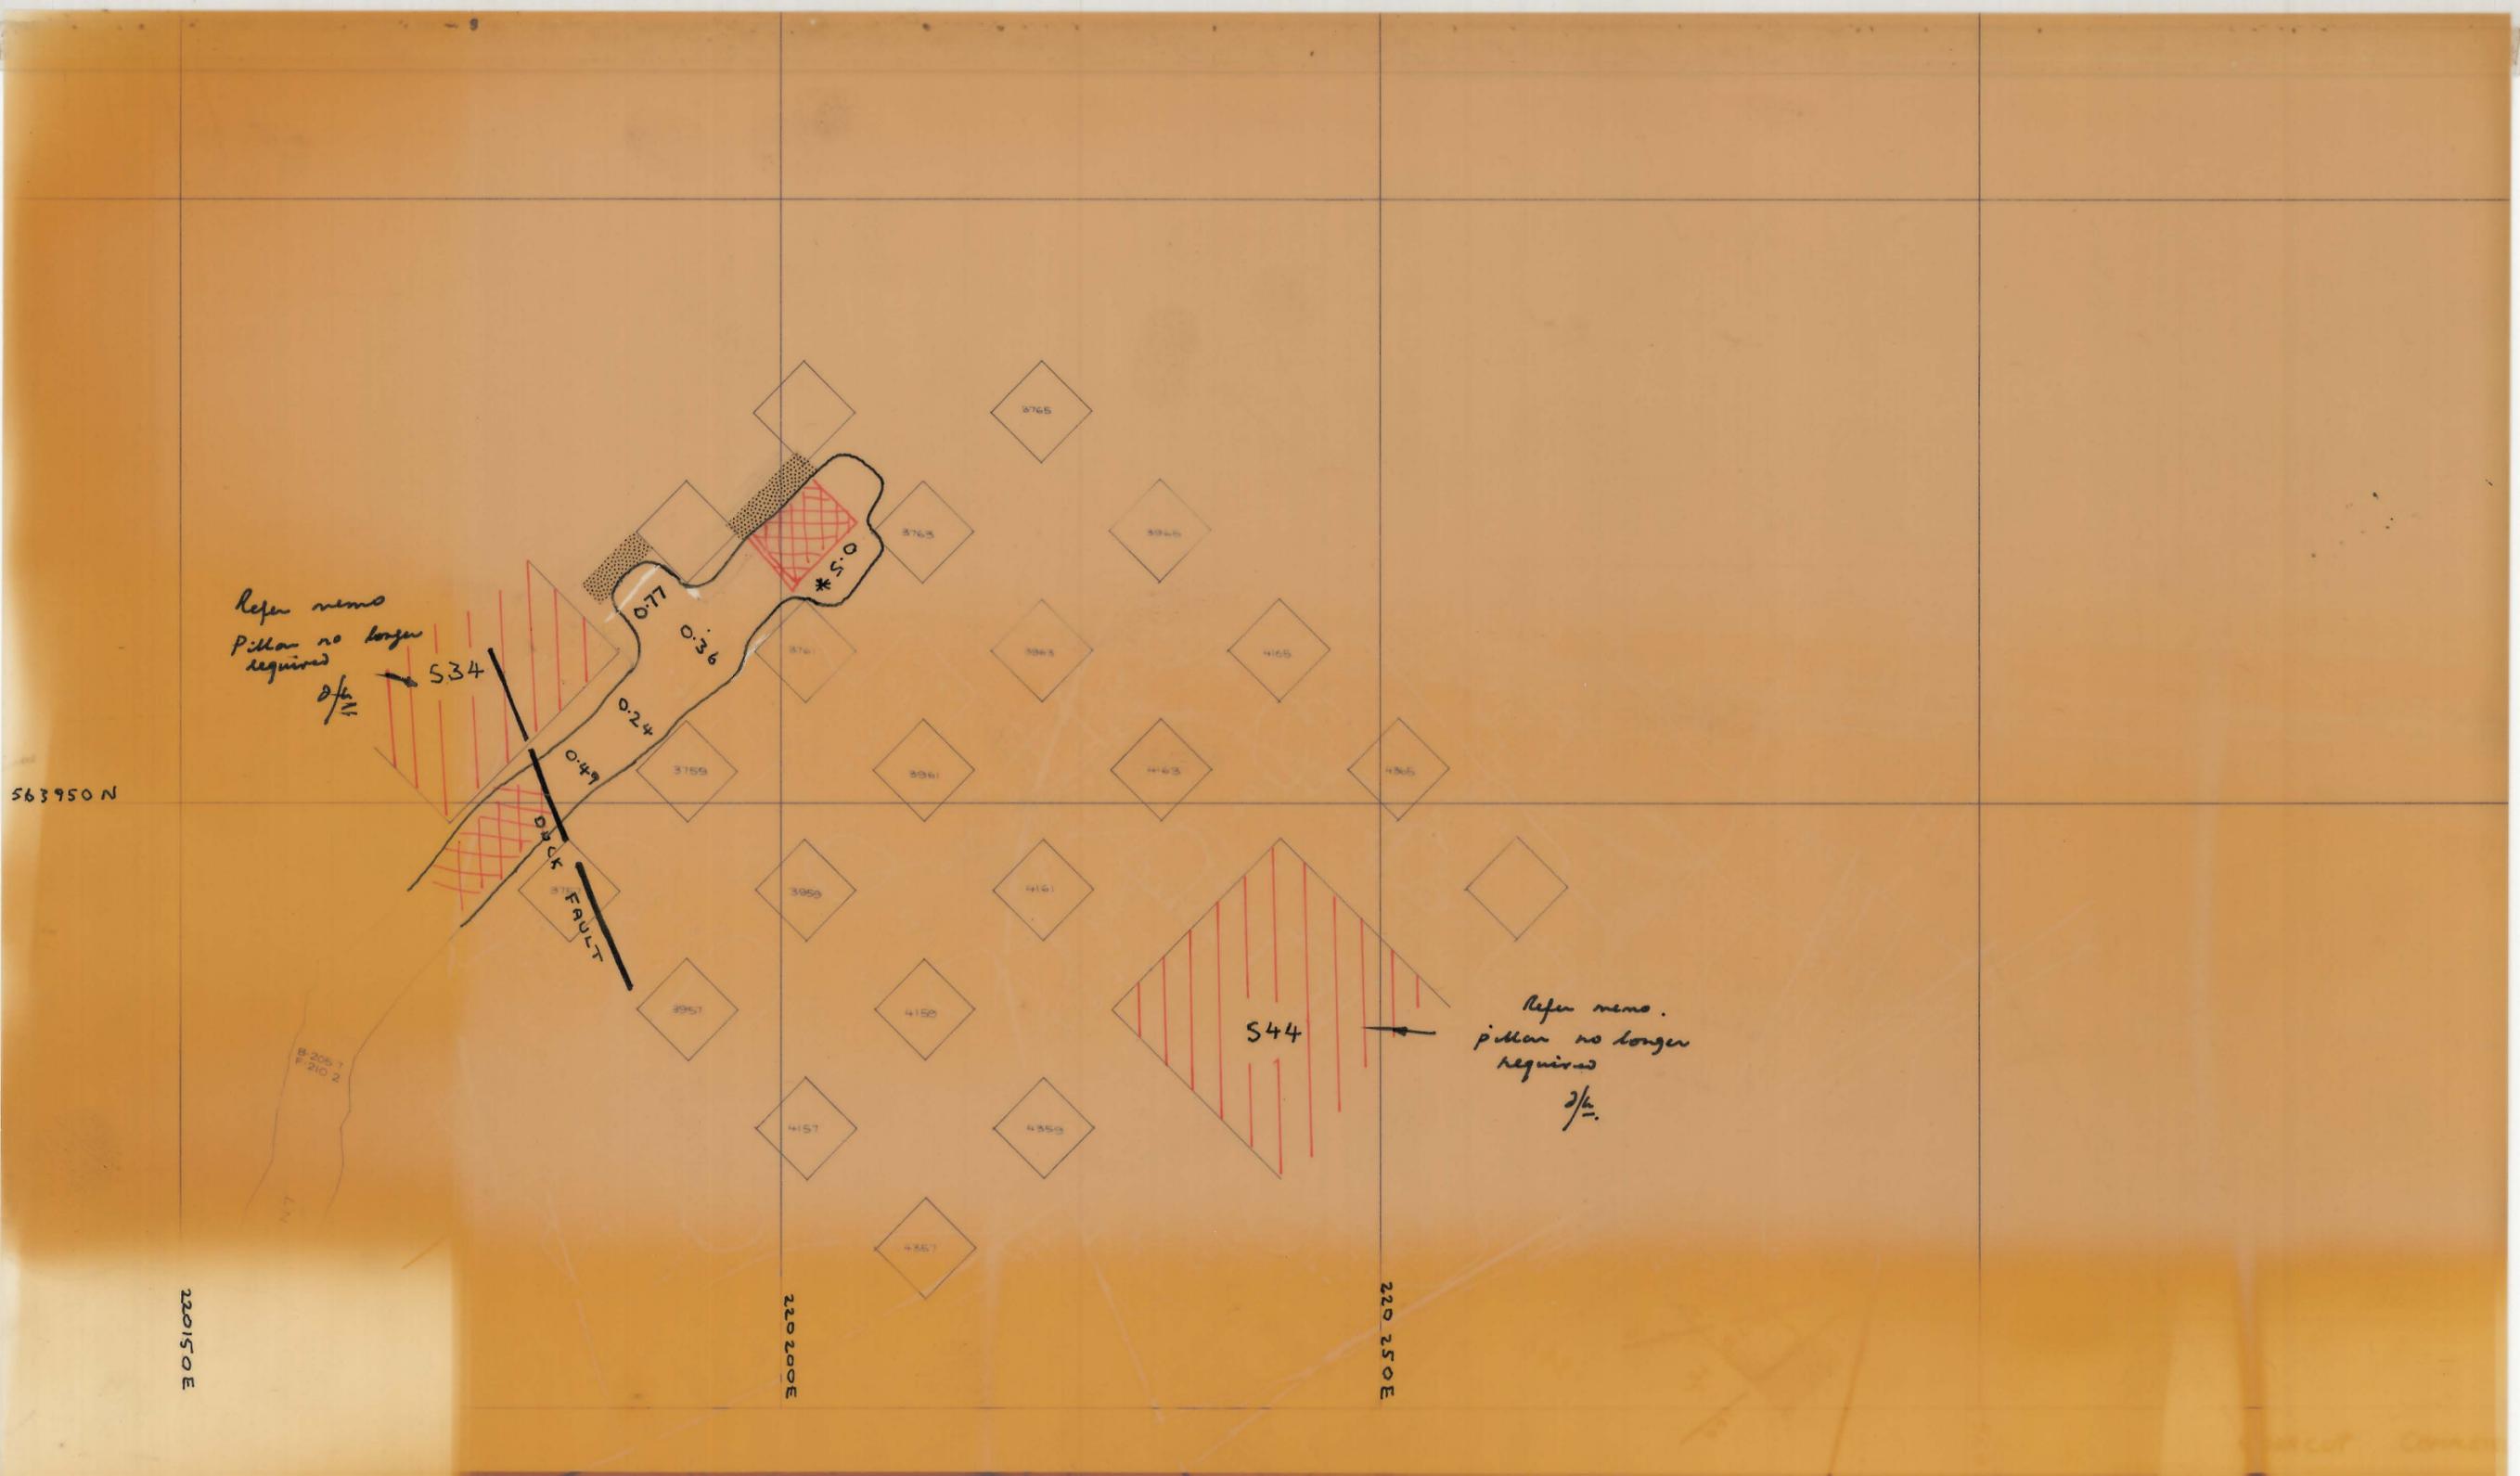


563950 N

220150 E

220200 E

220250 E

SCALE 1: 500

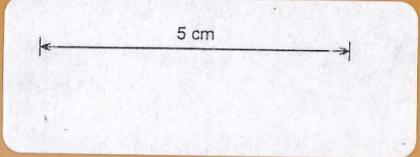

Lift N° 3

0374_1072

LOCATION
SOUTH AFRICA
SUBJECT
LOWER PIT STOPE
- 215m CONTOUR

north

* LAMP VALUE
 MINING LIMIT
 QUOTE
 VALUE