


104 - 109

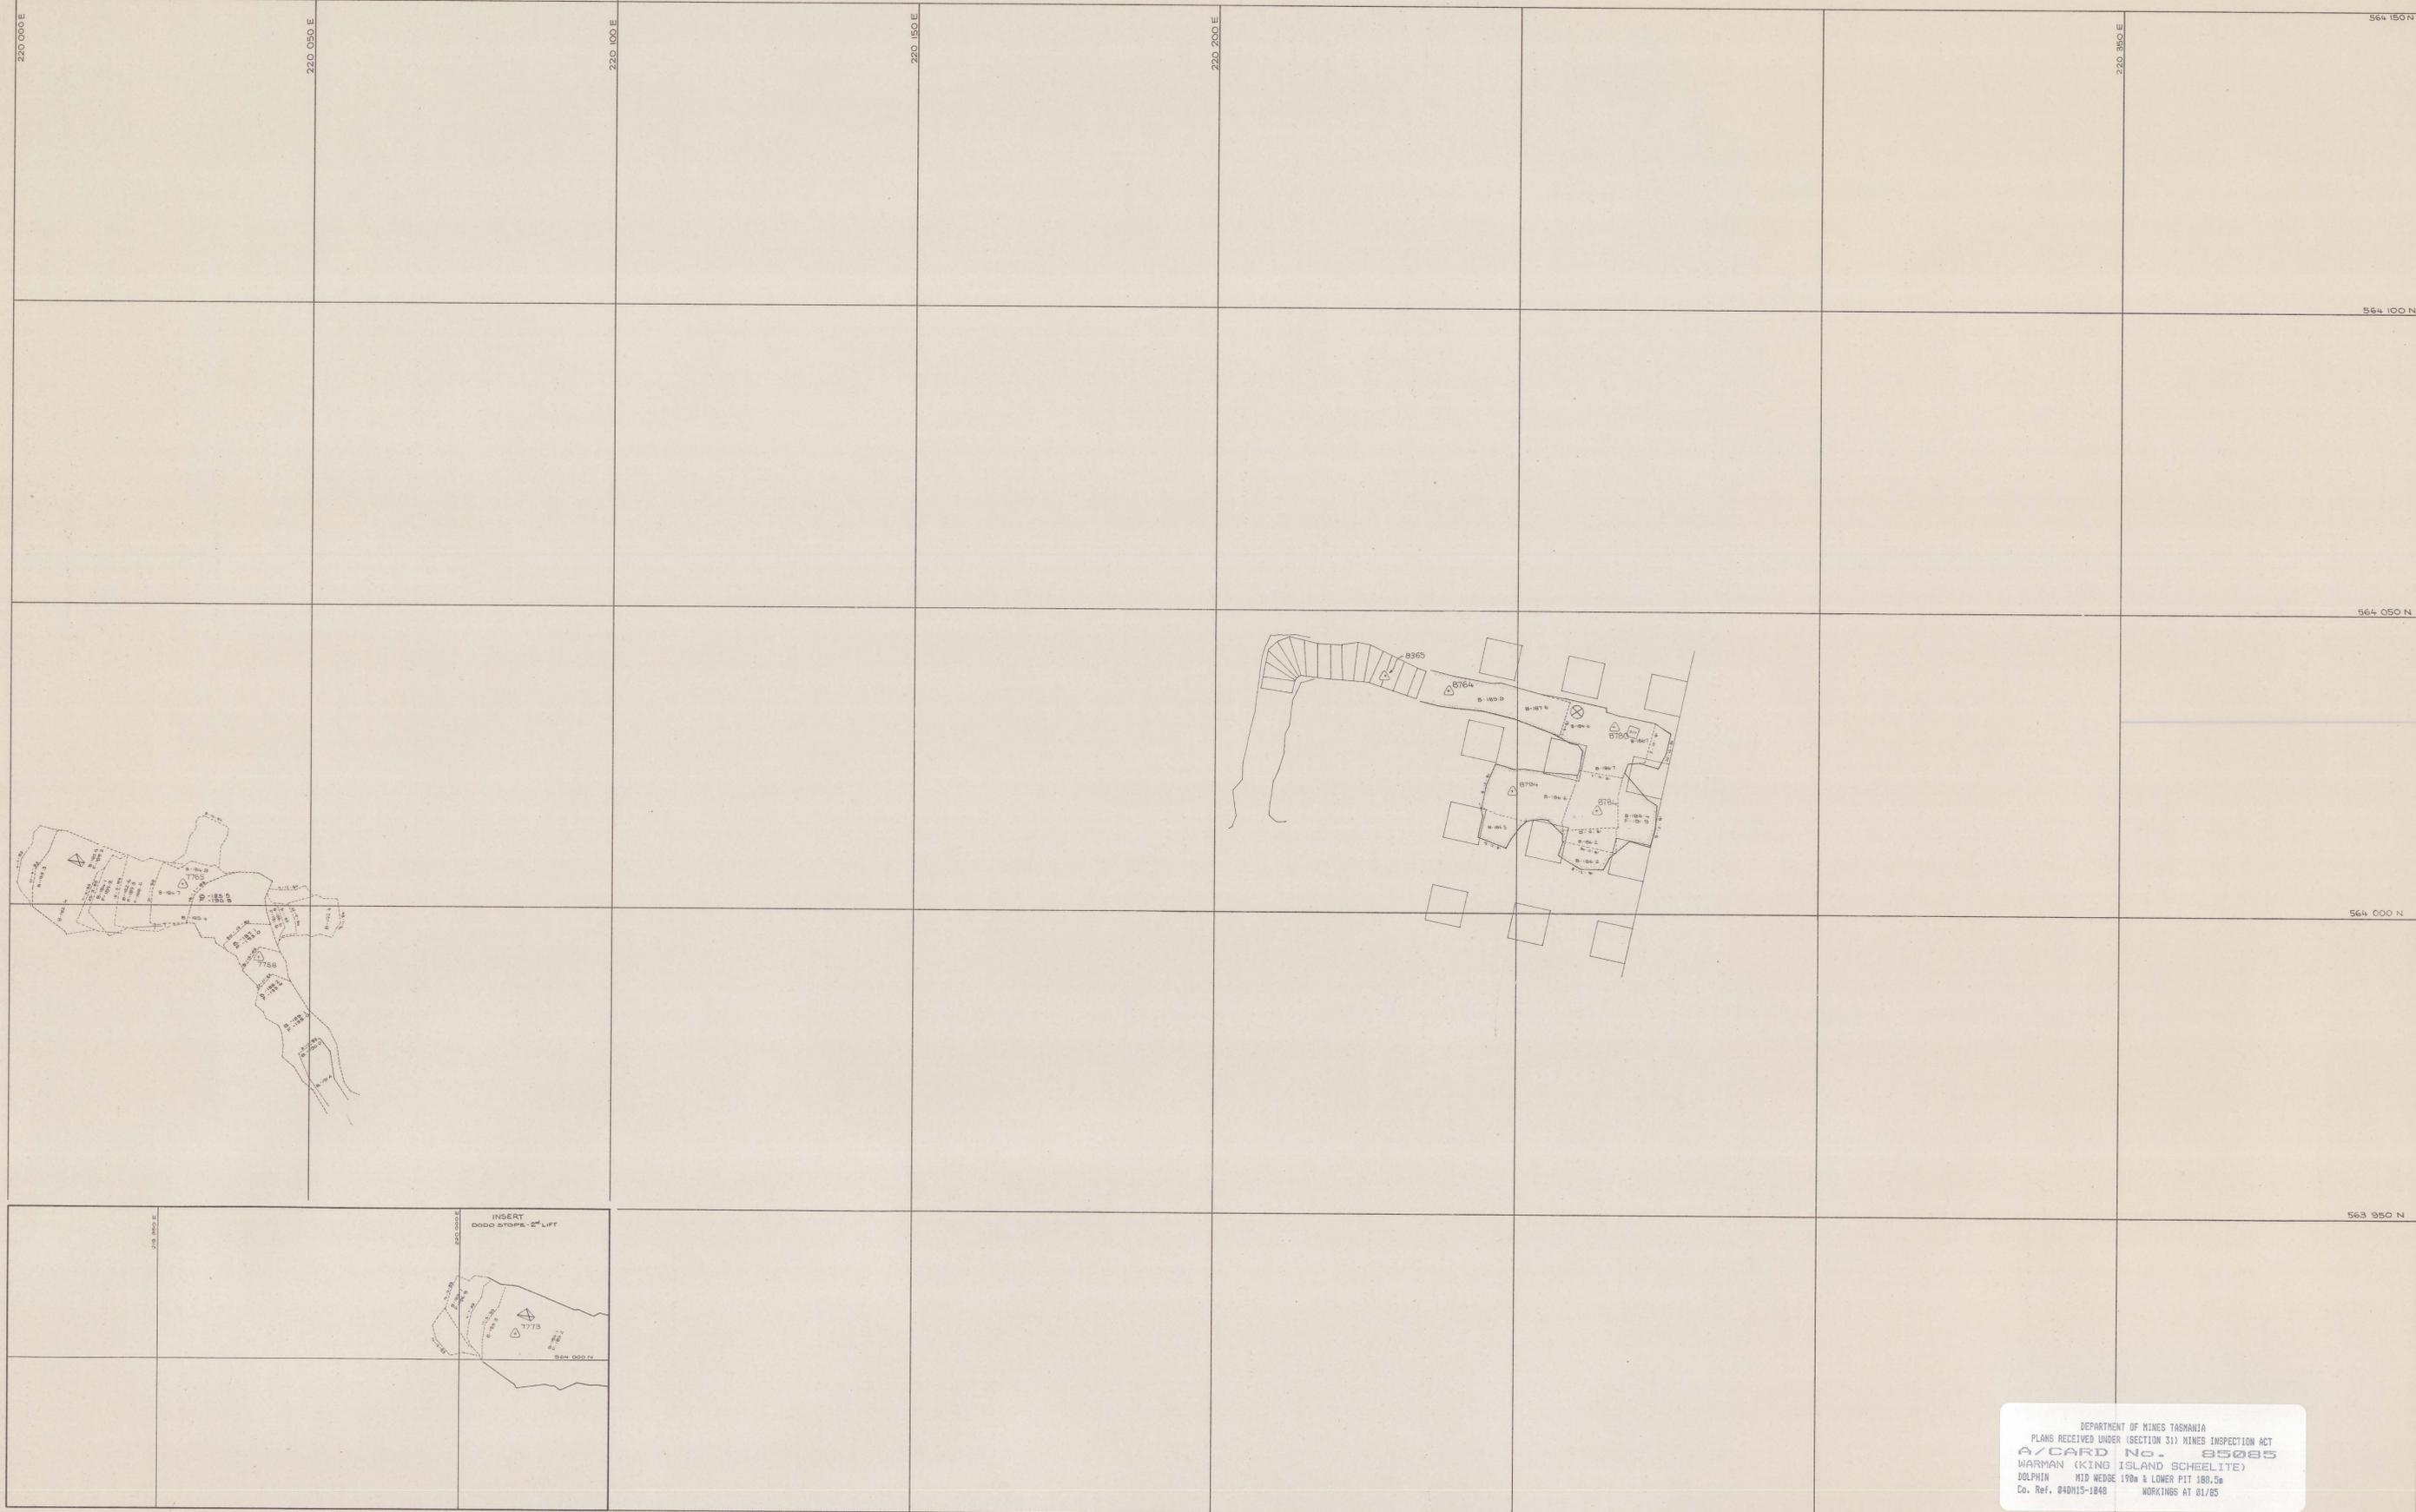

DEPARTMENT OF MINES TASMANIA  
 PLANS RECEIVED UNDER (SECTION 31) MINES INSPECTION ACT  
 CARD No. 85085  
 WARMAN (KING ISLAND SCHEELITE)  
 DOLPHIN MID WEDGE 190m & LOWER PIT 188.5m  
 Co. Ref. 04DM15-1048 WORKINGS AT 01/05

SCALE 1: 500 LOWER PIT STOPE      LIFT 11 MID WEDGE SOUTH      LIFT 3 MID WEDGE NORTH      UNDERCUT.		LOCATION DOLPHIN MINE	
		SUBJECT MID WEDGE - 190 m CONTOUR LOWER PIT - 188.5m CONTOUR	