


0374-110

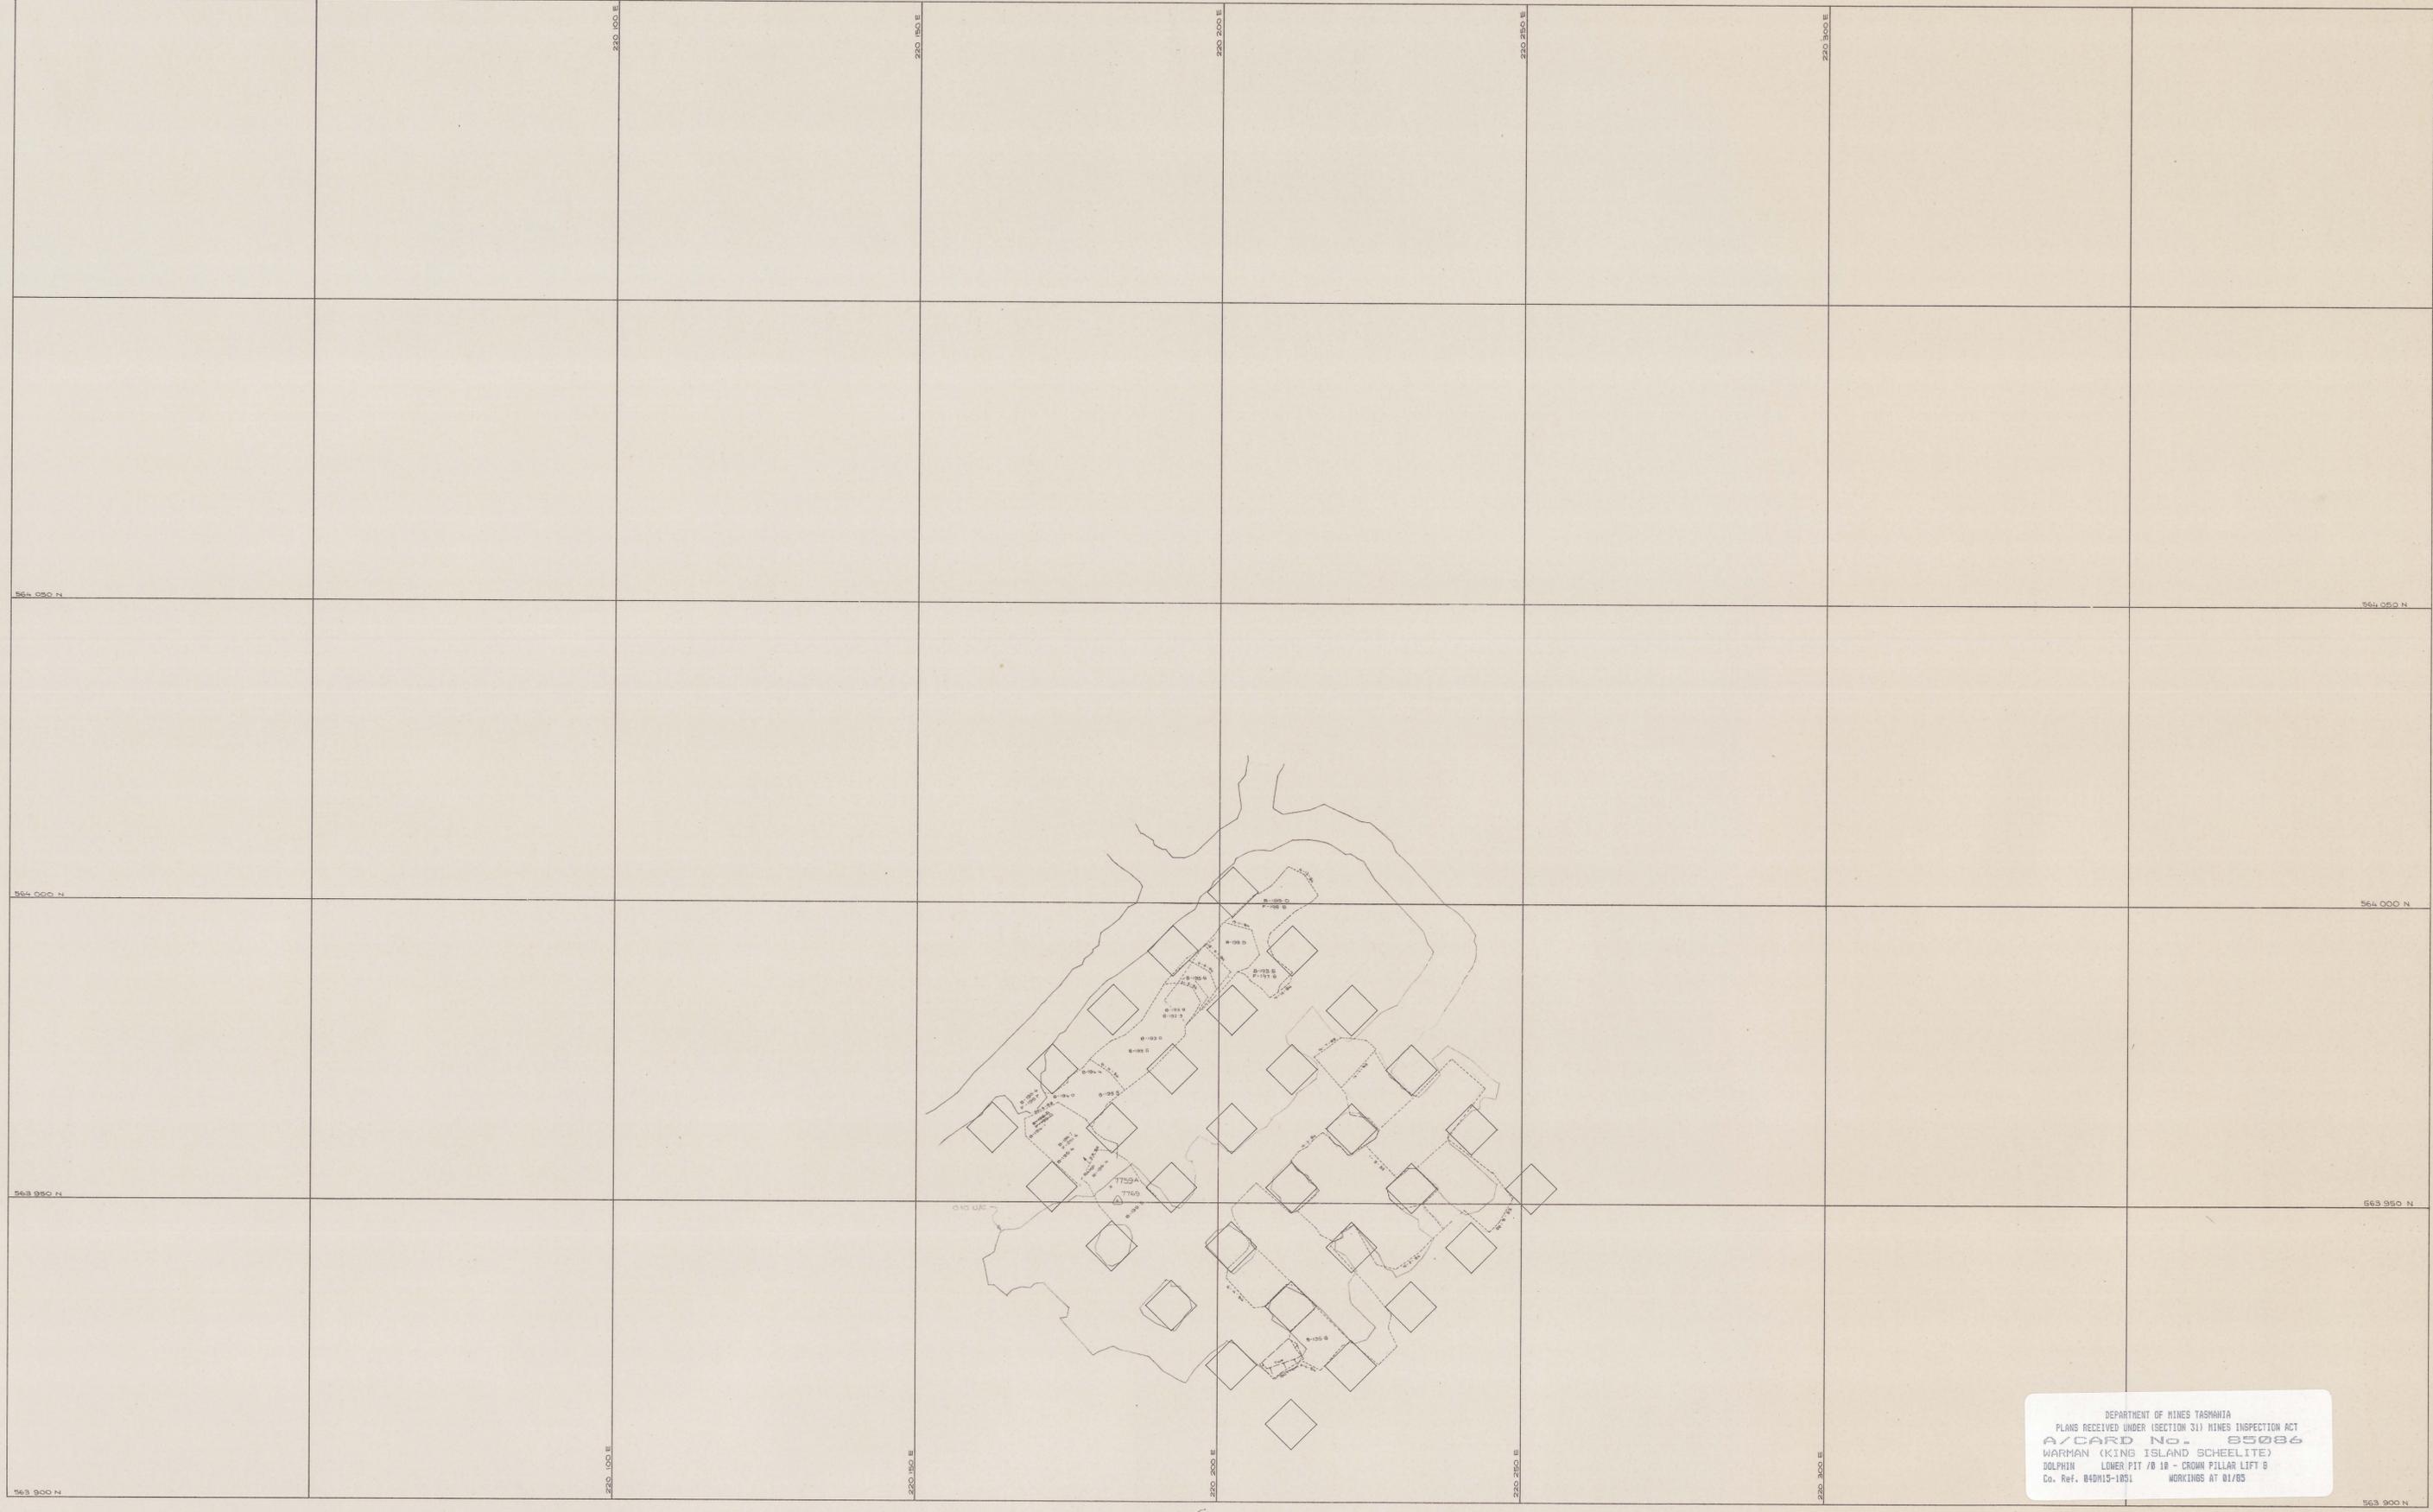

DEPARTMENT OF MINES TASMANIA
 PLANS RECEIVED UNDER (SECTION 31) MINES INSPECTION ACT
 A/CARD No. 85086
 WARMAN (KING ISLAND SCHEELITE)
 DOLPHIN LOWER PIT / O 10 - CROWN PILLAR LIFT 8
 Co. Ref. 04DM15-1051 WORKINGS AT 01/85

| | | | | |
|--|--------------|--|--|---|
| | SCALE 1: 500 | | LOCATION DOLPHIN MINE | KING ISLAND SCHEELITE <small>A DIVISION OF WARMAN INTERNATIONAL</small> |
| | | | SUBJECT LOWER PIT/O 10 - CROWN PILLAR Lift 8 | |