


0374-111

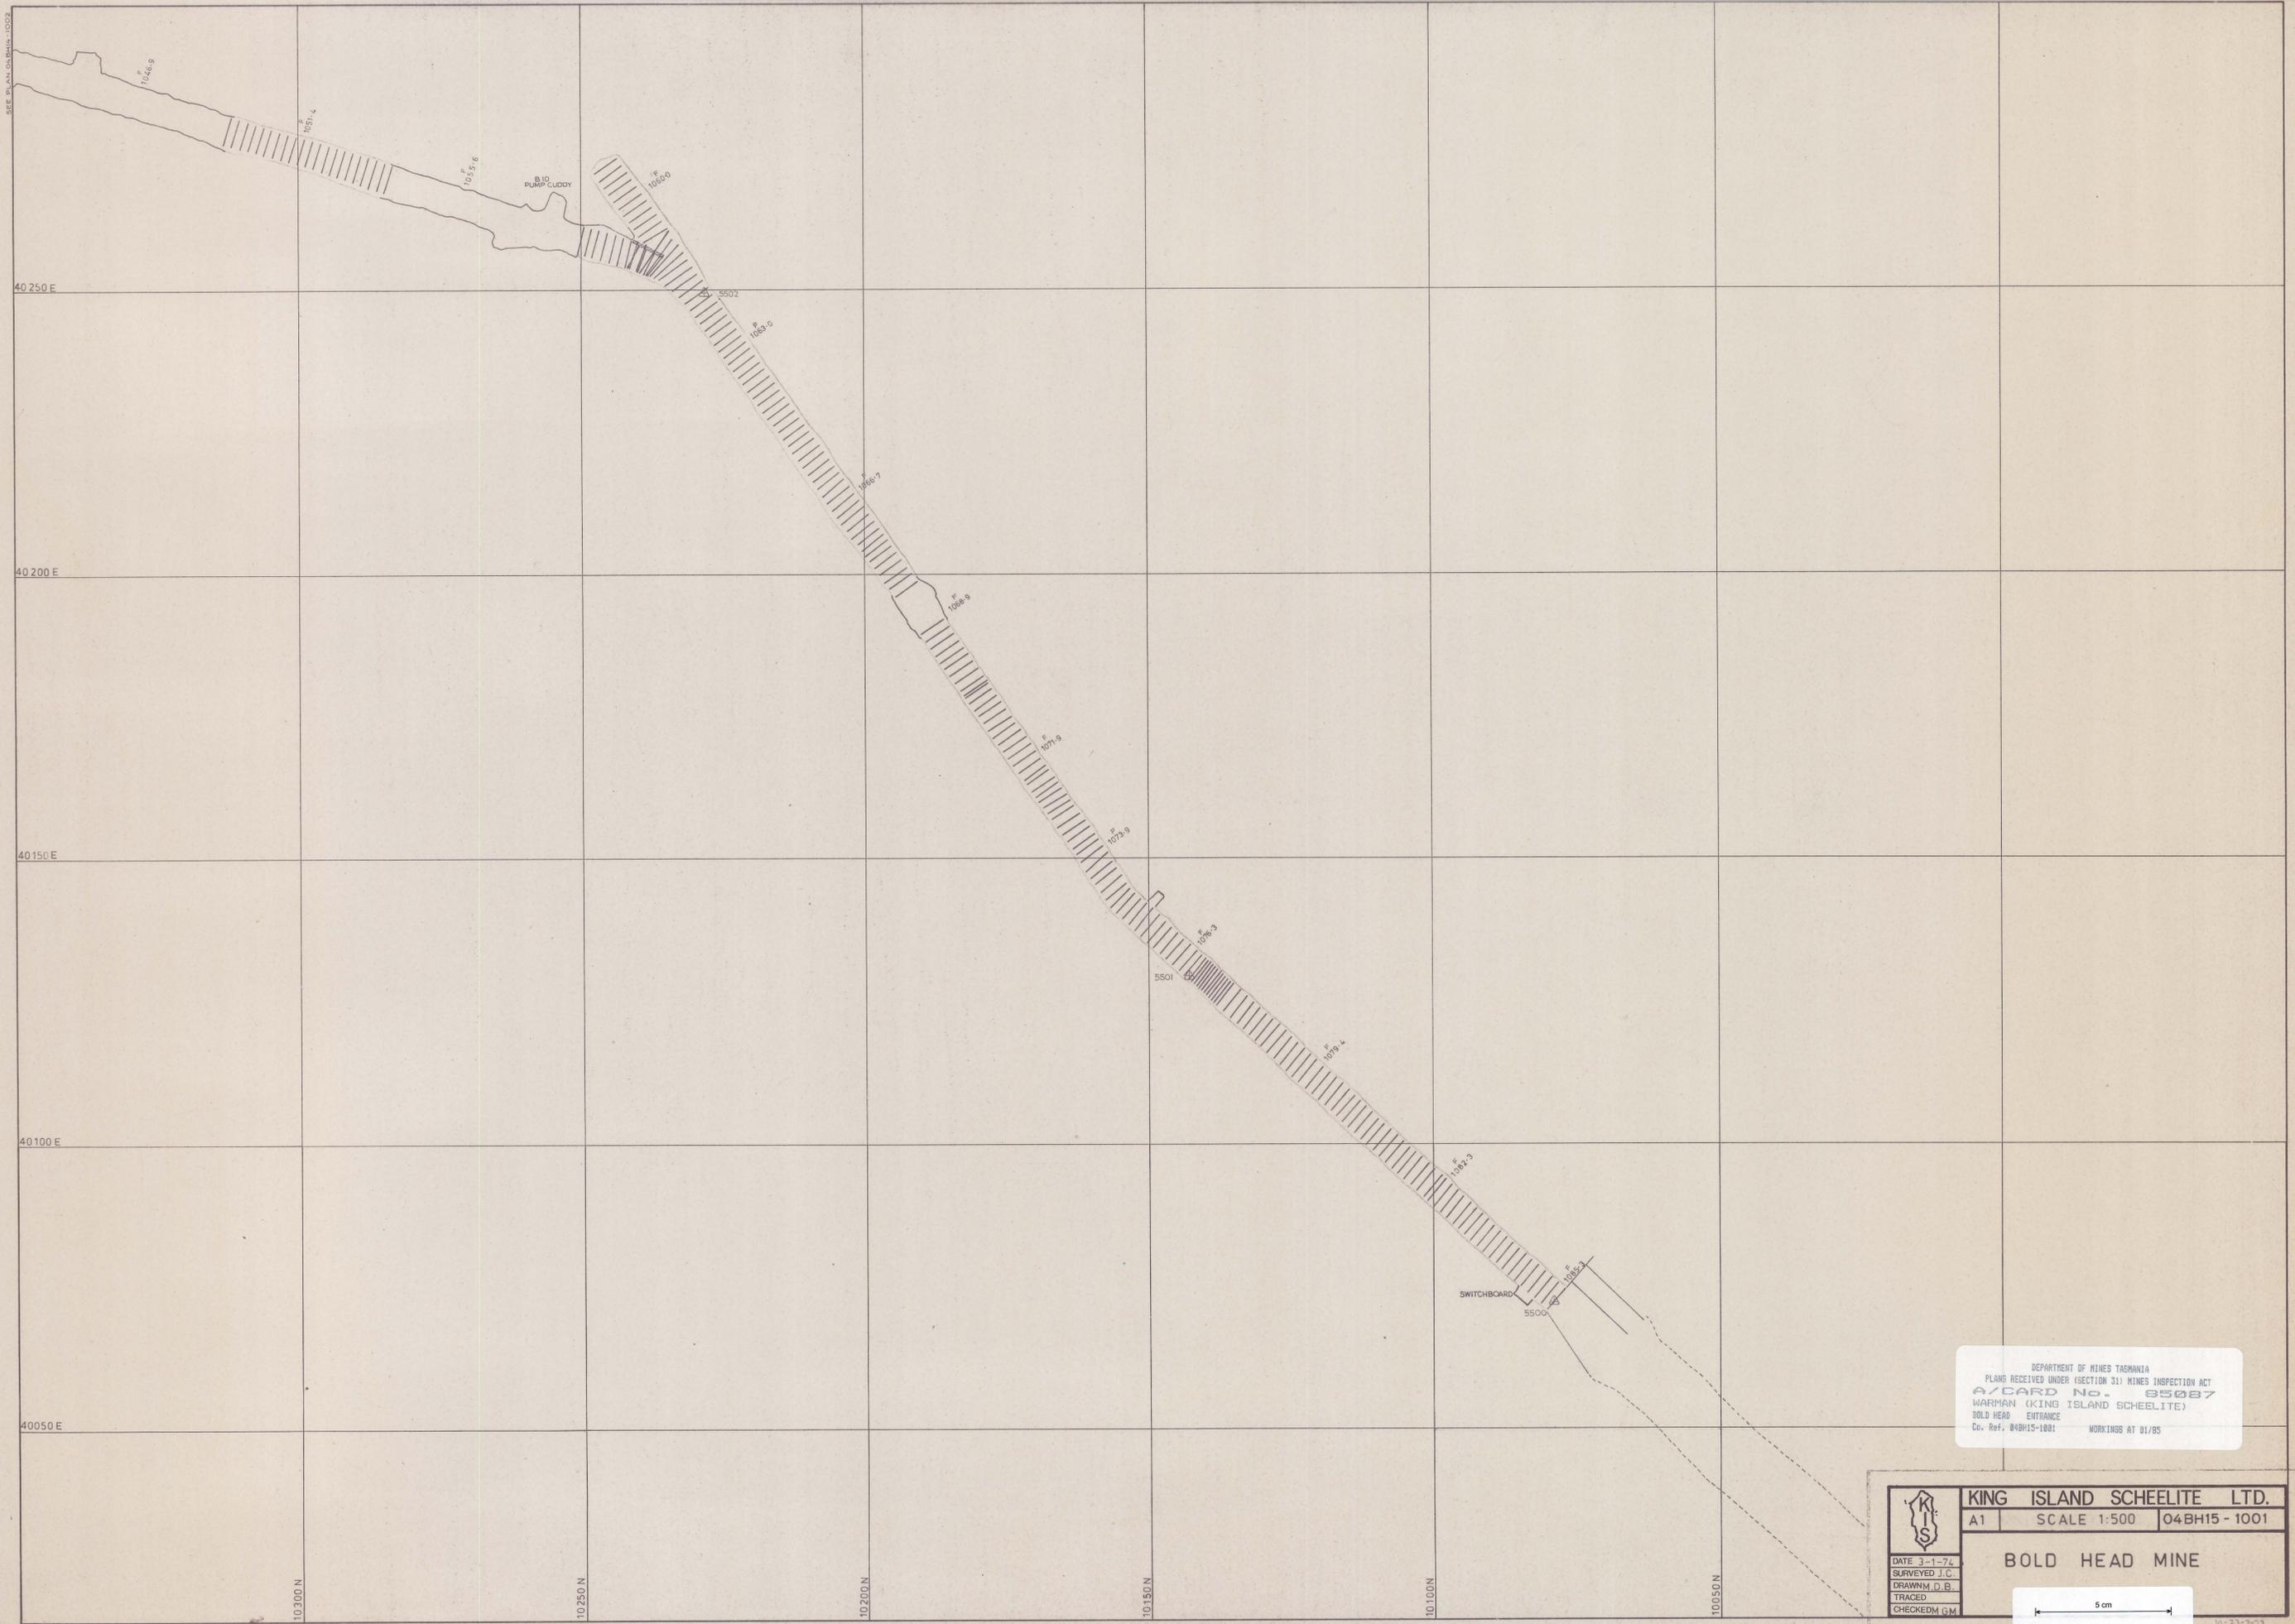

DEPARTMENT OF MINES TASMANIA
 PLANS RECEIVED UNDER (SECTION 31) MINES INSPECTION ACT
 A/CARD No. 85087
 WARMAN (KING ISLAND SCHEELITE)
 BOLD HEAD ENTRANCE
 Co. Ref. 04BH15-1001 WORKINGS AT 01/85

 DATE 3-1-74 SURVEYED J.C. DRAWN D.B. TRACED CHECKED M.G.M.	KING ISLAND SCHEELITE LTD.	
	A1	SCALE 1:500
BOLD HEAD MINE		
		