
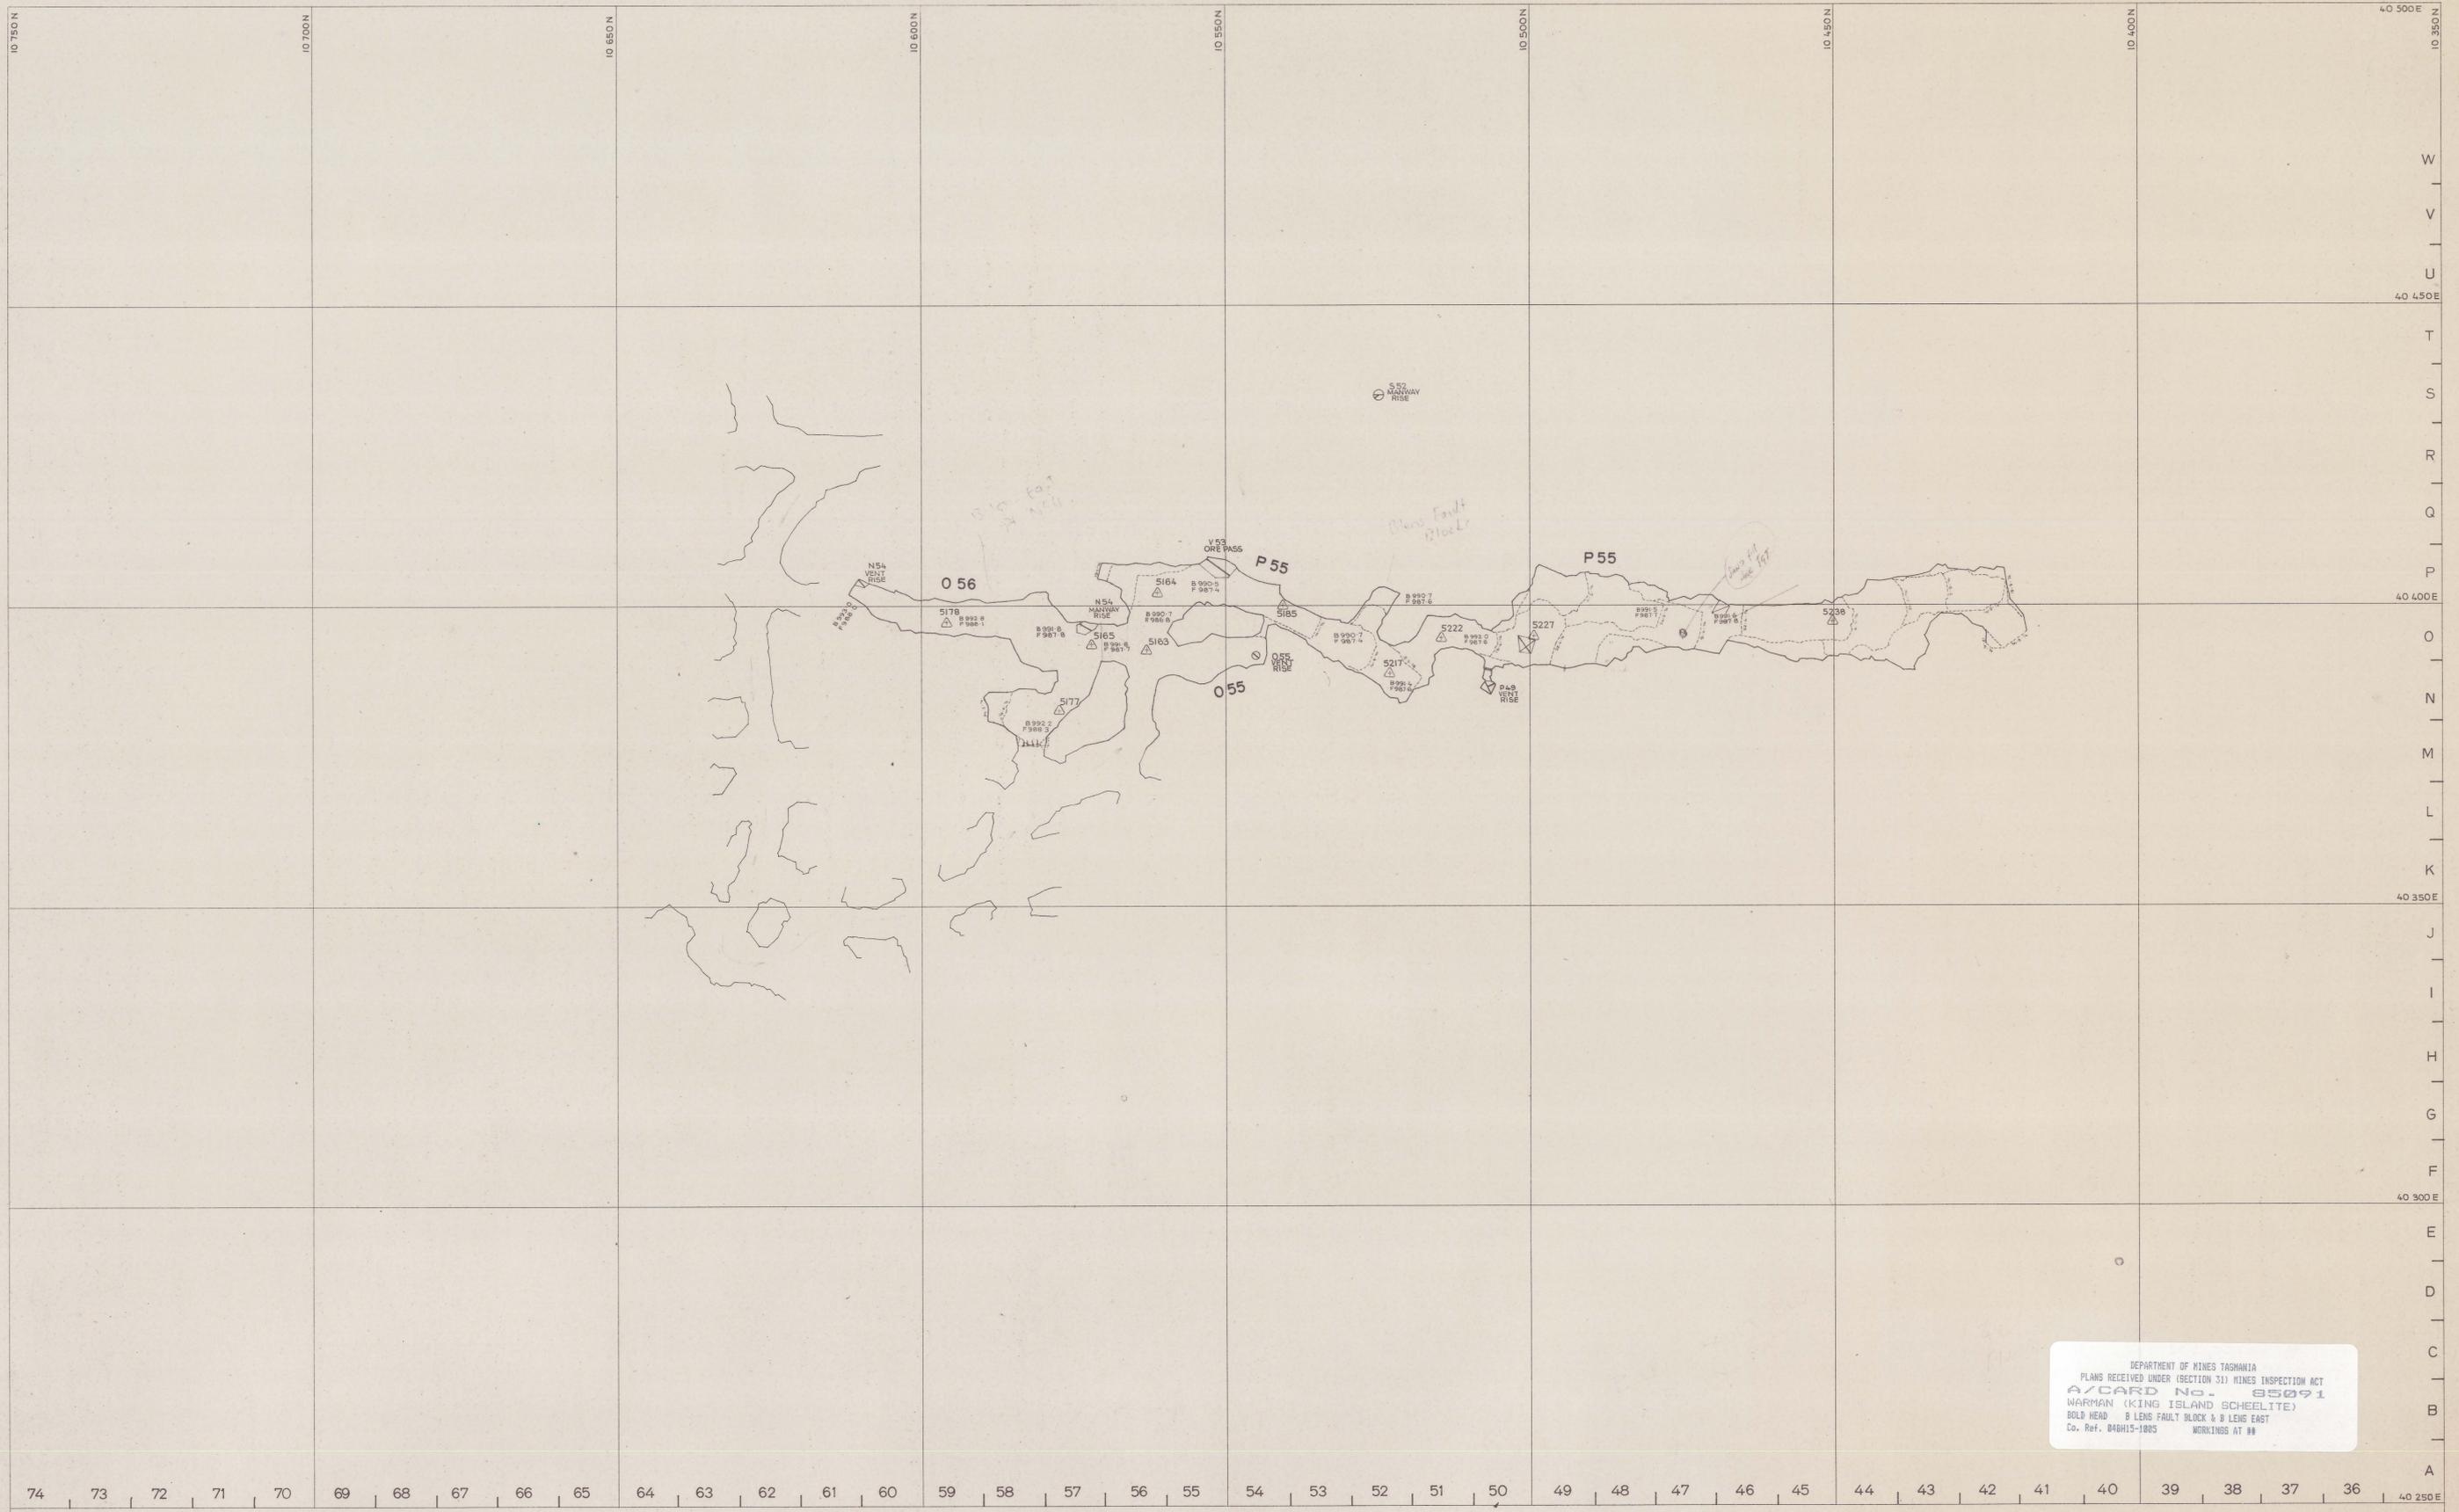


0374 - 115

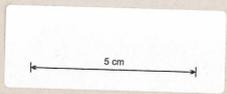

DEPARTMENT OF MINES TASMANIA
 PLANS RECEIVED UNDER (SECTION 31) MINES INSPECTION ACT
 A/CARD No. 85091
 WARMAN (KING ISLAND SCHEELITE)
 BOLD HEAD B LENS FAULT BLOCK & B LENS EAST
 Co. Ref. 04BH15-1005 WORKINGS AT ##

74 73 72 71 70 69 68 67 66 65 64 63 62 61 60 59 58 57 56 55 54 53 52 51 50 49 48 47 46 45 44 43 42 41 40 39 38 37 36 40 250 E

SCALE 1:500		LOCATION	BOLD HEAD MINE
		SUBJECT	B LENS FAULT BLOCK & B LENS EAST
north		PLAN NUMBER	04BH14 - 1005
		 <small>A DIVISION OF WARMAN INTERNATIONAL</small> GRASBY KING ISLAND	