


0374-118

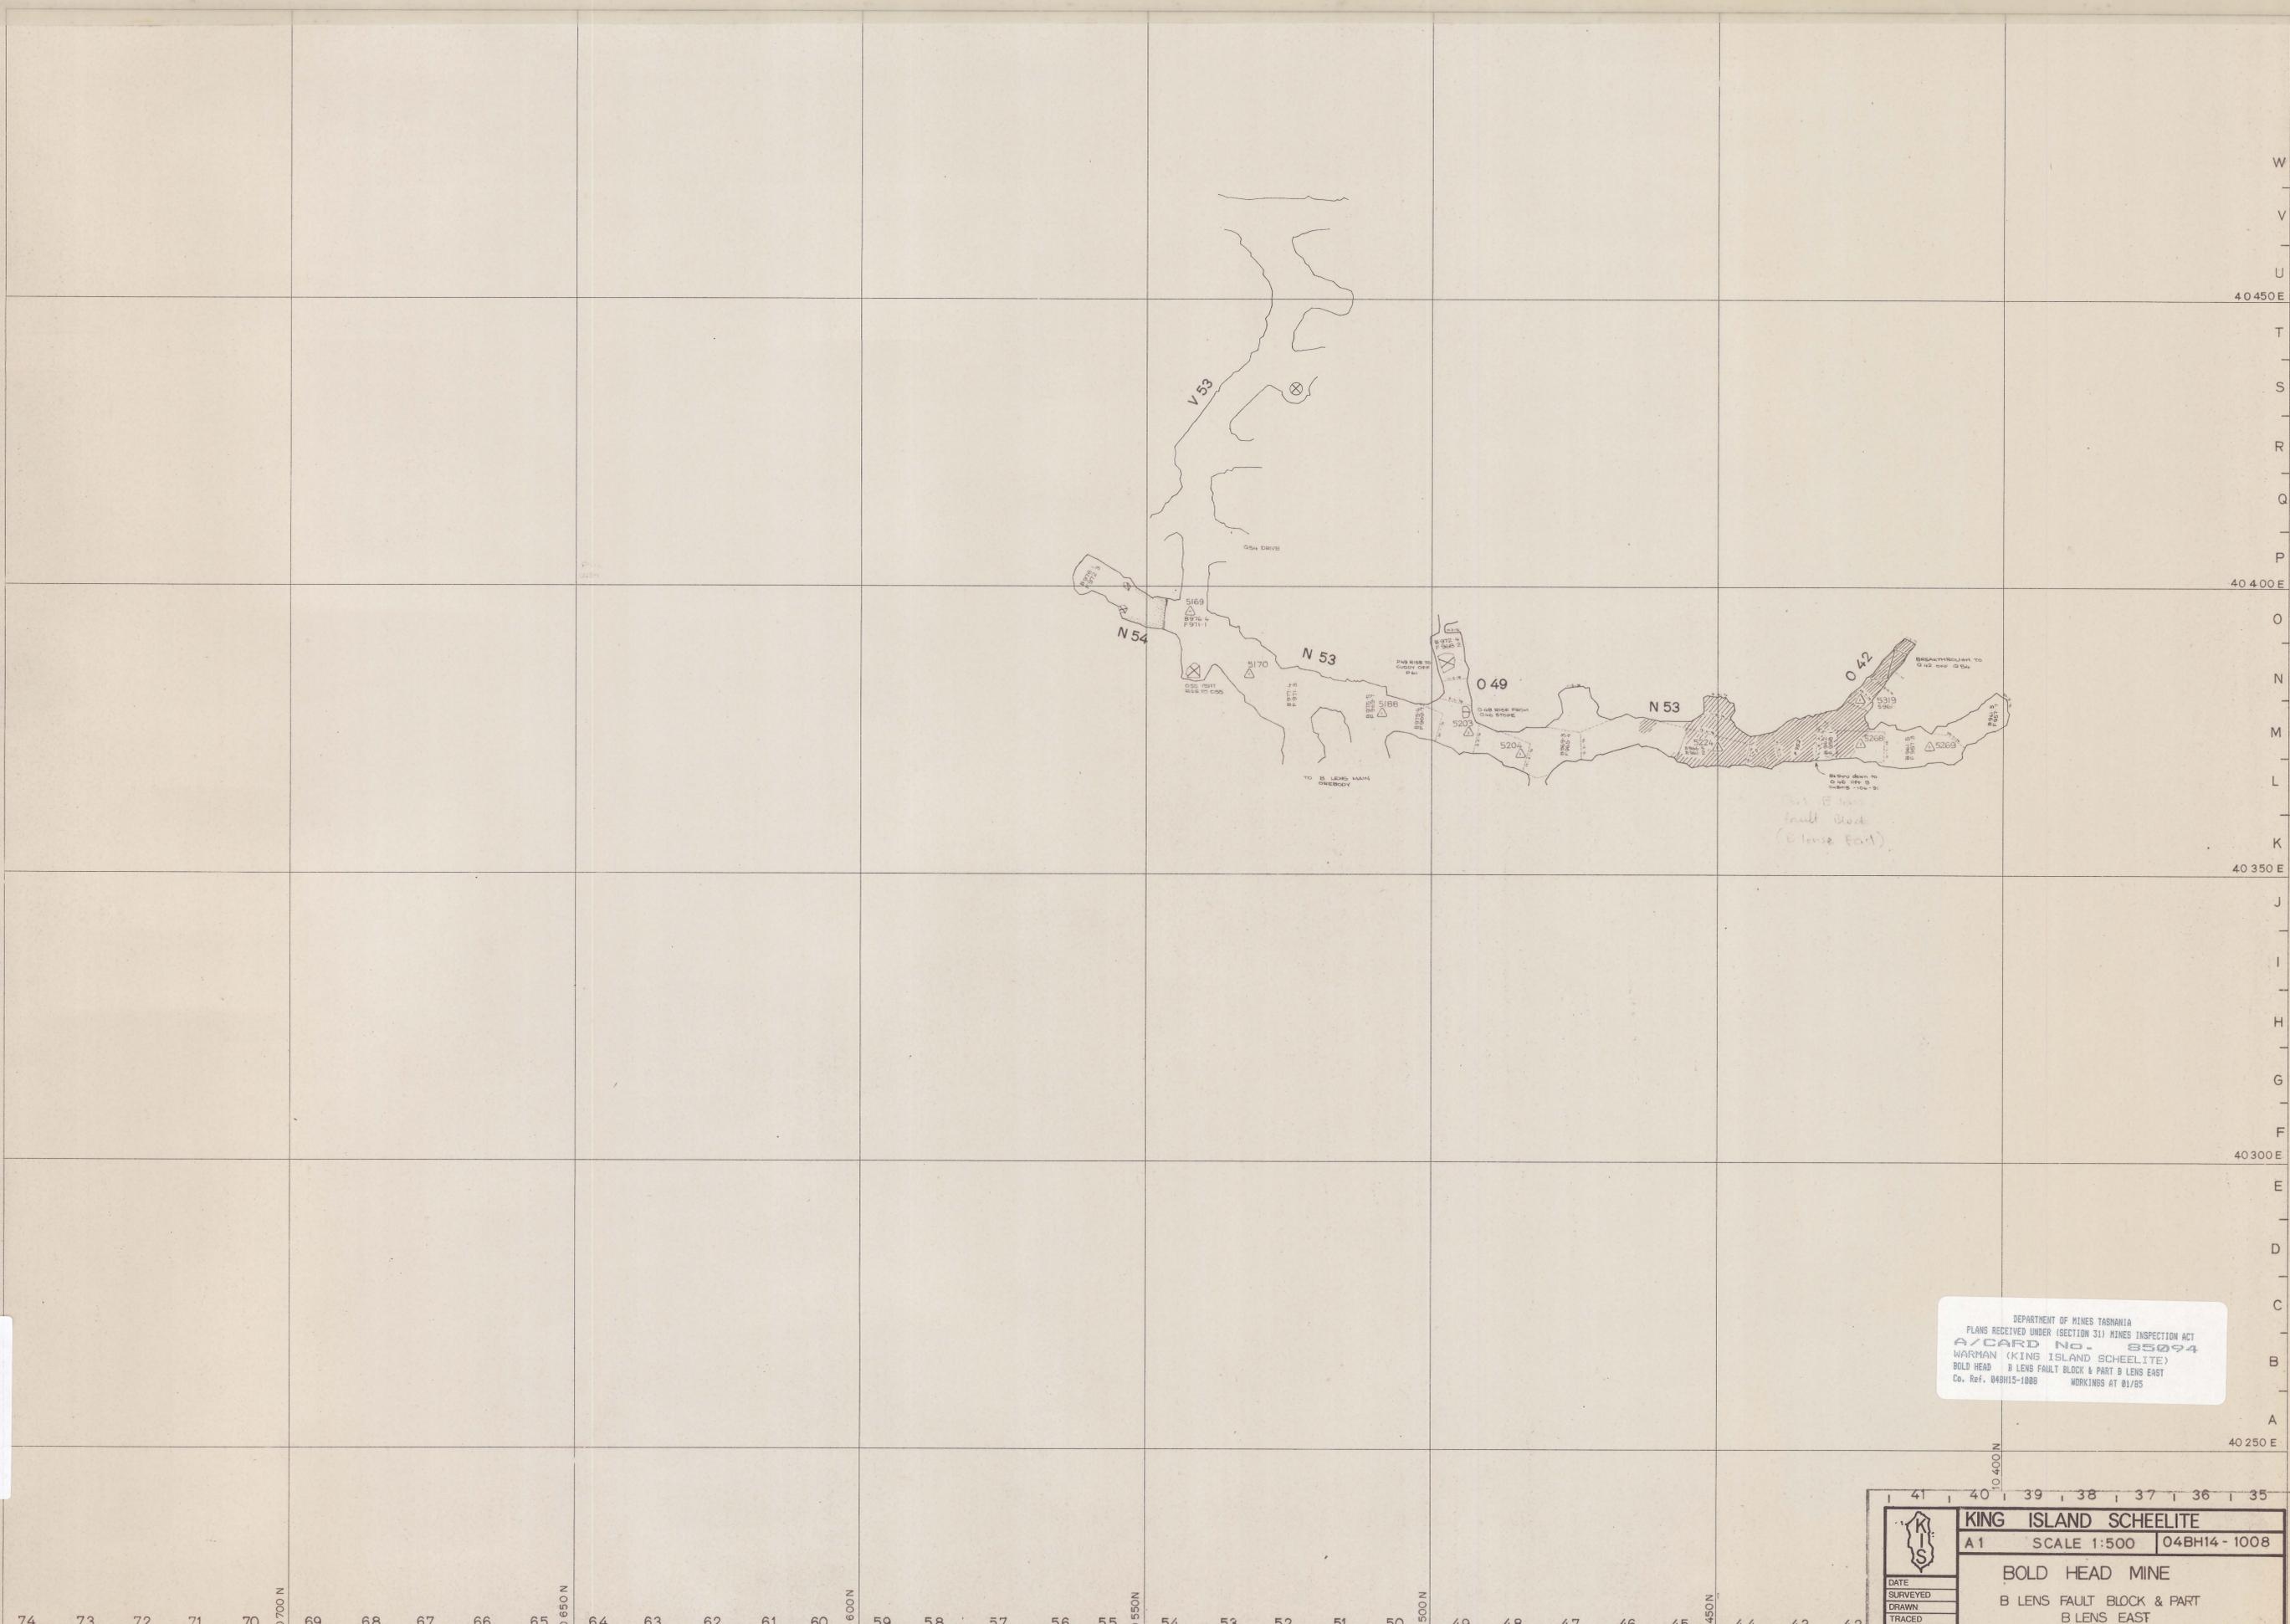

W
V
U
40 450 E
T
S
R
Q
P
40 400 E
O
N
M
L
K
40 350 E
J
I
H
G
F
40 300 E
E
D
C
B
A
40 250 E

DEPARTMENT OF MINES TASMANIA
PLANS RECEIVED UNDER (SECTION 31) MINES INSPECTION ACT
A/CARD No. 85094
WARMAN (KING ISLAND SCHEELITE)
BOLD HEAD B LENS FAULT BLOCK & PART B LENS EAST
Co. Ref. 84BH15-1008 WORKINGS AT 01/85

	KING ISLAND SCHEELITE	
	A1	SCALE 1:500 04BH14-1008
BOLD HEAD MINE		
B LENS FAULT BLOCK & PART		
B LENS EAST		
DATE		
SURVEYED		
DRAWN		
TRACED		
CHECKED		

5m

74 73 72 71 70 10 700 N 69 68 67 66 65 10 650 N 64 63 62 61 60 10 600 N 59 58 57 56 55 10 550 N 54 53 52 51 50 10 500 N 49 48 47 46 45 10 450 N 44 43 42

10 400 N