



0374 - 119

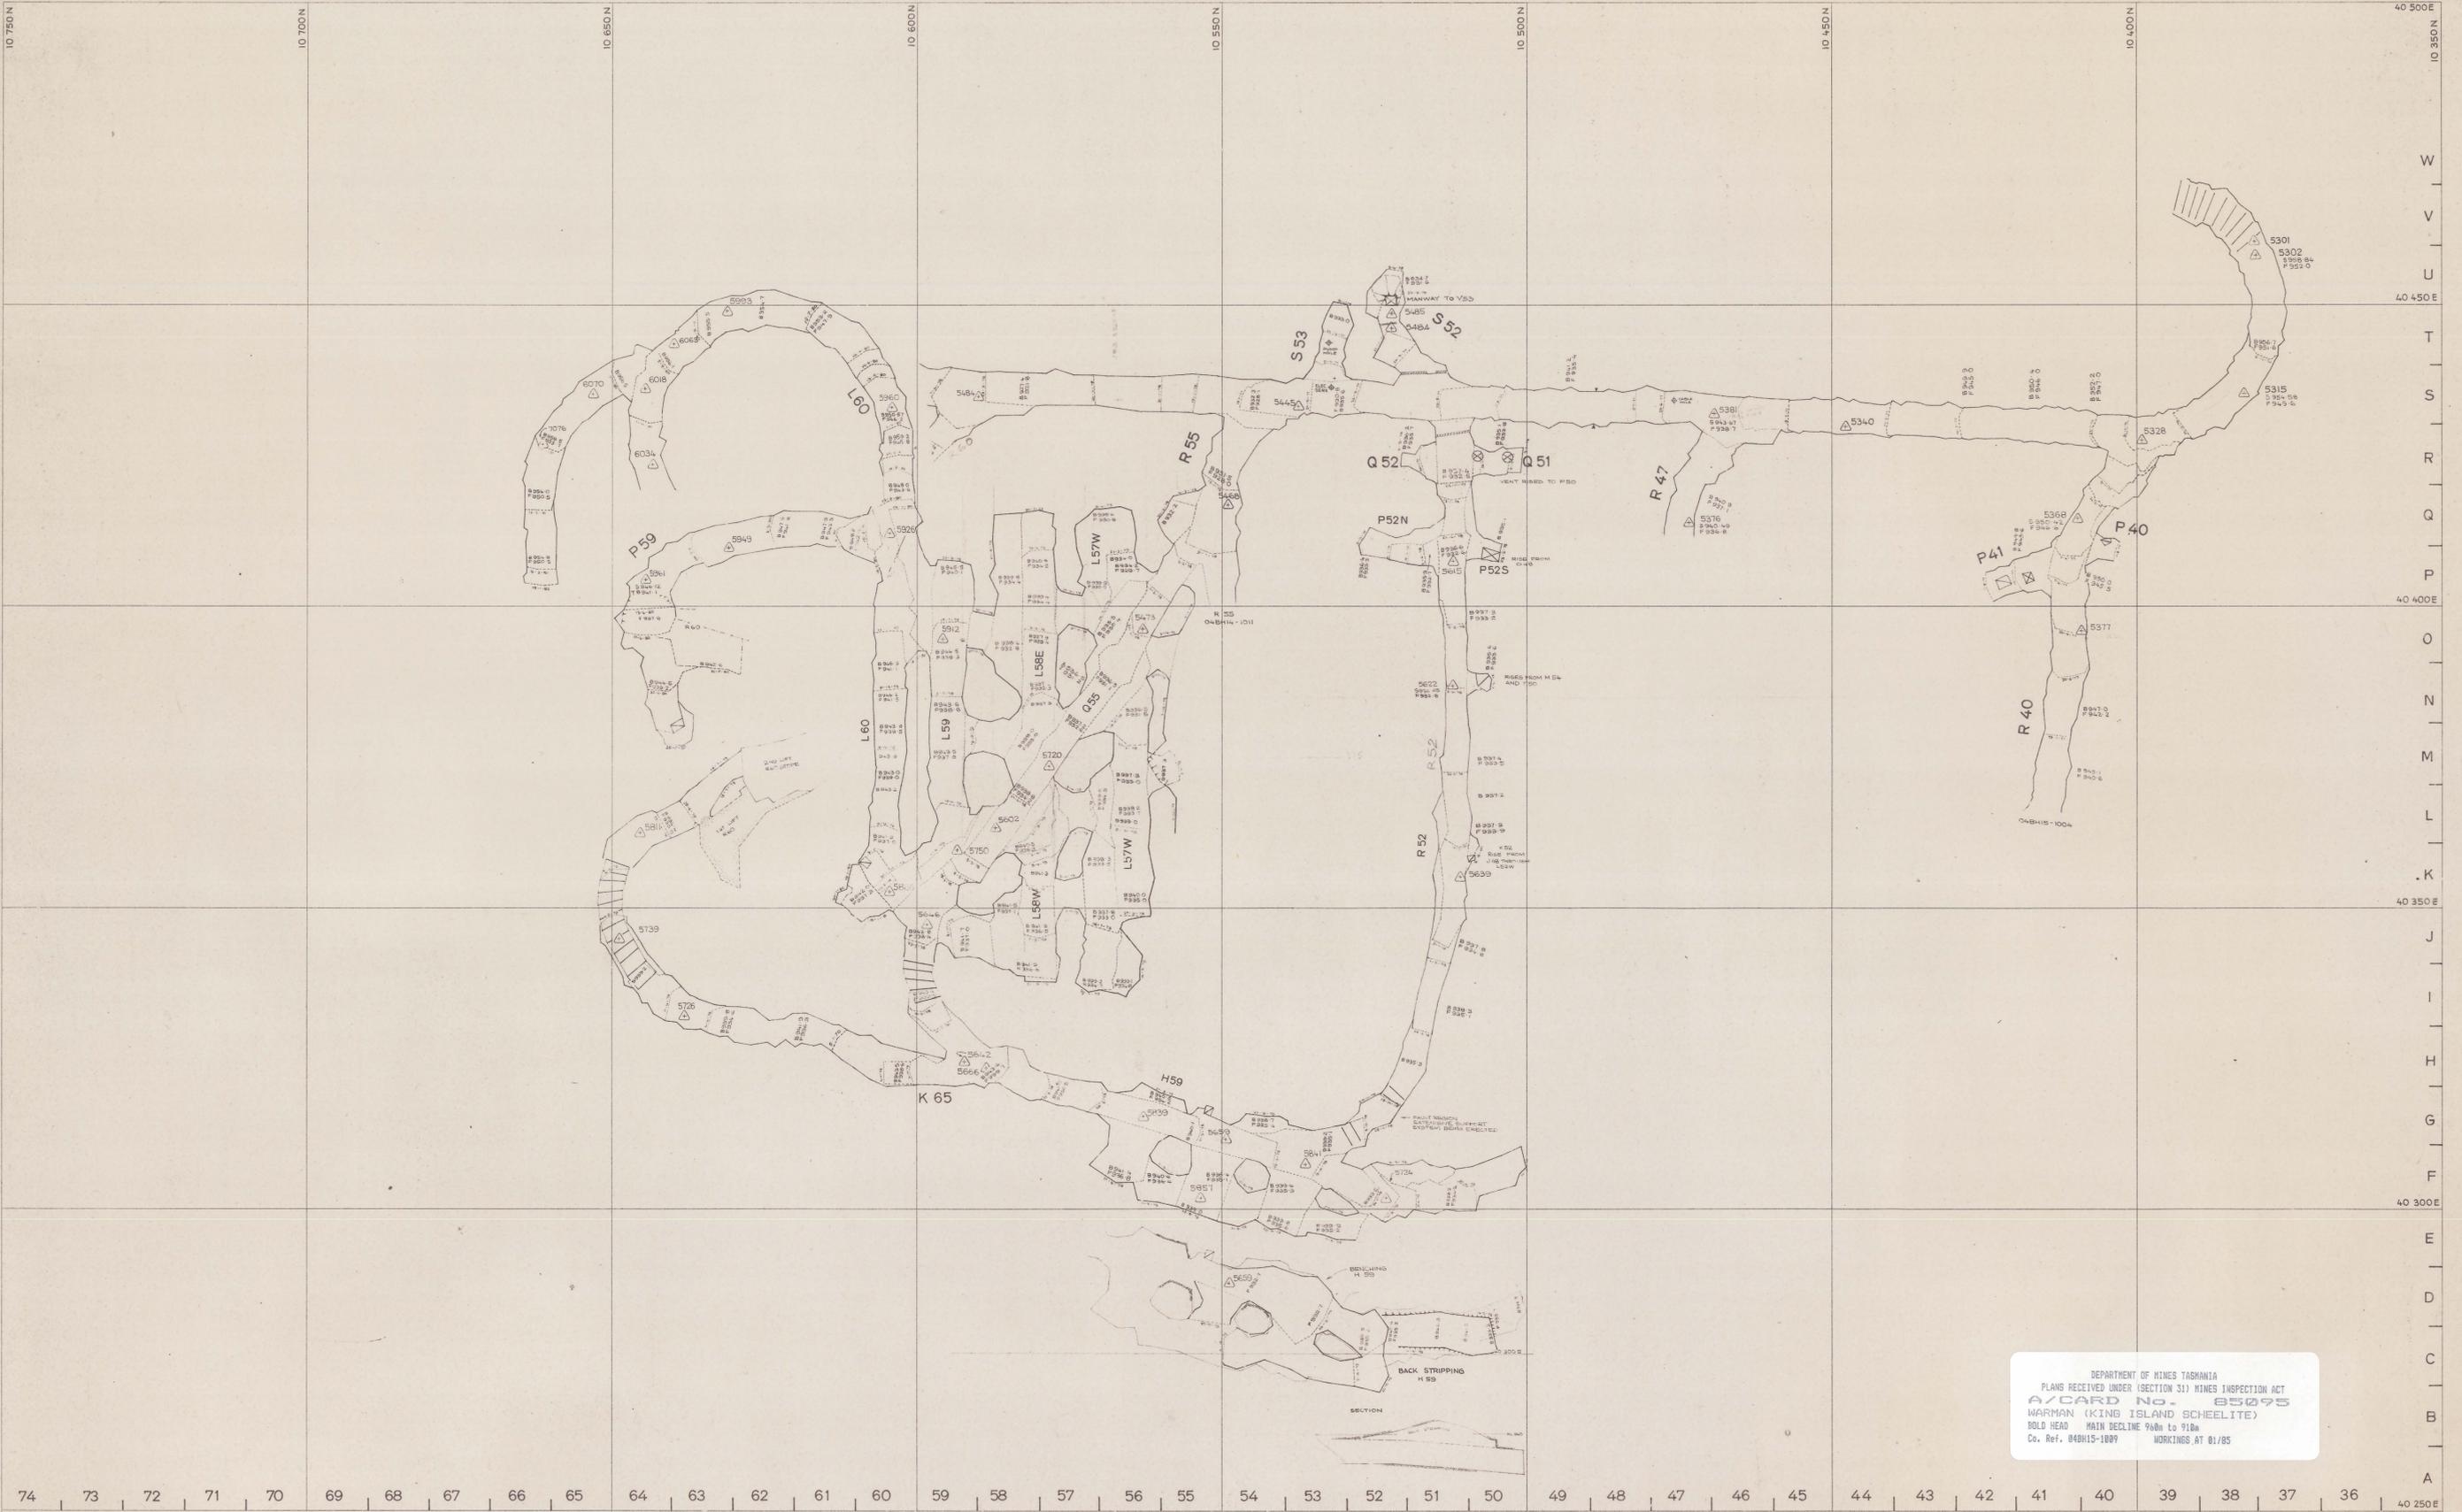

DEPARTMENT OF MINES TASMANIA
 PLANS RECEIVED UNDER (SECTION 31) MINES INSPECTION ACT
 A/CARD No. 85095
 WARMAN (KING ISLAND SCHEELITE)
 BOLD HEAD MAIN DECLINE 96m to 91m
 Co. Ref. 04BH15-1009 WORKINGS AT 01/85

SCALE 1:500

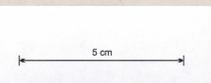

north

BOLD HEAD MINE

MAIN DECLINE

960 m to 910 m Back R.L.

KIS KING ISLAND SCHEELITE
A DIVISION OF WARMAN INTERNATIONAL

GRASSY KING ISLAND

PLAN NUMBER
04BH14 - 1009