


0374-120

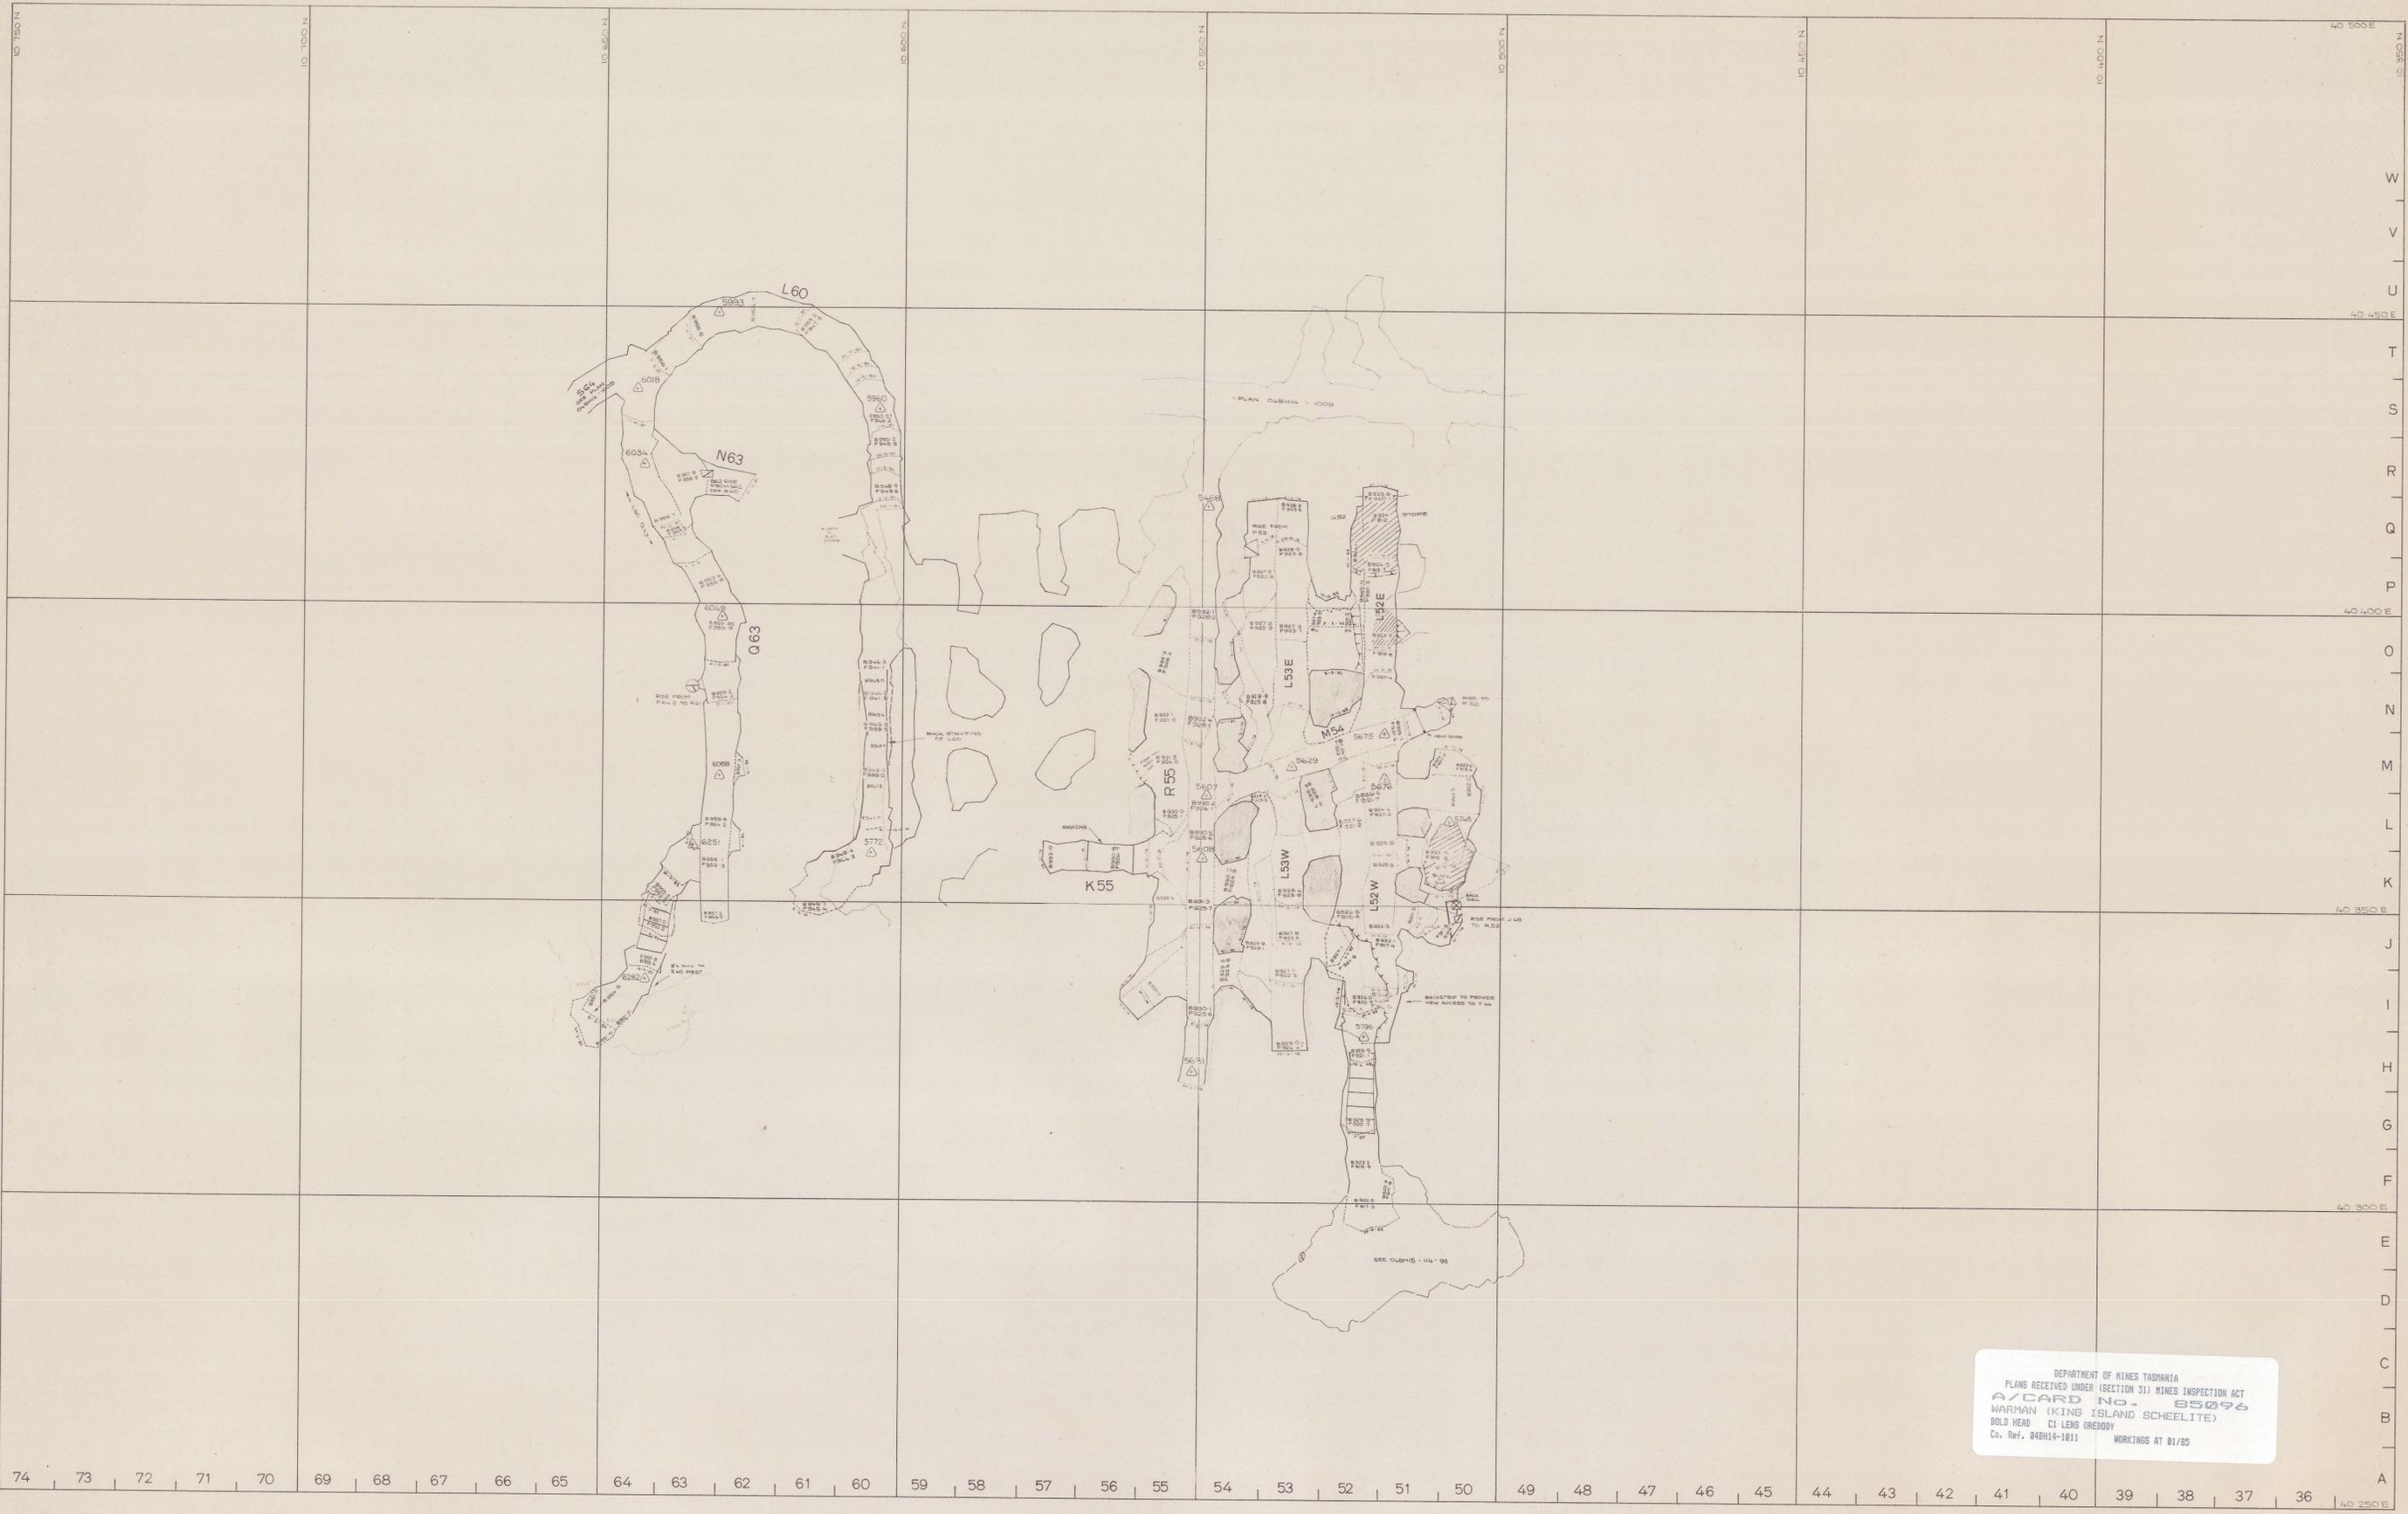

DEPARTMENT OF MINES TASMANIA
 PLANS RECEIVED UNDER (SECTION 31) MINES INSPECTION ACT
 A/CARD NO. 85296
 WARHAM (KING ISLAND SCHEELITE)
 BOLD HEAD C1 LENS OREBODY
 Co. Ref. 04BH14-1011 WORKINGS AT 01/85

SCALE 1:500 5 cm		LOCATION BOLD HEAD MINE	 KING ISLAND SCHEELITE A DIVISION OF WARHAM INTERNATIONAL GRASSY KING ISLAND PLAN NUMBER 04BH14 - 1011
north		SUBJECT C1 LENS OREBODY	