
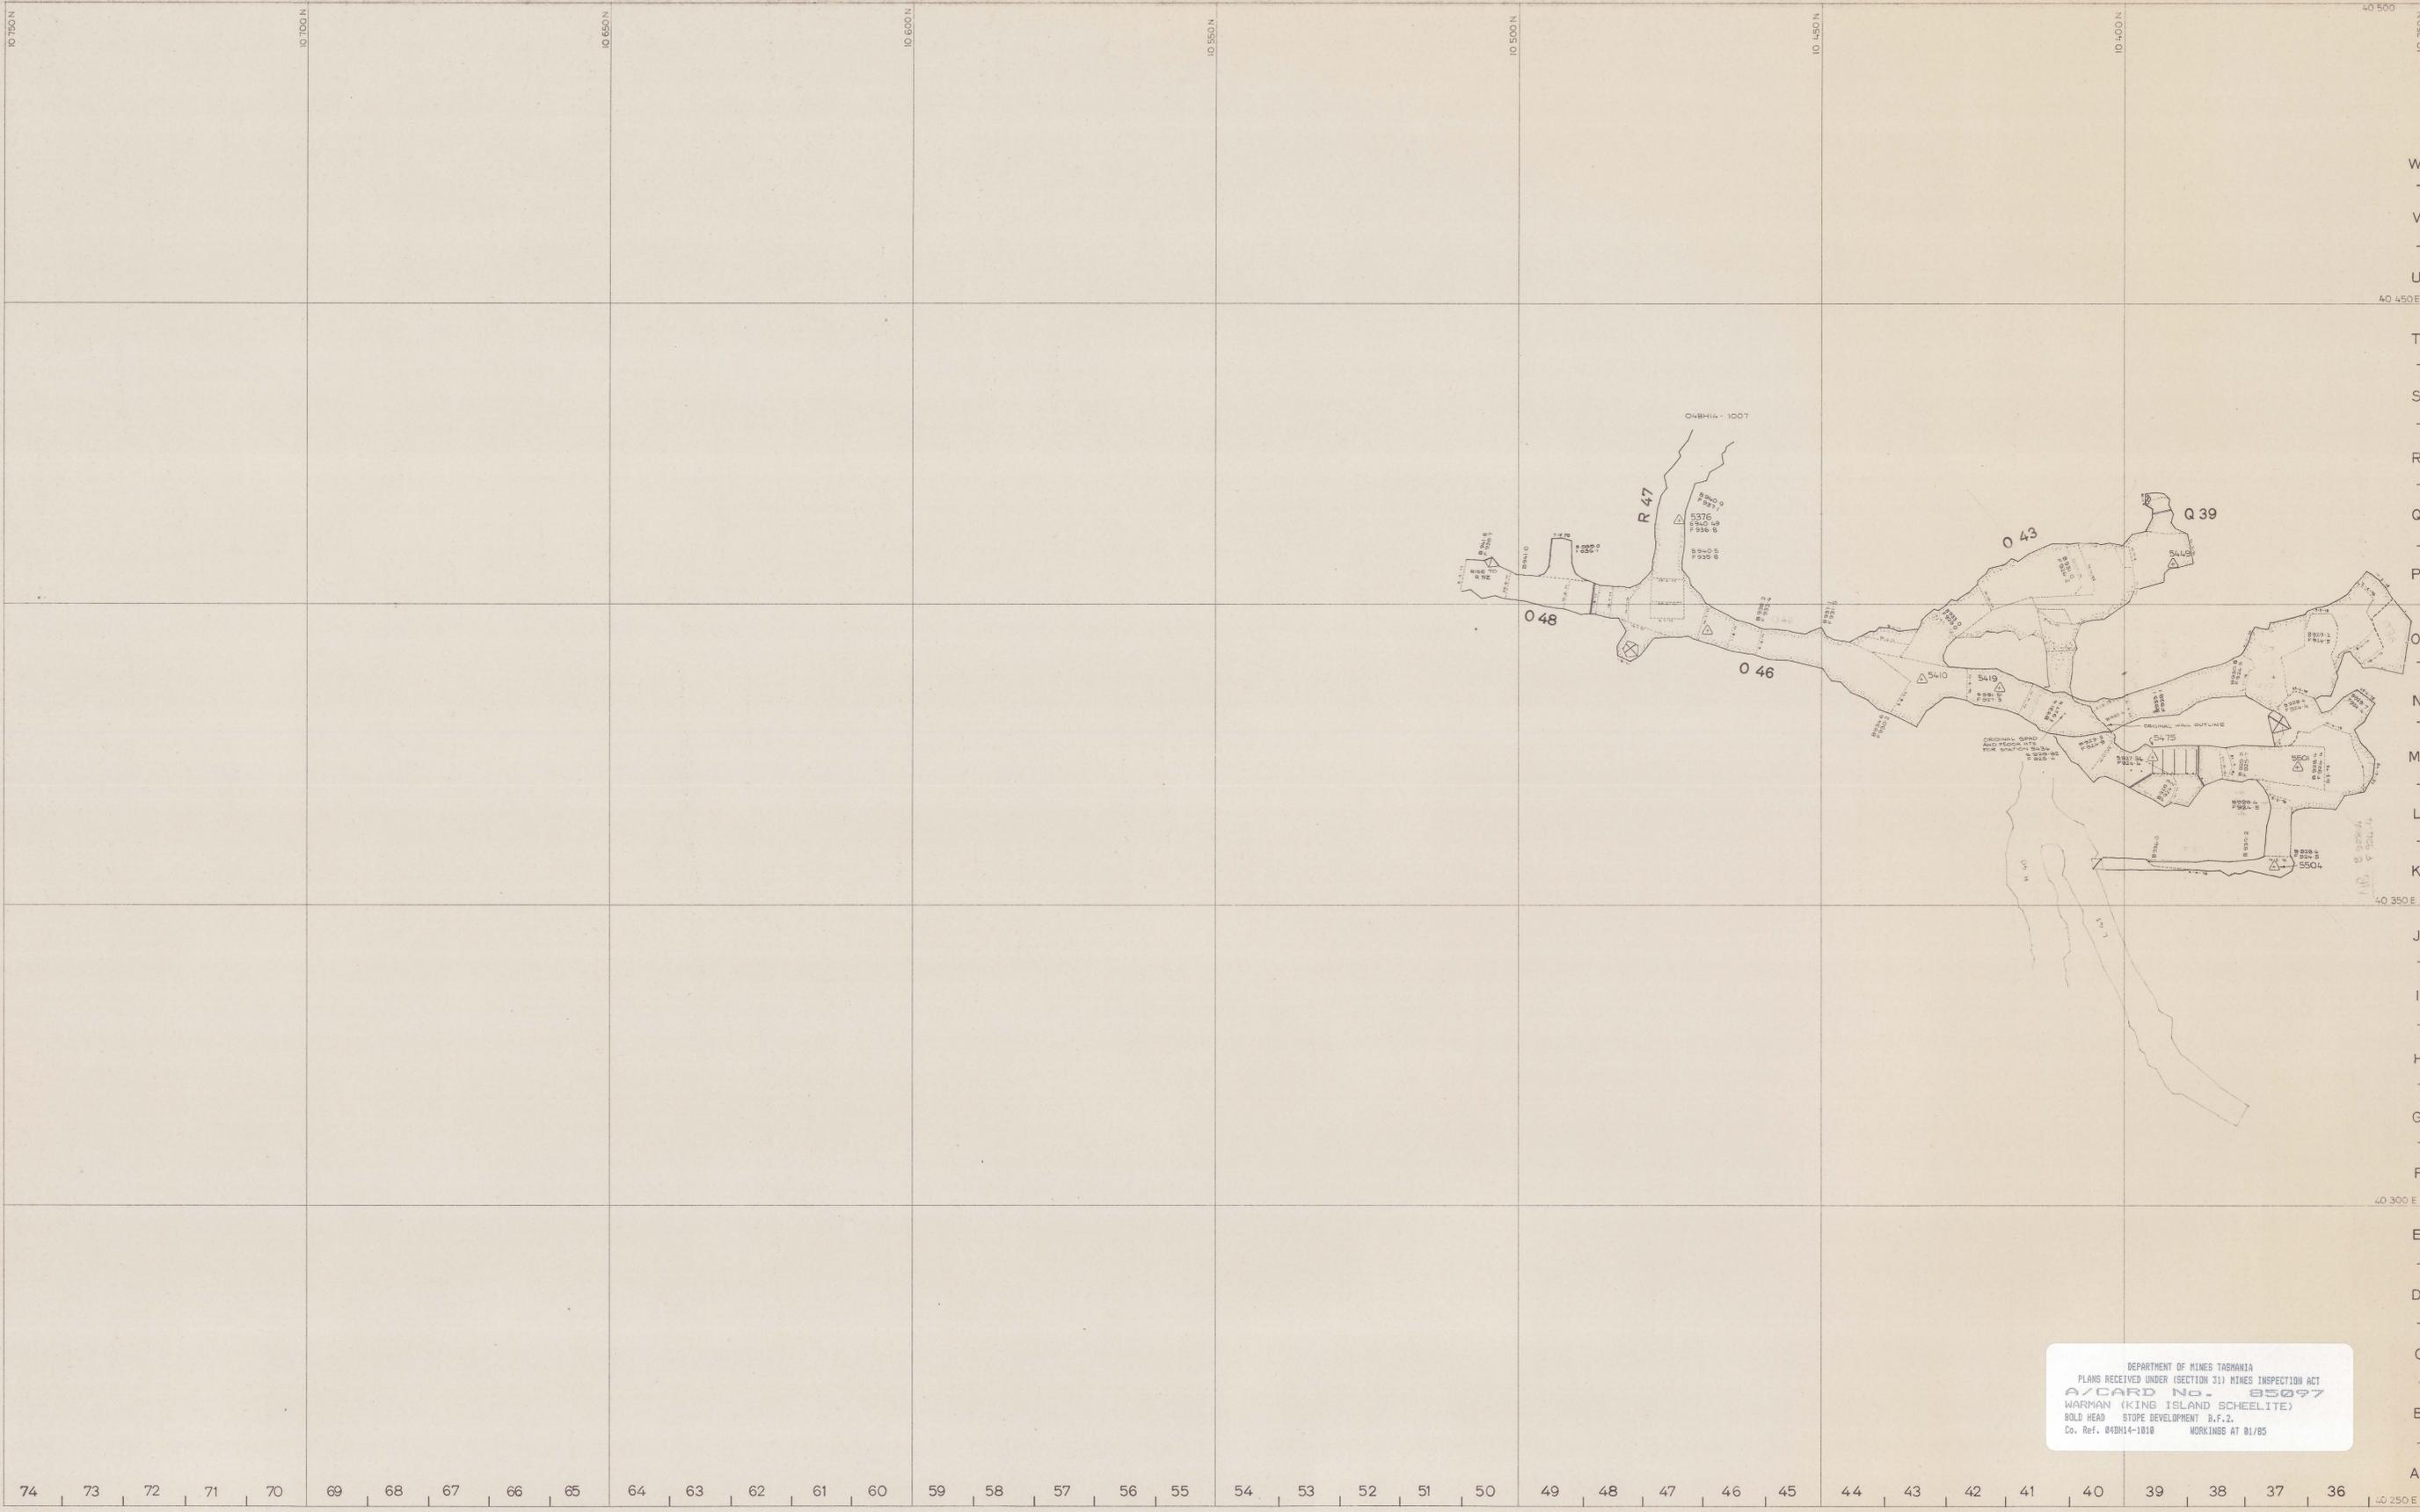


0374 - 121

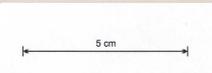

DEPARTMENT OF MINES TASMANIA  
 PLANS RECEIVED UNDER (SECTION 31) MINES INSPECTION ACT  
 A/CARD No. 85097  
 WARMAN (KING ISLAND SCHEELITE)  
 BOLD HEAD STOPE DEVELOPMENT B.F.2.  
 Co. Ref. 04BH14-1010 WORKINGS AT 01/85

74 73 72 71 70 69 68 67 66 65 64 63 62 61 60 59 58 57 56 55 54 53 52 51 50 49 48 47 46 45 44 43 42 41 40 39 38 37 36

SCALE 1 : 500 	LOCATION BOLD HEAD MINE	 A DIVISION OF WARMAN INTERNATIONAL GRASSY KING ISLAND
	SUBJECT STOPE DEVELOPMENT B. F. 2.	
north		