
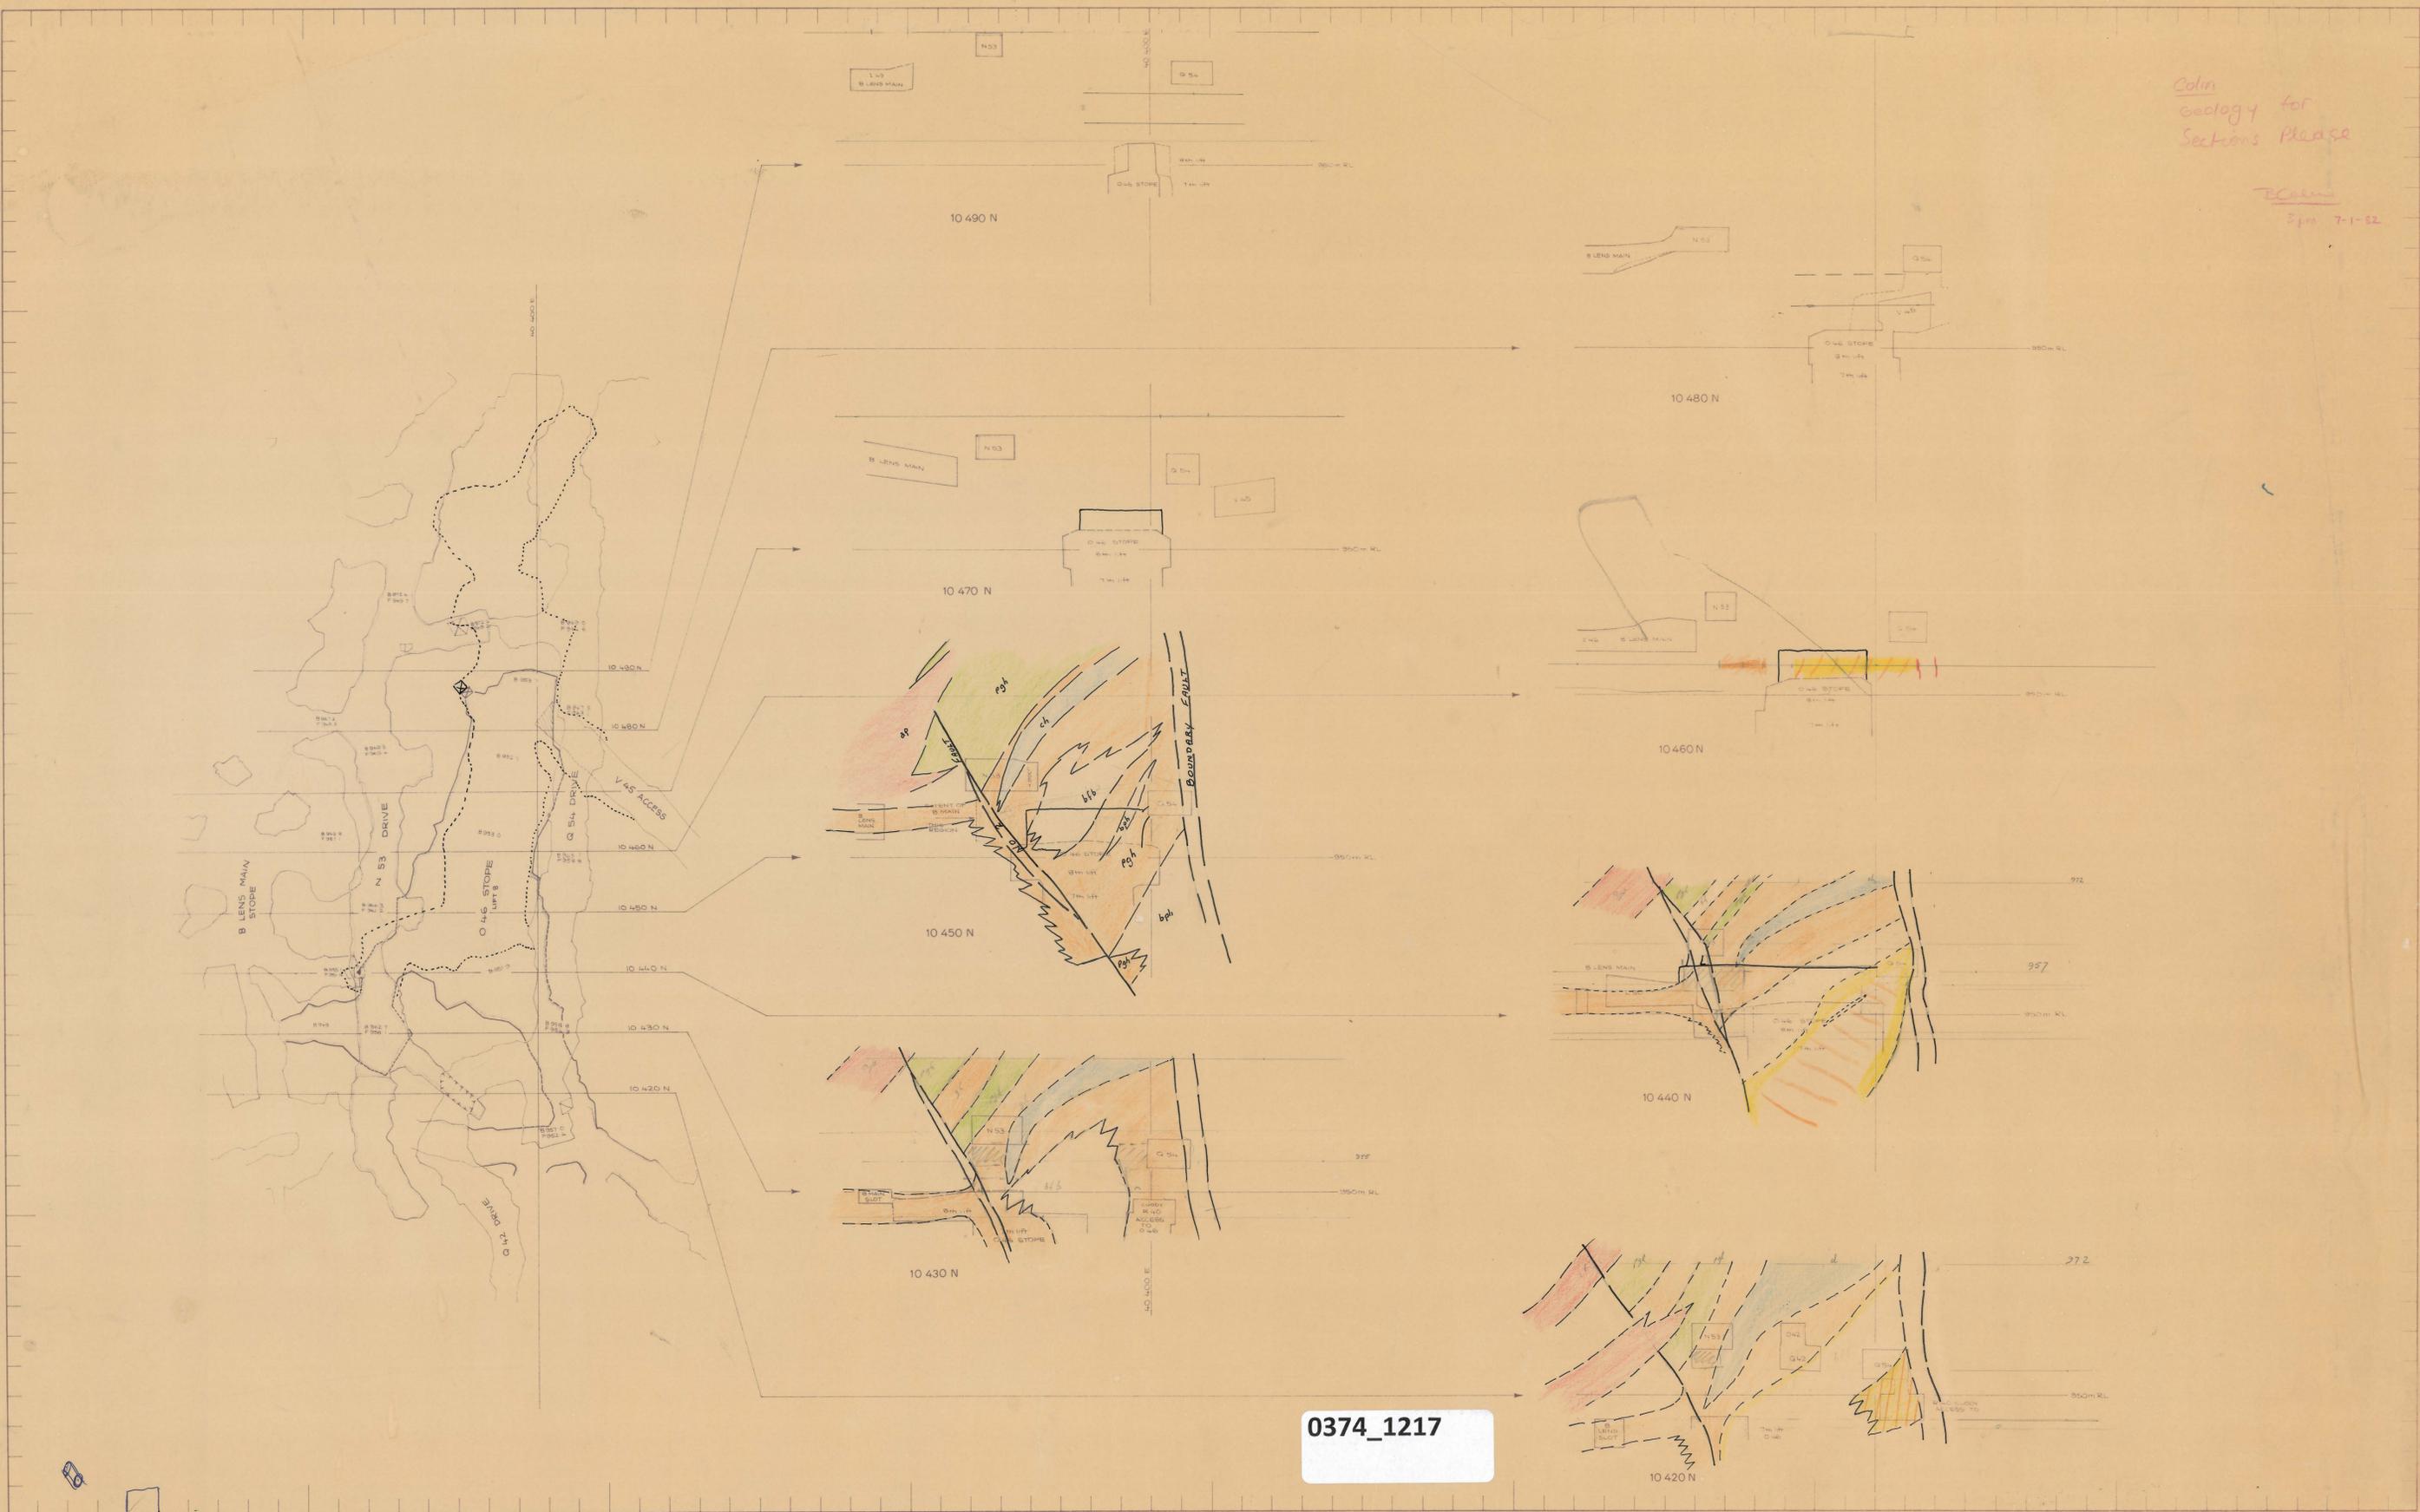


Colin
geology for
Sections please

Colin
Apr 7-1-82

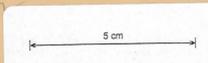

0374_1217

REVISIONS NO. DATE		APPROVAL INITIALS DATE		SCALE 1:500 	LOCATION BOLD HEAD MINE	 A Member of the BHP Billiton Group GRASSY KING ISLAND PRELIMINARY <input type="checkbox"/> FINAL <input type="checkbox"/> PLAN NUMBER
PLANNING ENGINEER SNR. PLANNING ENGINEER TECHNICAL SERVICES SUPT GENERAL MINING SUPT MINE SUPT SNR. SURVEYOR SNR. GEOLOGIST		INITIALS DATE		SUBJECT B. F. 2 CROSSECTIONS ALONG O 46		