


0374-122

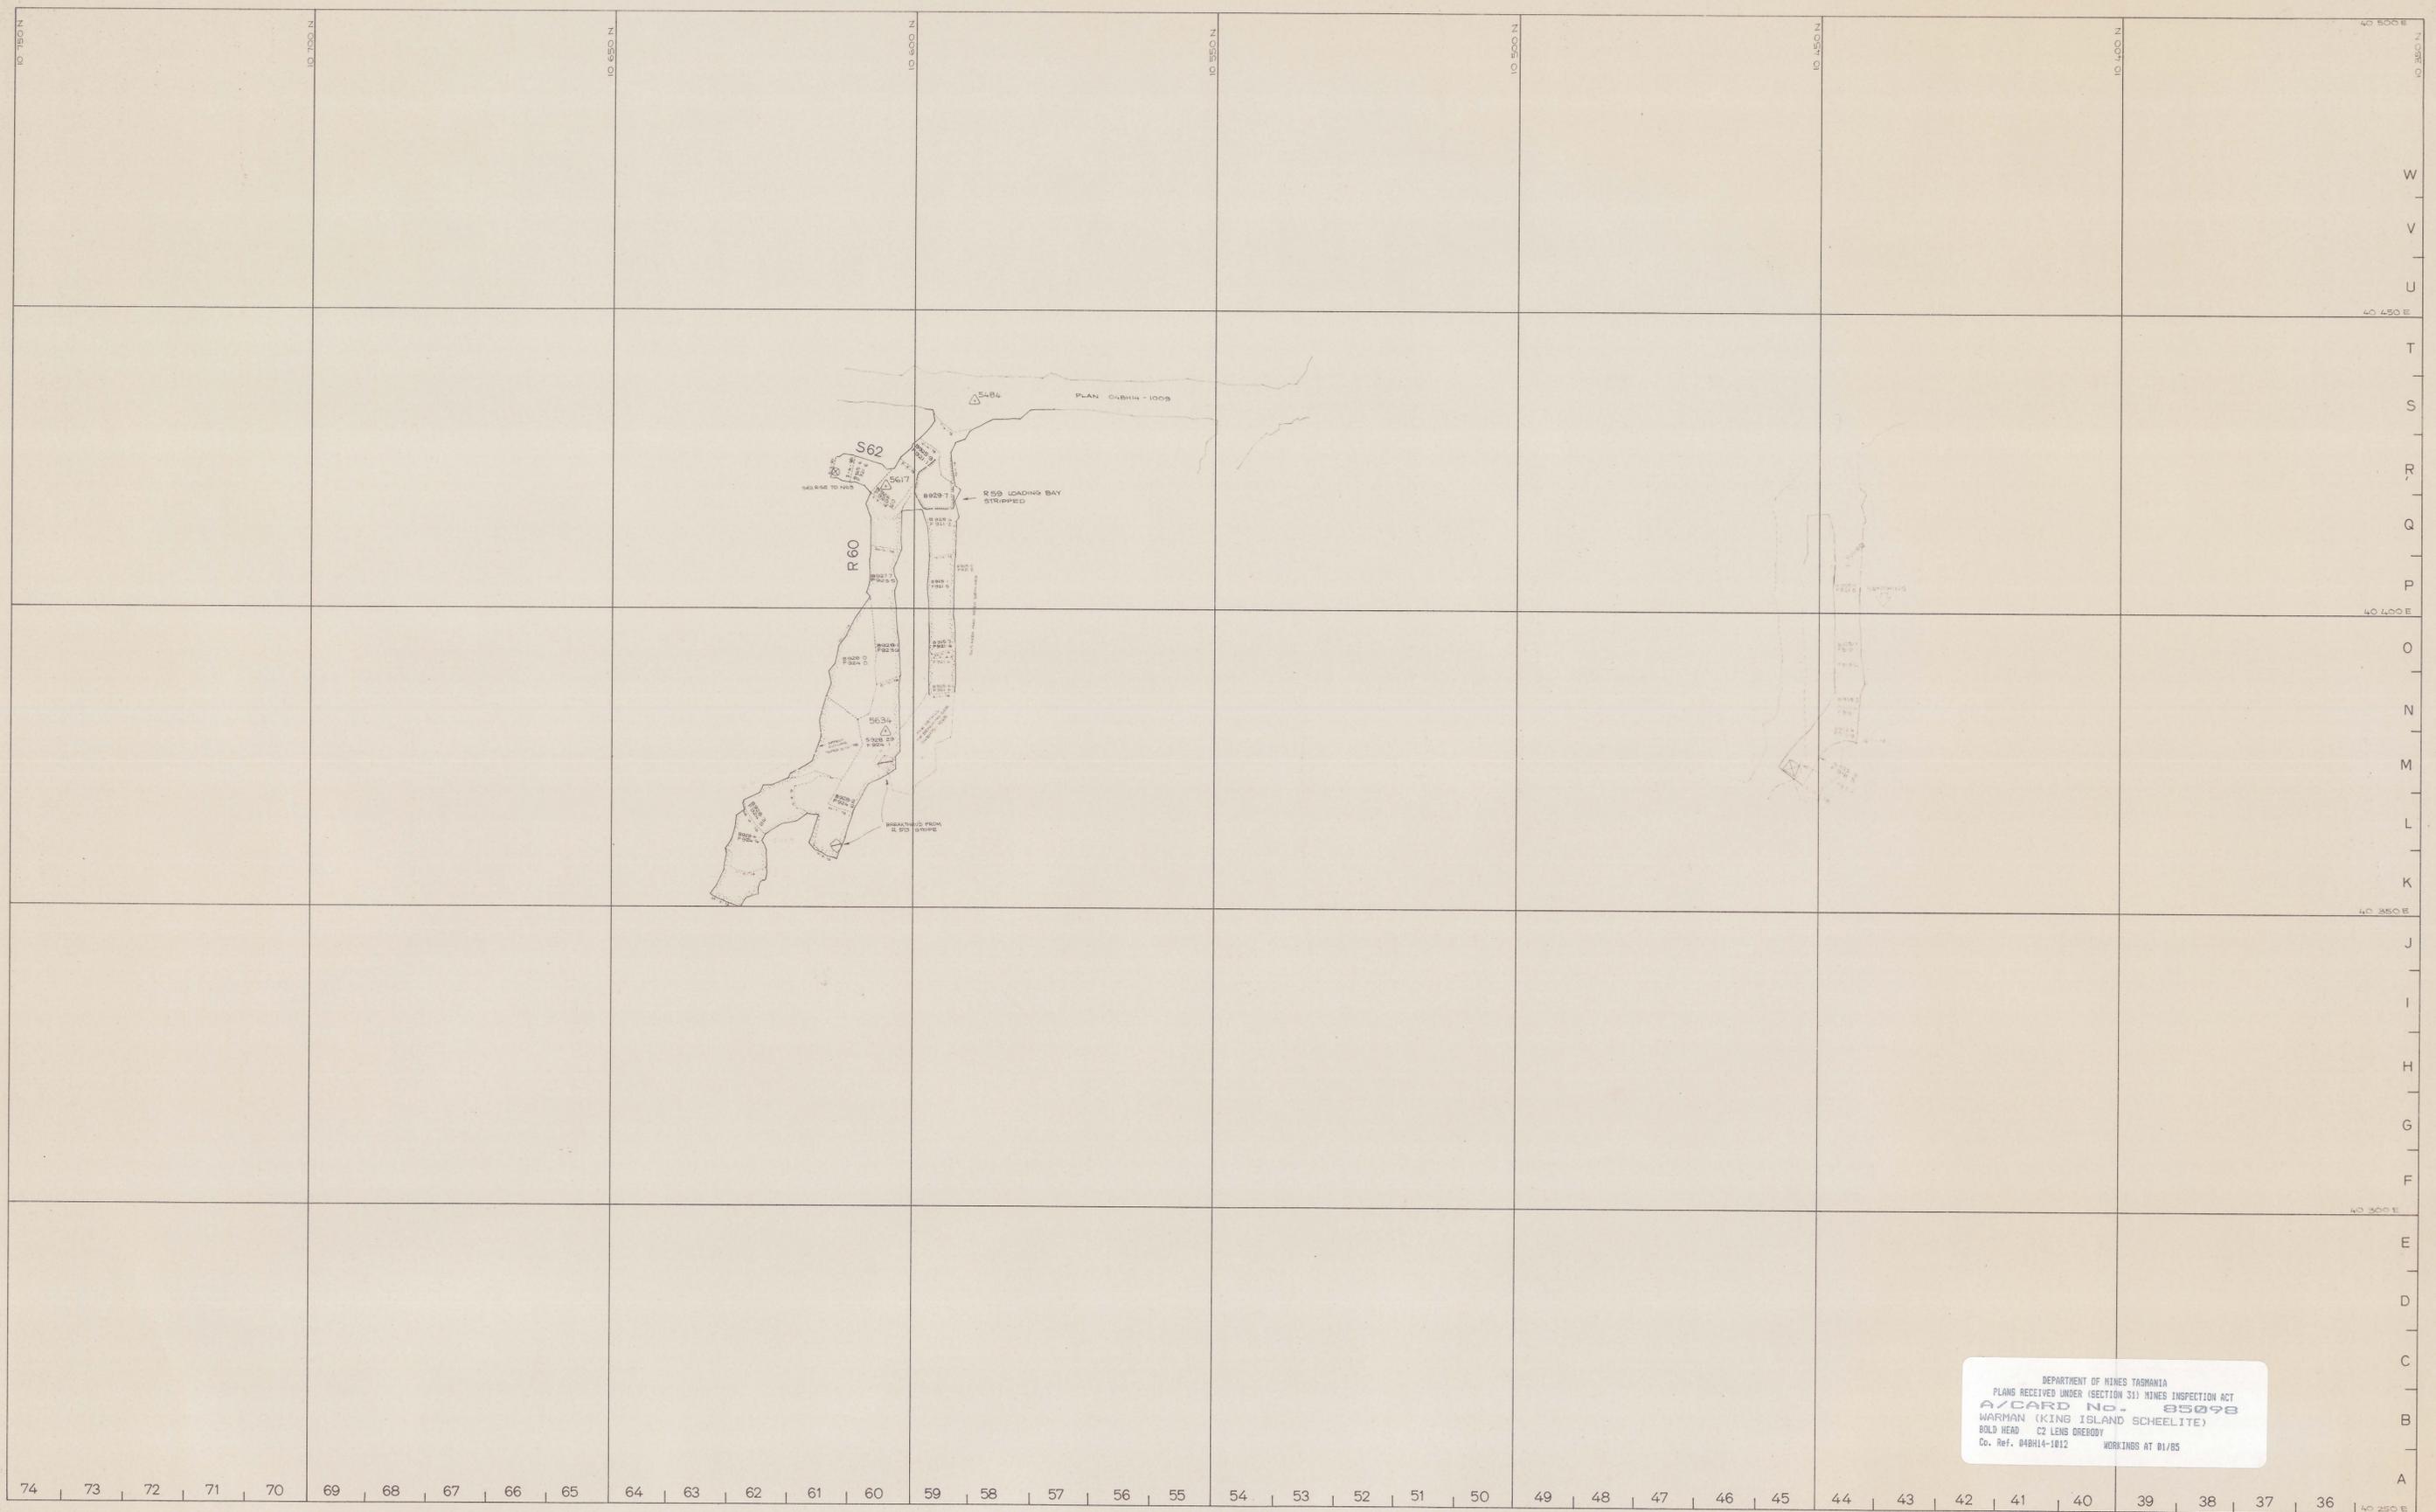

DEPARTMENT OF MINES TASMANIA
 PLANS RECEIVED UNDER (SECTION 31) MINES INSPECTION ACT
 A/CARD No. 85098
 WARFMAN (KING ISLAND SCHEELITE)
 BOLD HEAD C2 LENS OREBODY
 Co. Ref. 04BH14-1012 WORKINGS AT 01/85

SCALE 1:500 5 cm	LOCATION BOLD HEAD MINE	 KING ISLAND SCHEELITE A DIVISION OF WARFMAN INTERNATIONAL GRASSY KING ISLAND PLAN NUMBER 04BH14 - 1012
	SUBJECT C2 LENS OREBODY	
north		