



0374_1221

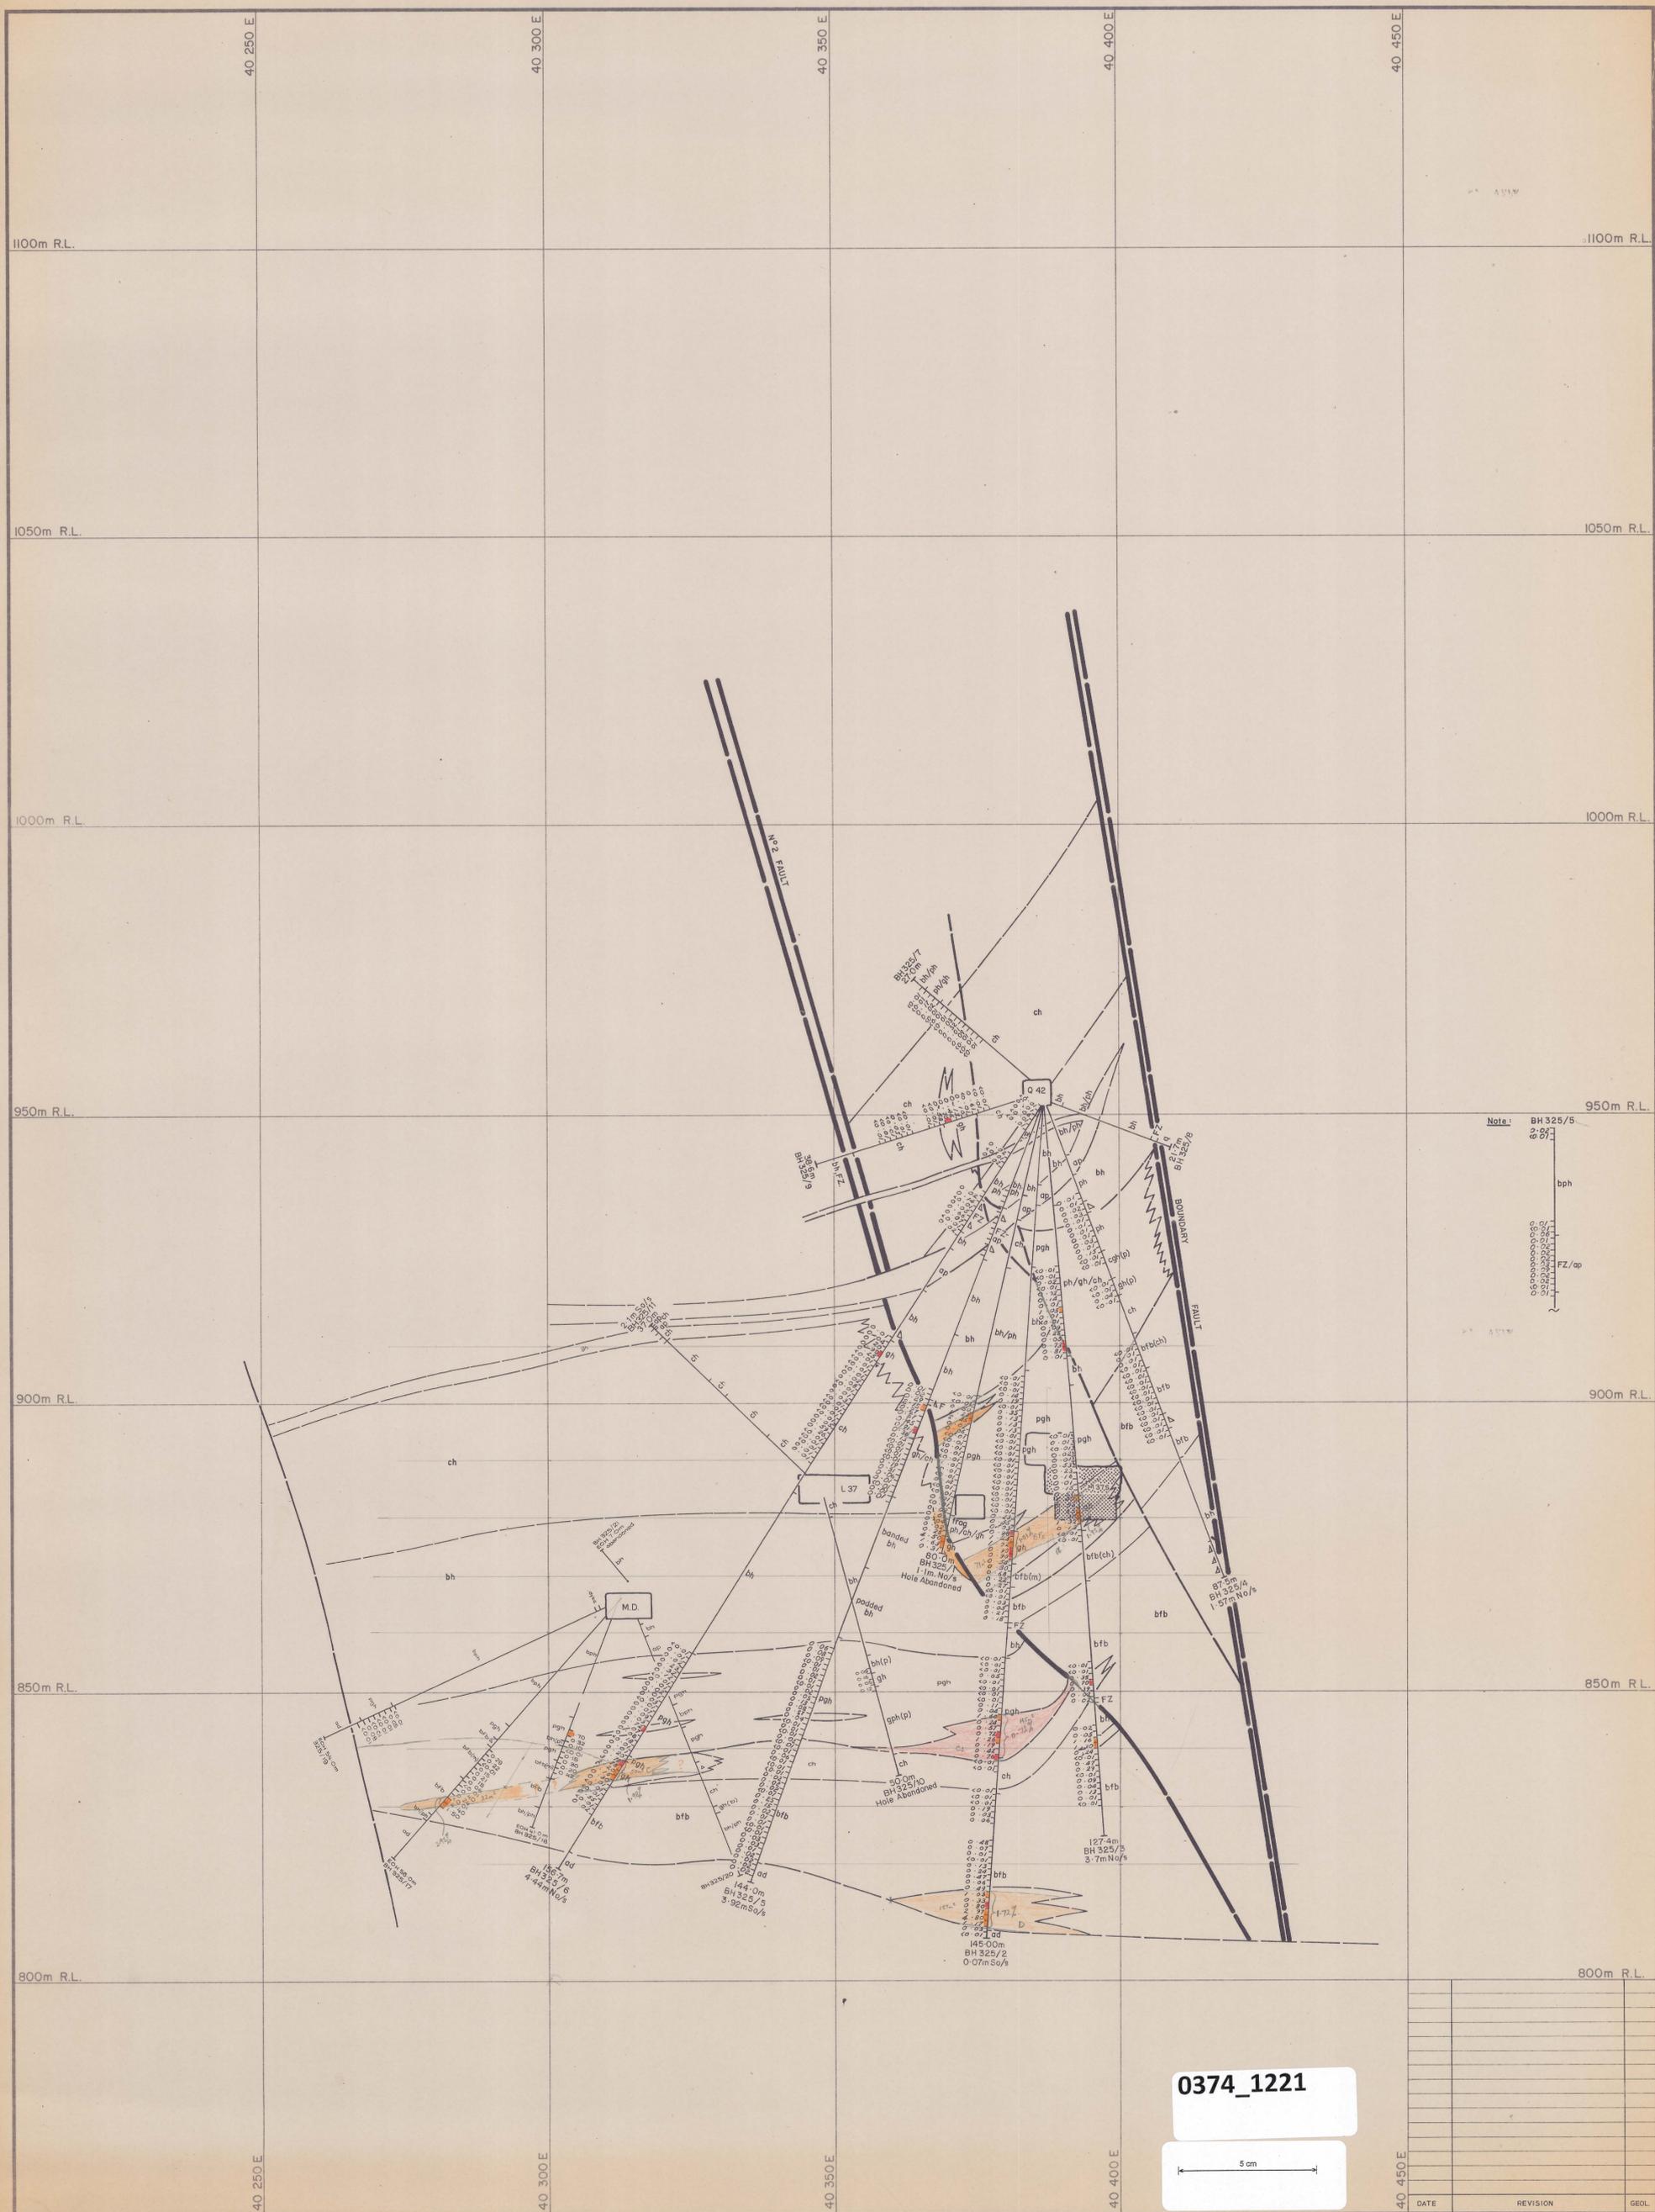

Note: BH 325/5
6.87m
bph
FZ/ap

0374_1221

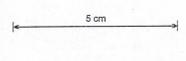

Legend:									
uv	Upper metavolcanics	pgh	Pyroxene garnet hornfels	bph	Biotite pyroxene hornfels	nc	No core recovered	Fault, showing relative movement	
bh	Biotite hornfels	pgh(m)	Mineralized pgh (>0.30% WO ₃)	q	Quartzite	(m)	Mineralized	Degree of uncertainty in Fault position	
ph	Pyroxene hornfels	gh	Garnet skarn (>0.30% WO ₃)	ad	Adomellite	(b)	Banded	Assay results in % WO ₃	
ch	Marble	bfb	Banded footwall beds	ap	Aplite	(p)	Podded	Indicates collar location as being 1.7 metres North of section	
mv	Middle metavolcanics	bfb(m)	Mineralized bfb (>0.30% WO ₃)			(d)	Disturbed	Indicates end of hole as being 2.1 metres South of section	
						b.b	Breccia	Stope, showing area filled	

KING ISLAND SCHEELITE
No. K
BOLD HEAD OREBODY
GEOLOGICAL CROSS SECTION
10 325 N