



0374 - 123

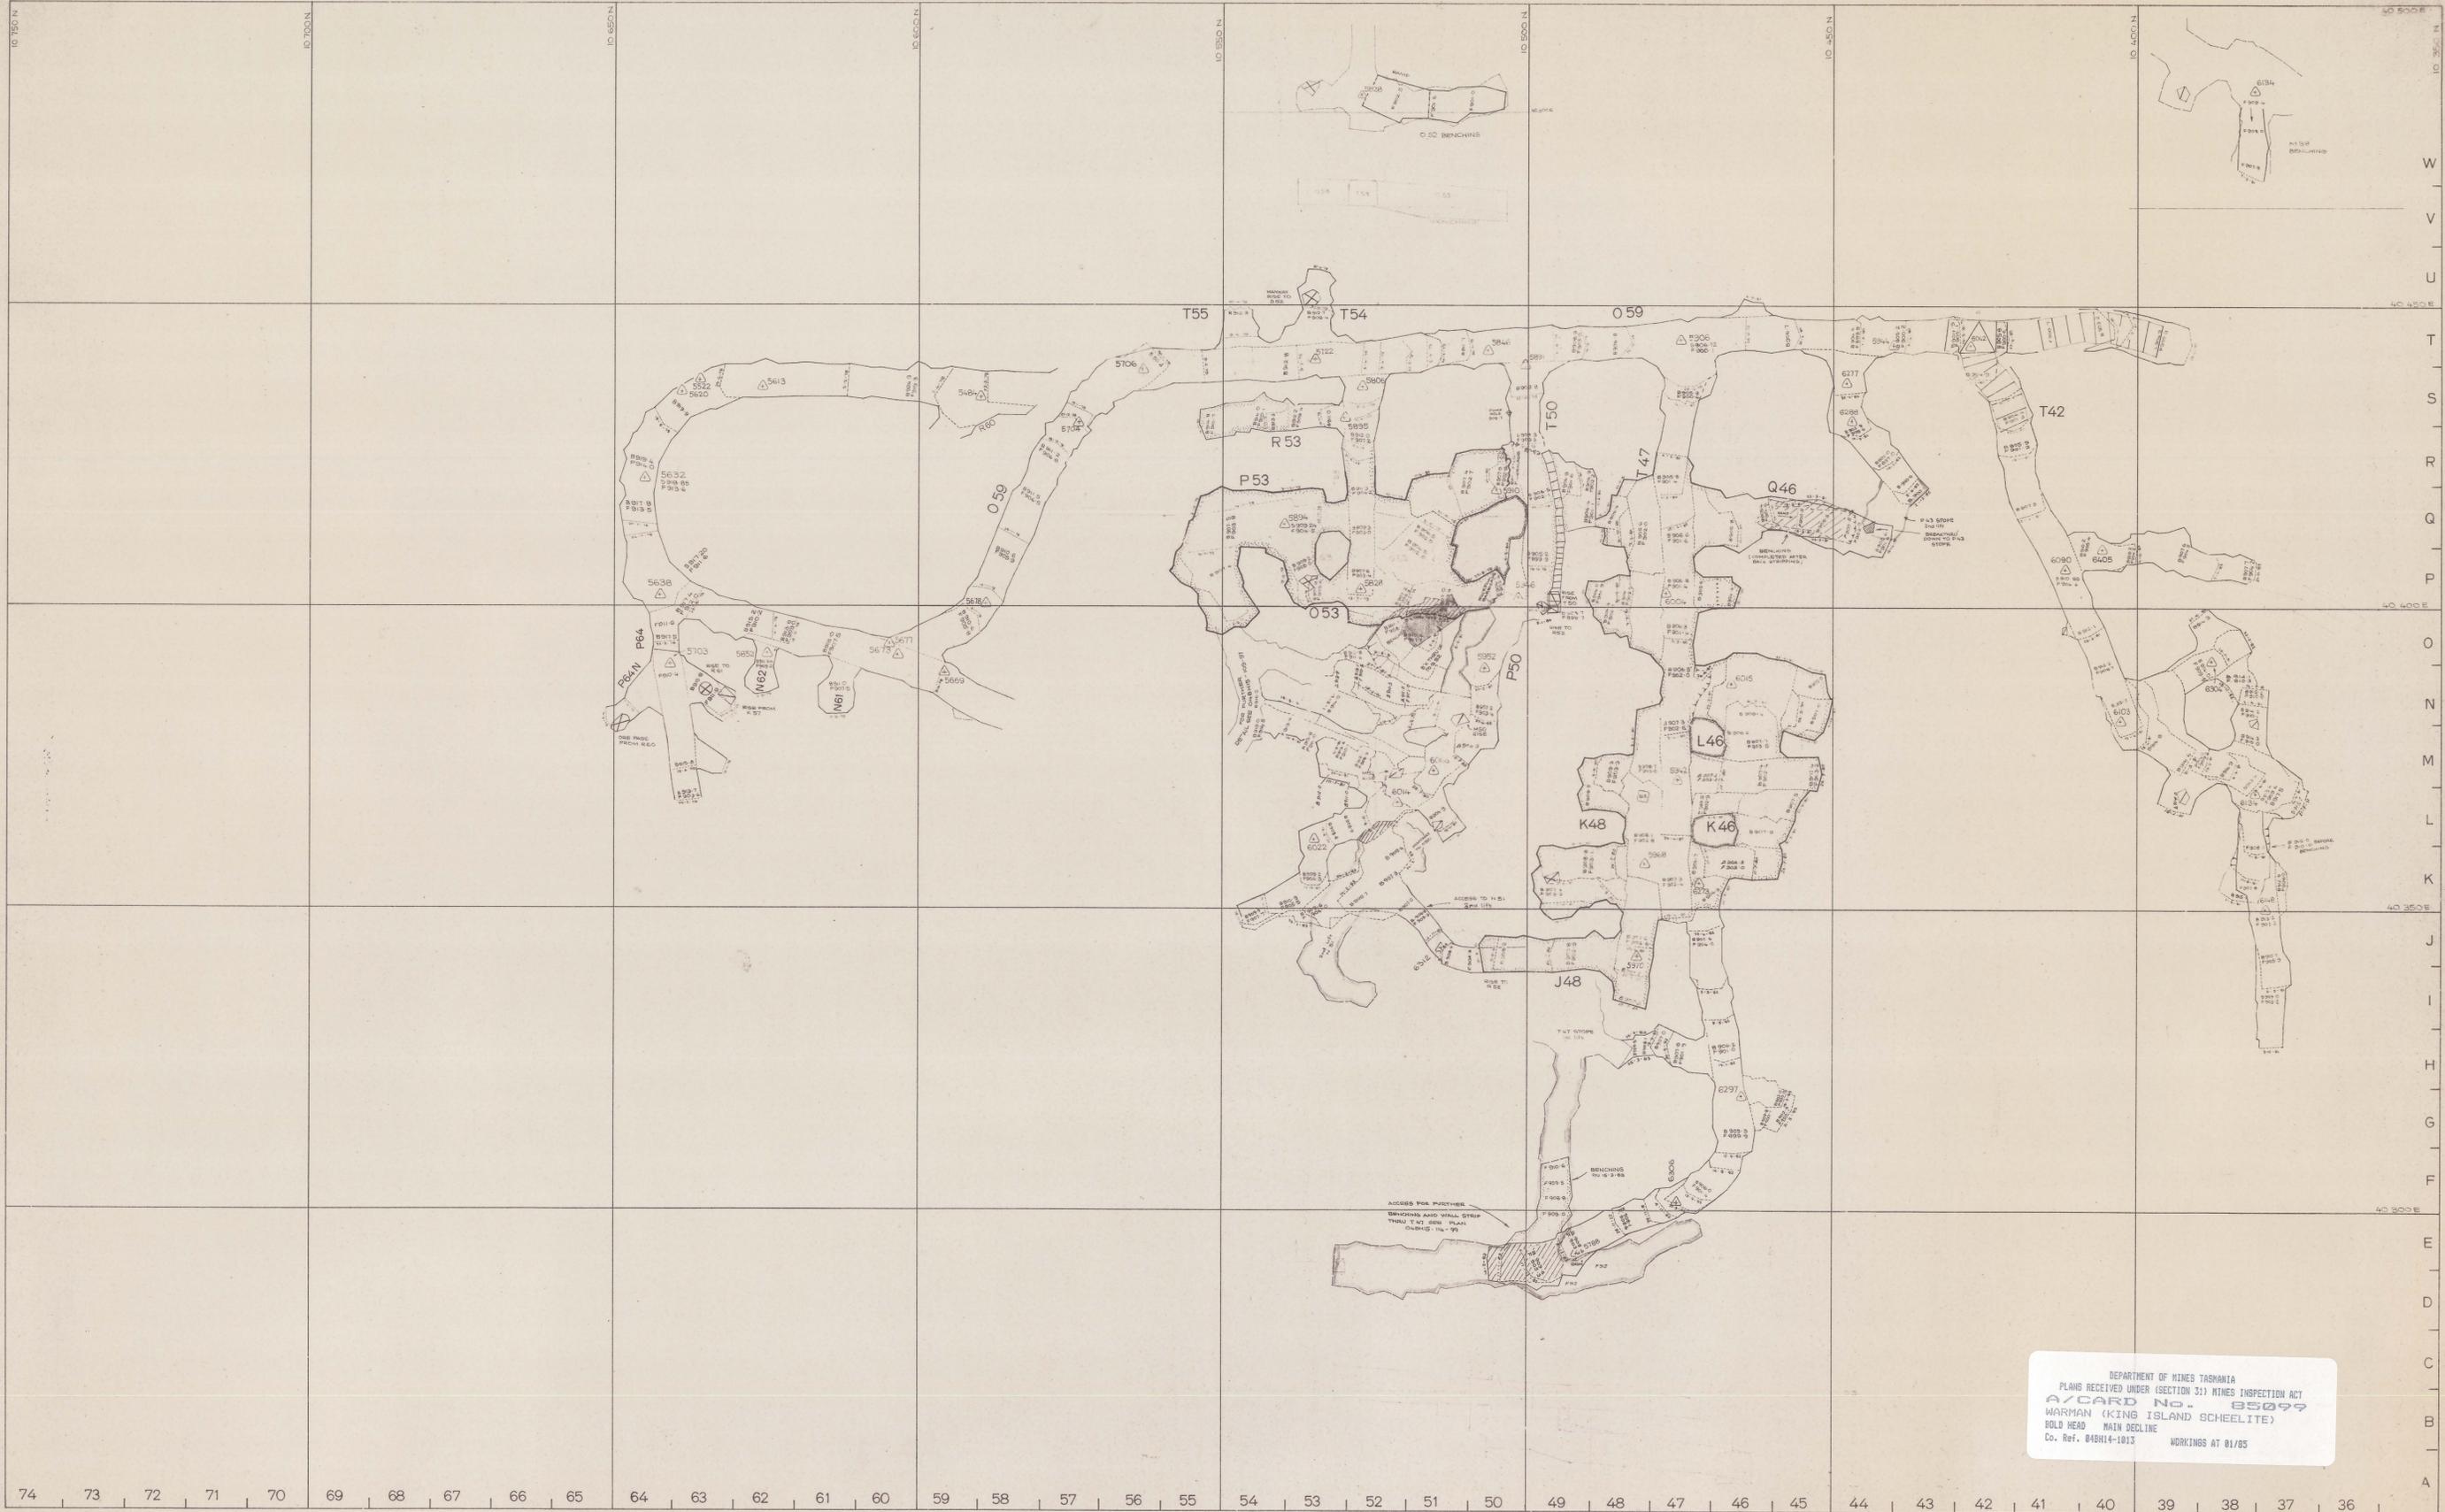

DEPARTMENT OF MINES TASMANIA
 PLANS RECEIVED UNDER SECTION 311 MINES INSPECTION ACT
 A/CARD NO. 85099
 WARMAN (KING ISLAND SCHEELITE)
 BOLD HEAD MAIN DECLINE
 Co. Ref. B4BH14-1013 WORKINGS AT 81/85

74 73 72 71 70 69 68 67 66 65 64 63 62 61 60 59 58 57 56 55 54 53 52 51 50 49 48 47 46 45 44 43 42 41 40 39 38 37 36

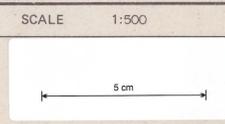

LOCATION BOLD HEAD MINE
 SUBJECT MAIN DECLINE
 north

KIS KING ISLAND SCHEELITE
 A DIVISION OF WARMAN INTERNATIONAL
 GRASSY KING ISLAND
 PLAN NUMBER 04BH14 - 1013