


0374 - 124

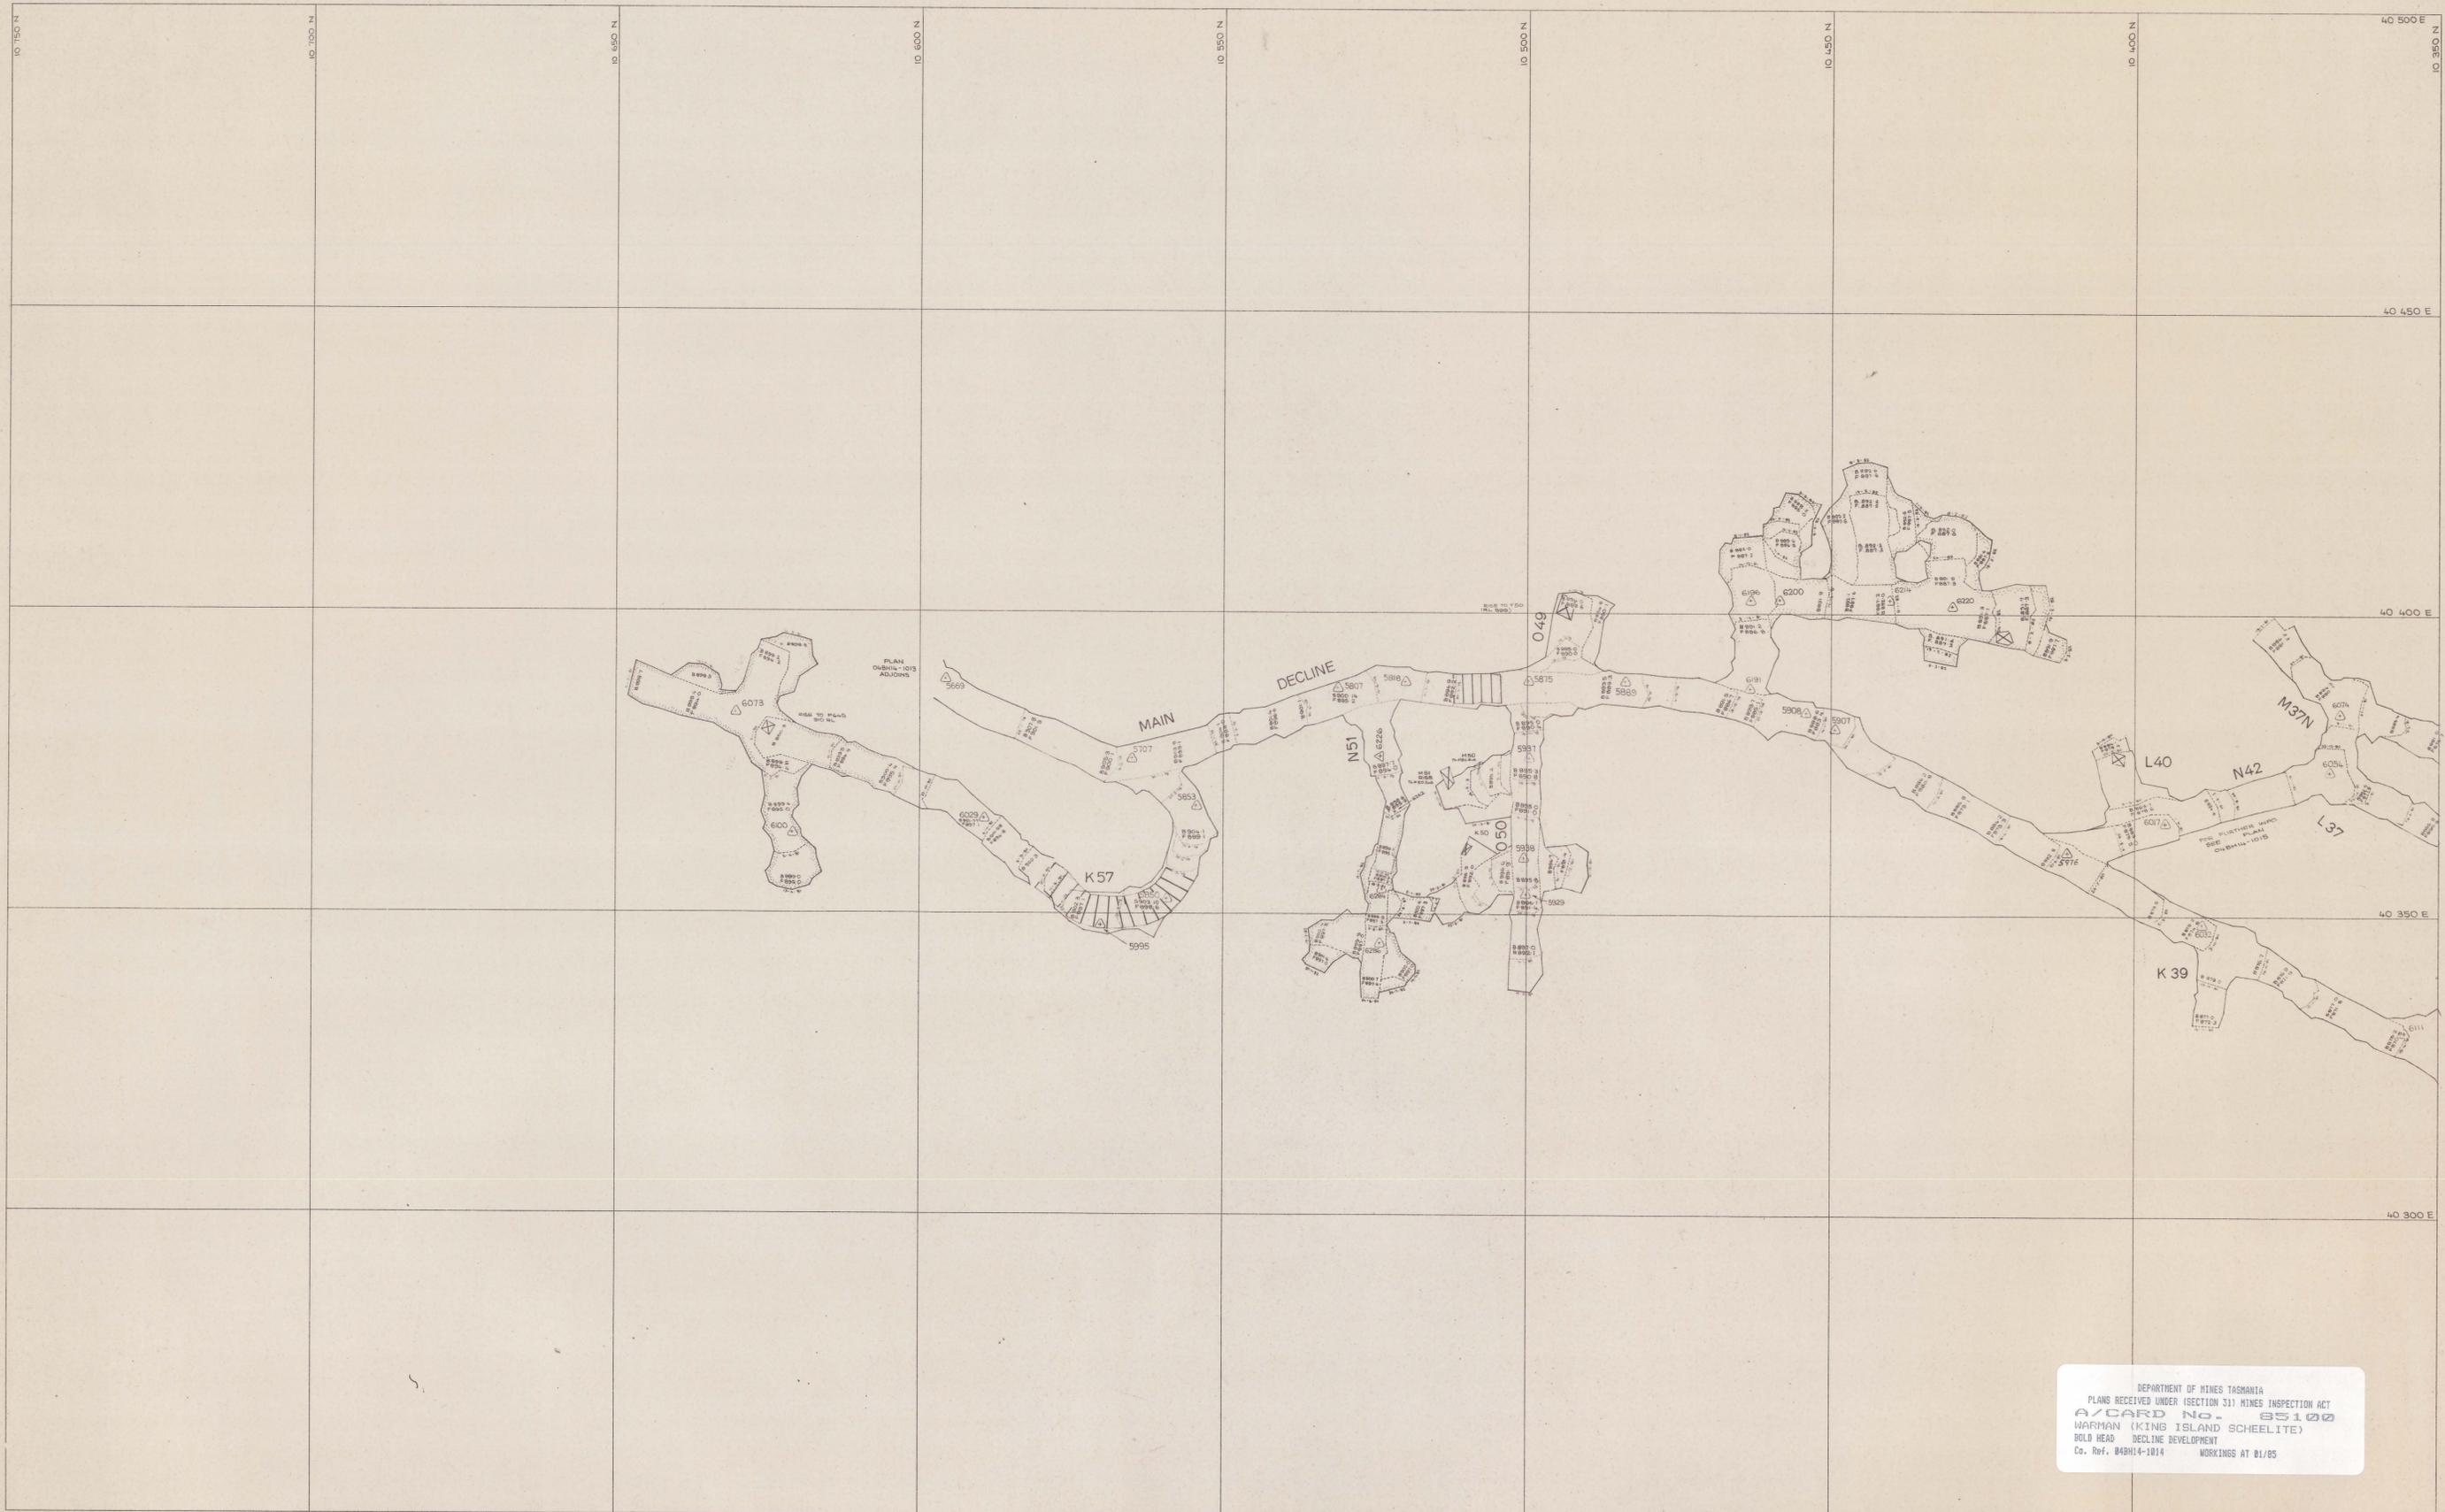

DEPARTMENT OF MINES TASMANIA
 PLANS RECEIVED UNDER (SECTION 31) MINES INSPECTION ACT
 A/CAD No. 85102
 WARHAM (KING ISLAND SCHEELITE)
 BOLD HEAD
 DECLINE DEVELOPMENT
 Co. Ref. 04BH14-1014 WORKINGS AT 01/85

SCALE 1:500

LOCATION BOLD HEAD MINE
 SUBJECT DECLINE DEVELOPMENT

north

KIS KING ISLAND SCHEELITE
 A DIVISION OF WARHAM INTERNATIONAL

GRASSY KING ISLAND

PLAN NUMBER 04BH14 - 1014