


0374-1252

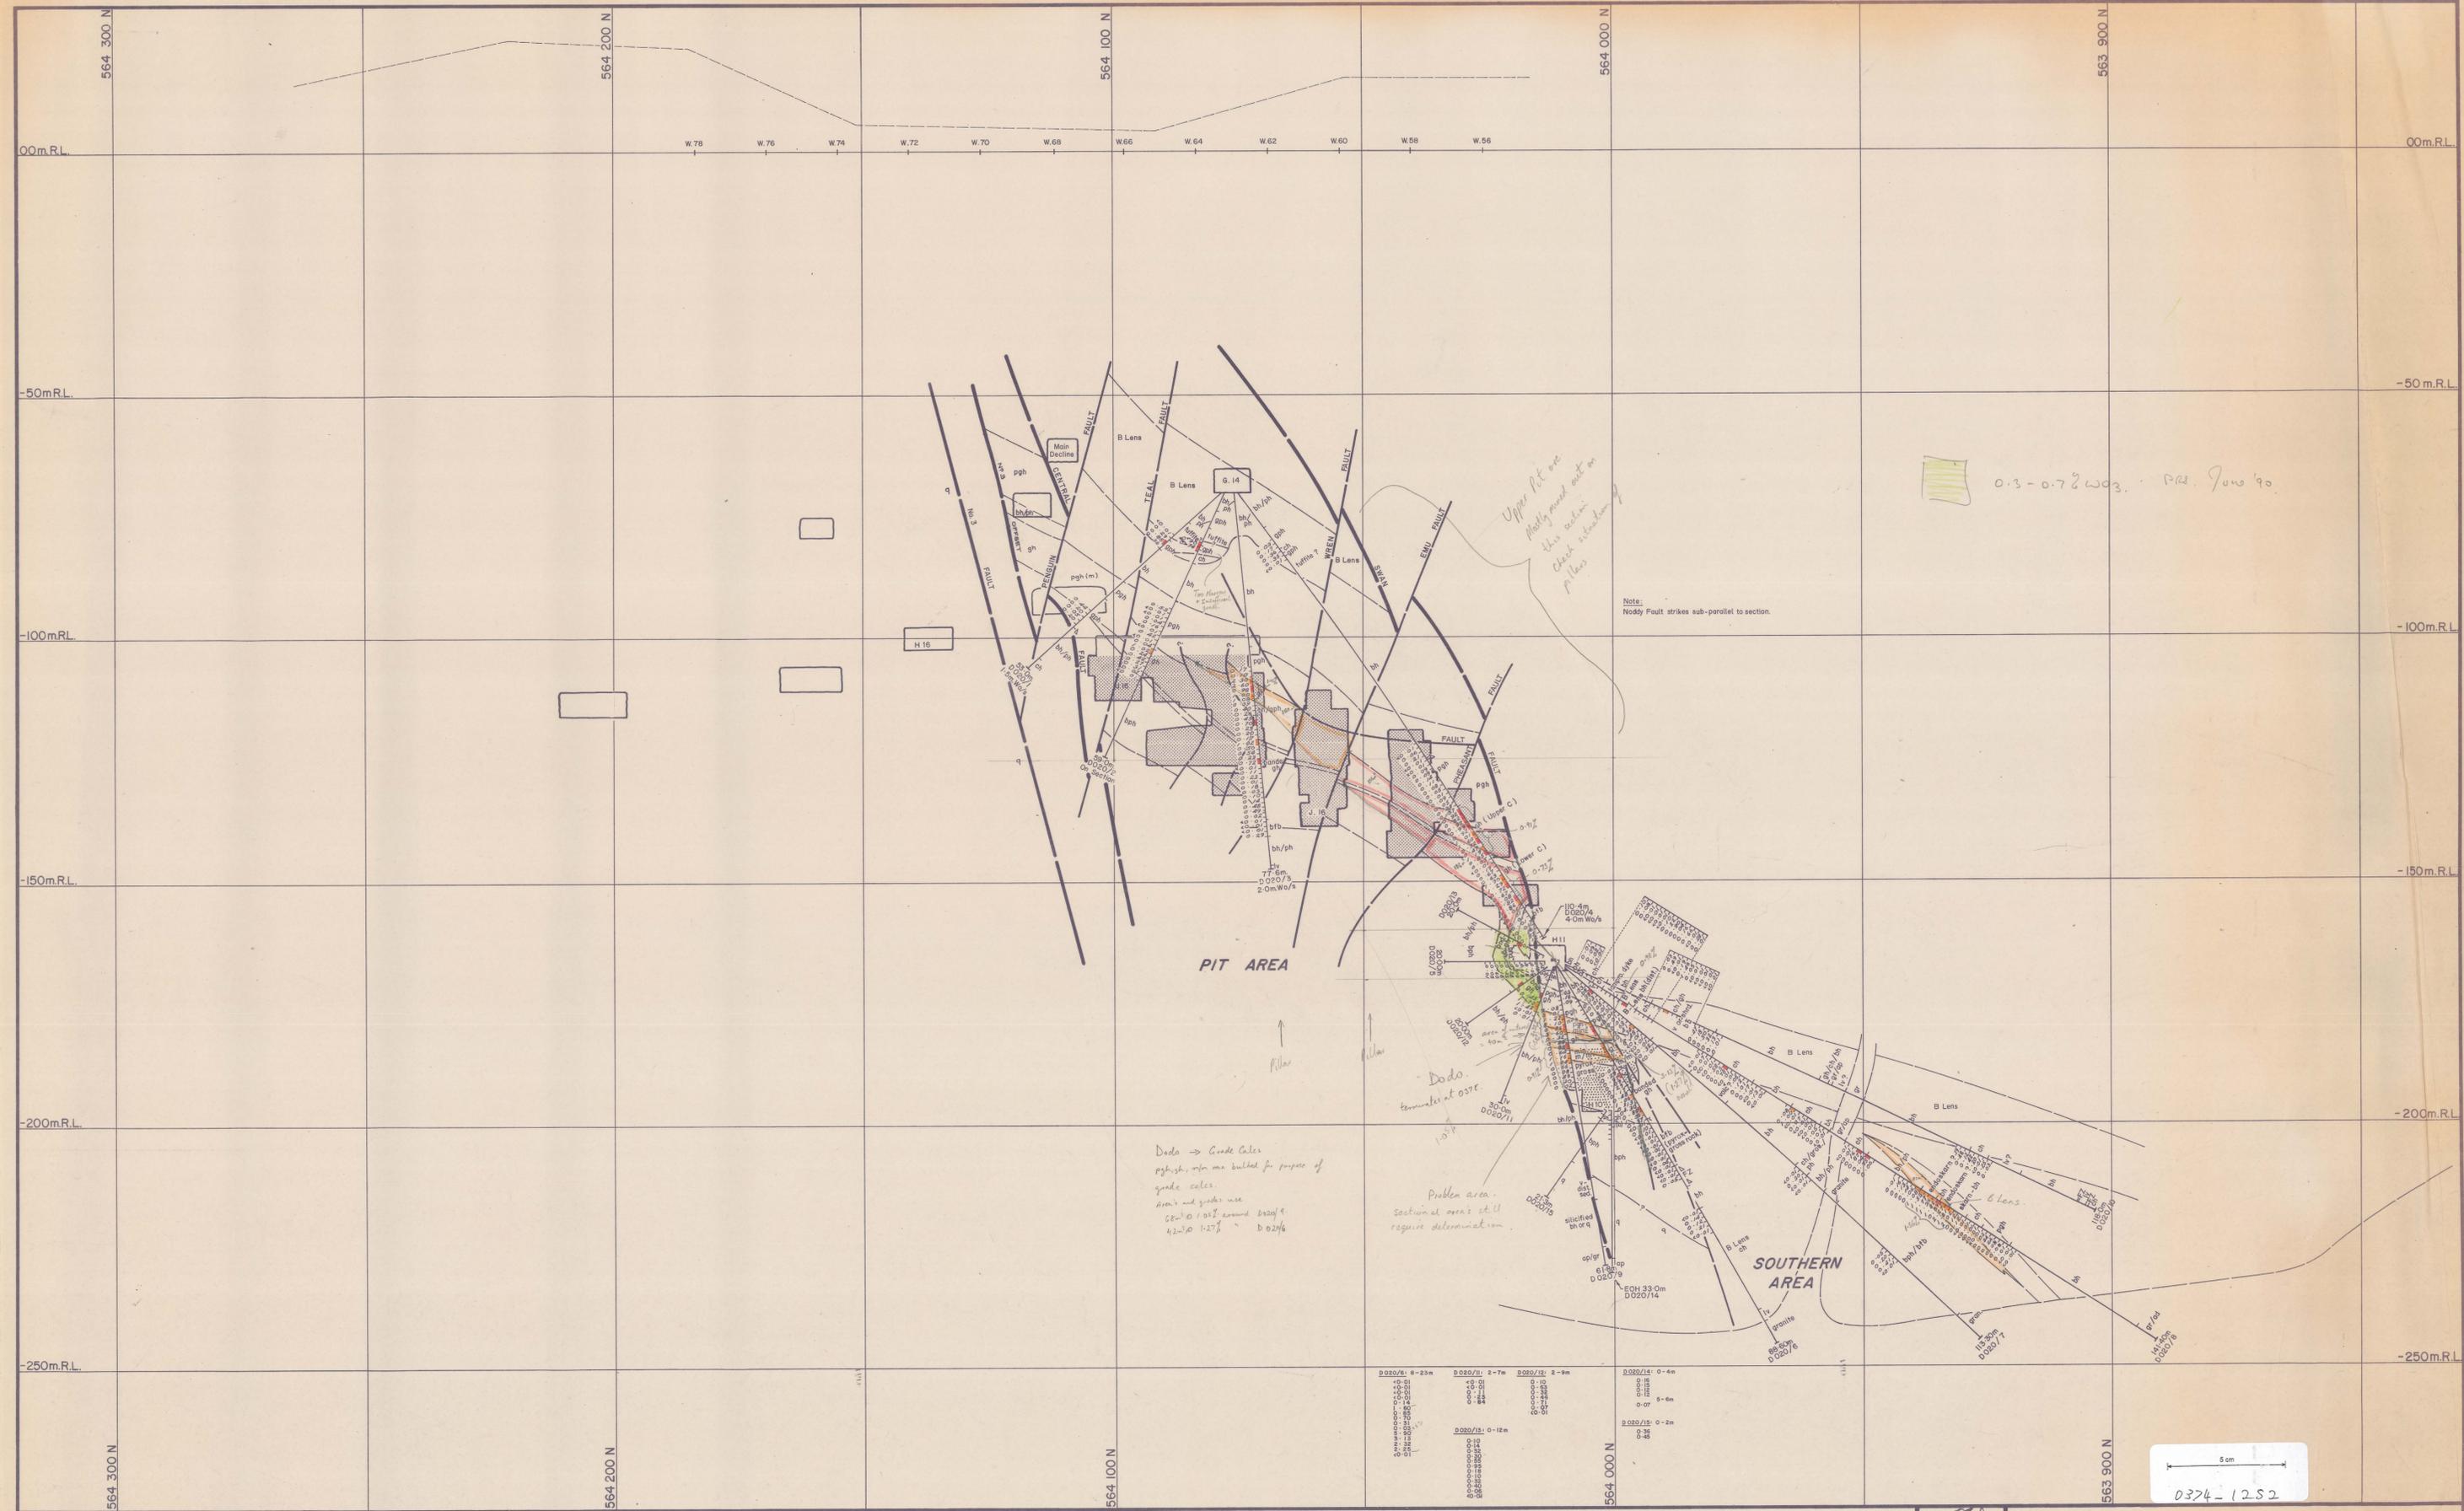

Legend: <ul style="list-style-type: none"> v Upper metavolcanics ph/bh Banded hornfels ch Marble bh Biotite hornfels pgh Pyroxene garnet hornfels gh Garnet hornfels bph Banded footwall beds lv Lower metavolcanics q Quartzite ap Aplite 	<ul style="list-style-type: none"> 60 Strike and dip 55 Joint, inclined Joint, vertical Fault Degree of uncertainty in Fault position Direction of bedding with respect to core axis 	RQD Rock Quality Designator J/M Joints per Metre of recovered core (after E. Miller; March, 1972)	RQD % >90 Minimum or no support 60-90 Intermediate support; rockbolts and one shotcrete application <60 Maximum support
--	--	--	---

KING ISLAND SCHEELITE
 No. KG2-01-002
 SCALE: 1:500
 DATE: July '87
 GEOLOGIST: P. J. D.
 DRAWN: [Signature]
 CHECKED: [Signature]

DOLPHIN MINE
 GEOLOGICAL CROSS-SECTION
 220 020 E