


U Central Lift 14

0374-1259

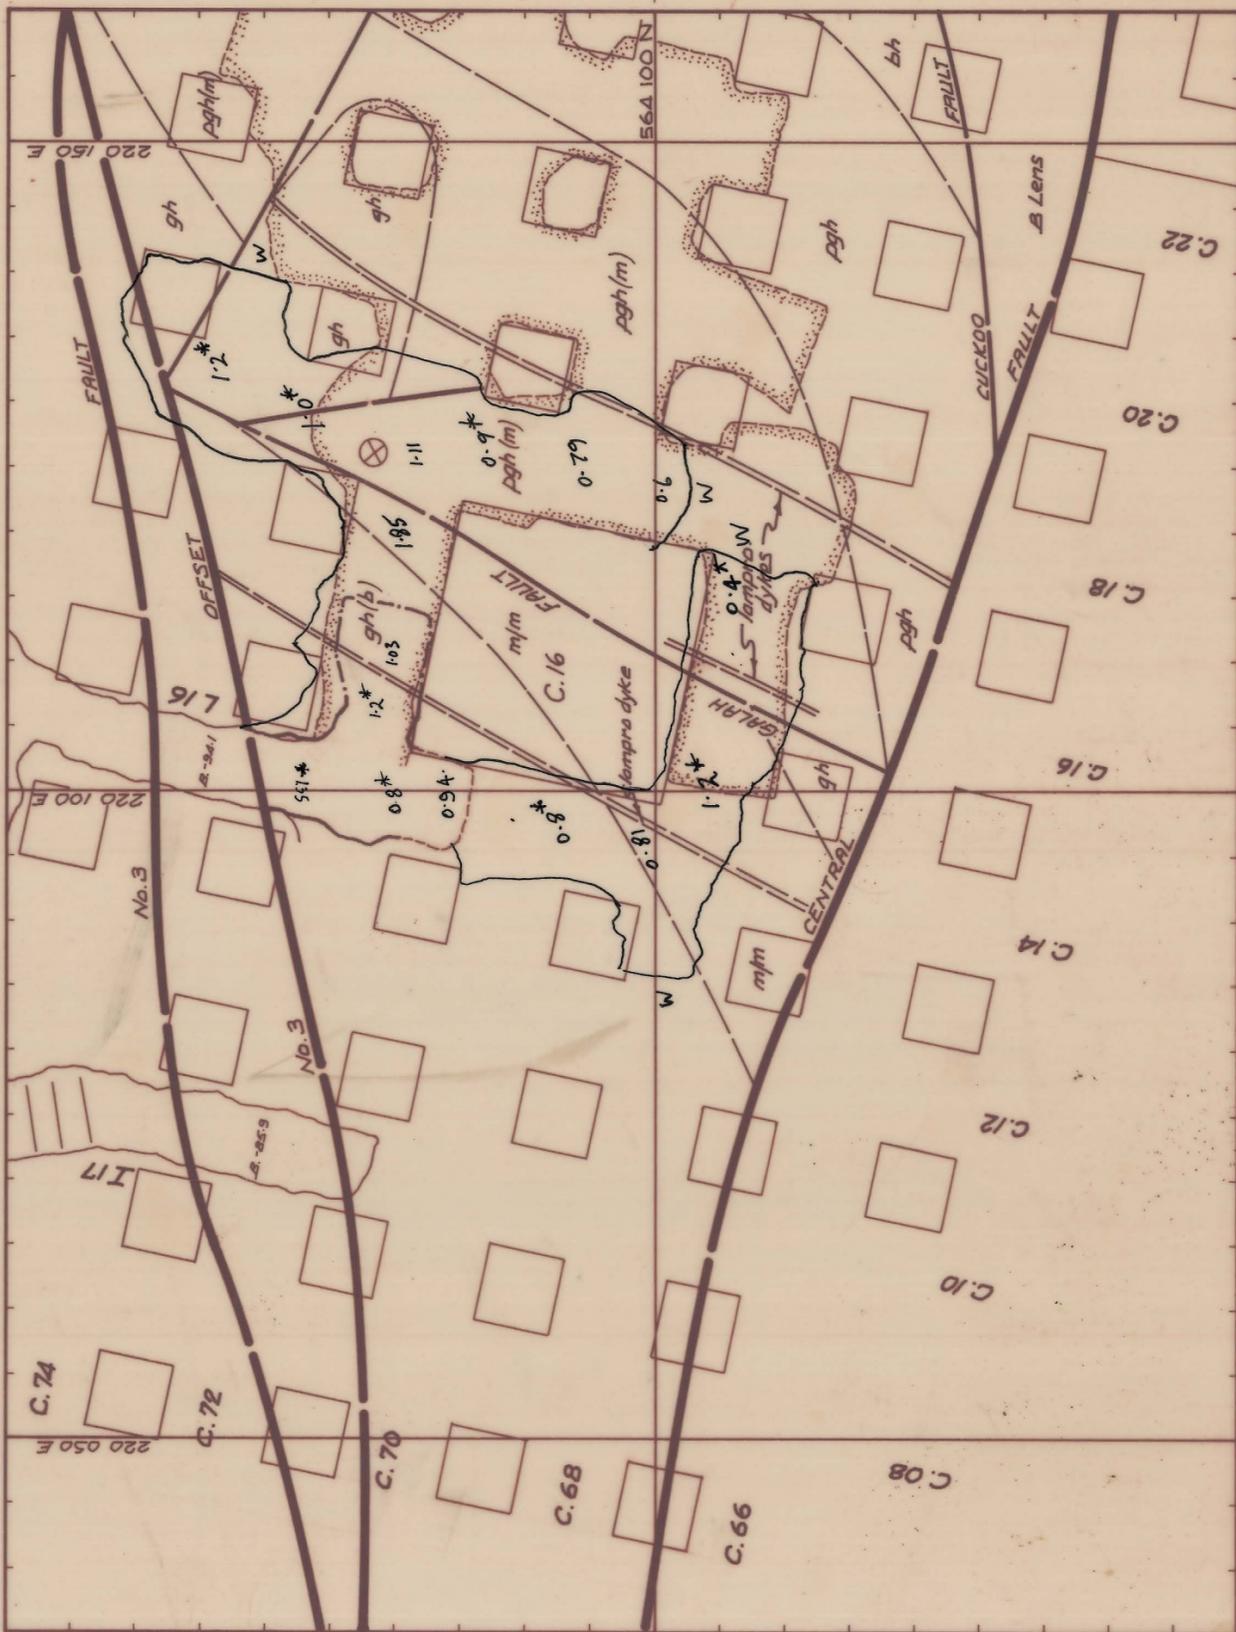

REF PLAN	GEOLOGY	H.G.	1:500	KIS KING ISLAND SCHEELITE GRASSY KING ISLAND
----- 13 th LIFT	SURVEY		SCALE	
	PLANNING		DOLPHIN MINE 14 th LIFT - CENTRAL AREA -100.5 m to -97mR.L. NB. GEOLOGY at -10mR.L.	
	ROCK.MEC.			
	GRADE CON.			
	DRAFTING			
	T.S.S.		DRAWING NUMBER	

5 cm

0374-1259