


0374 - 1264

GRAB SAMPLES
C-CENTRAL.
7TH LIFT.
-125 to -122 m R.L.

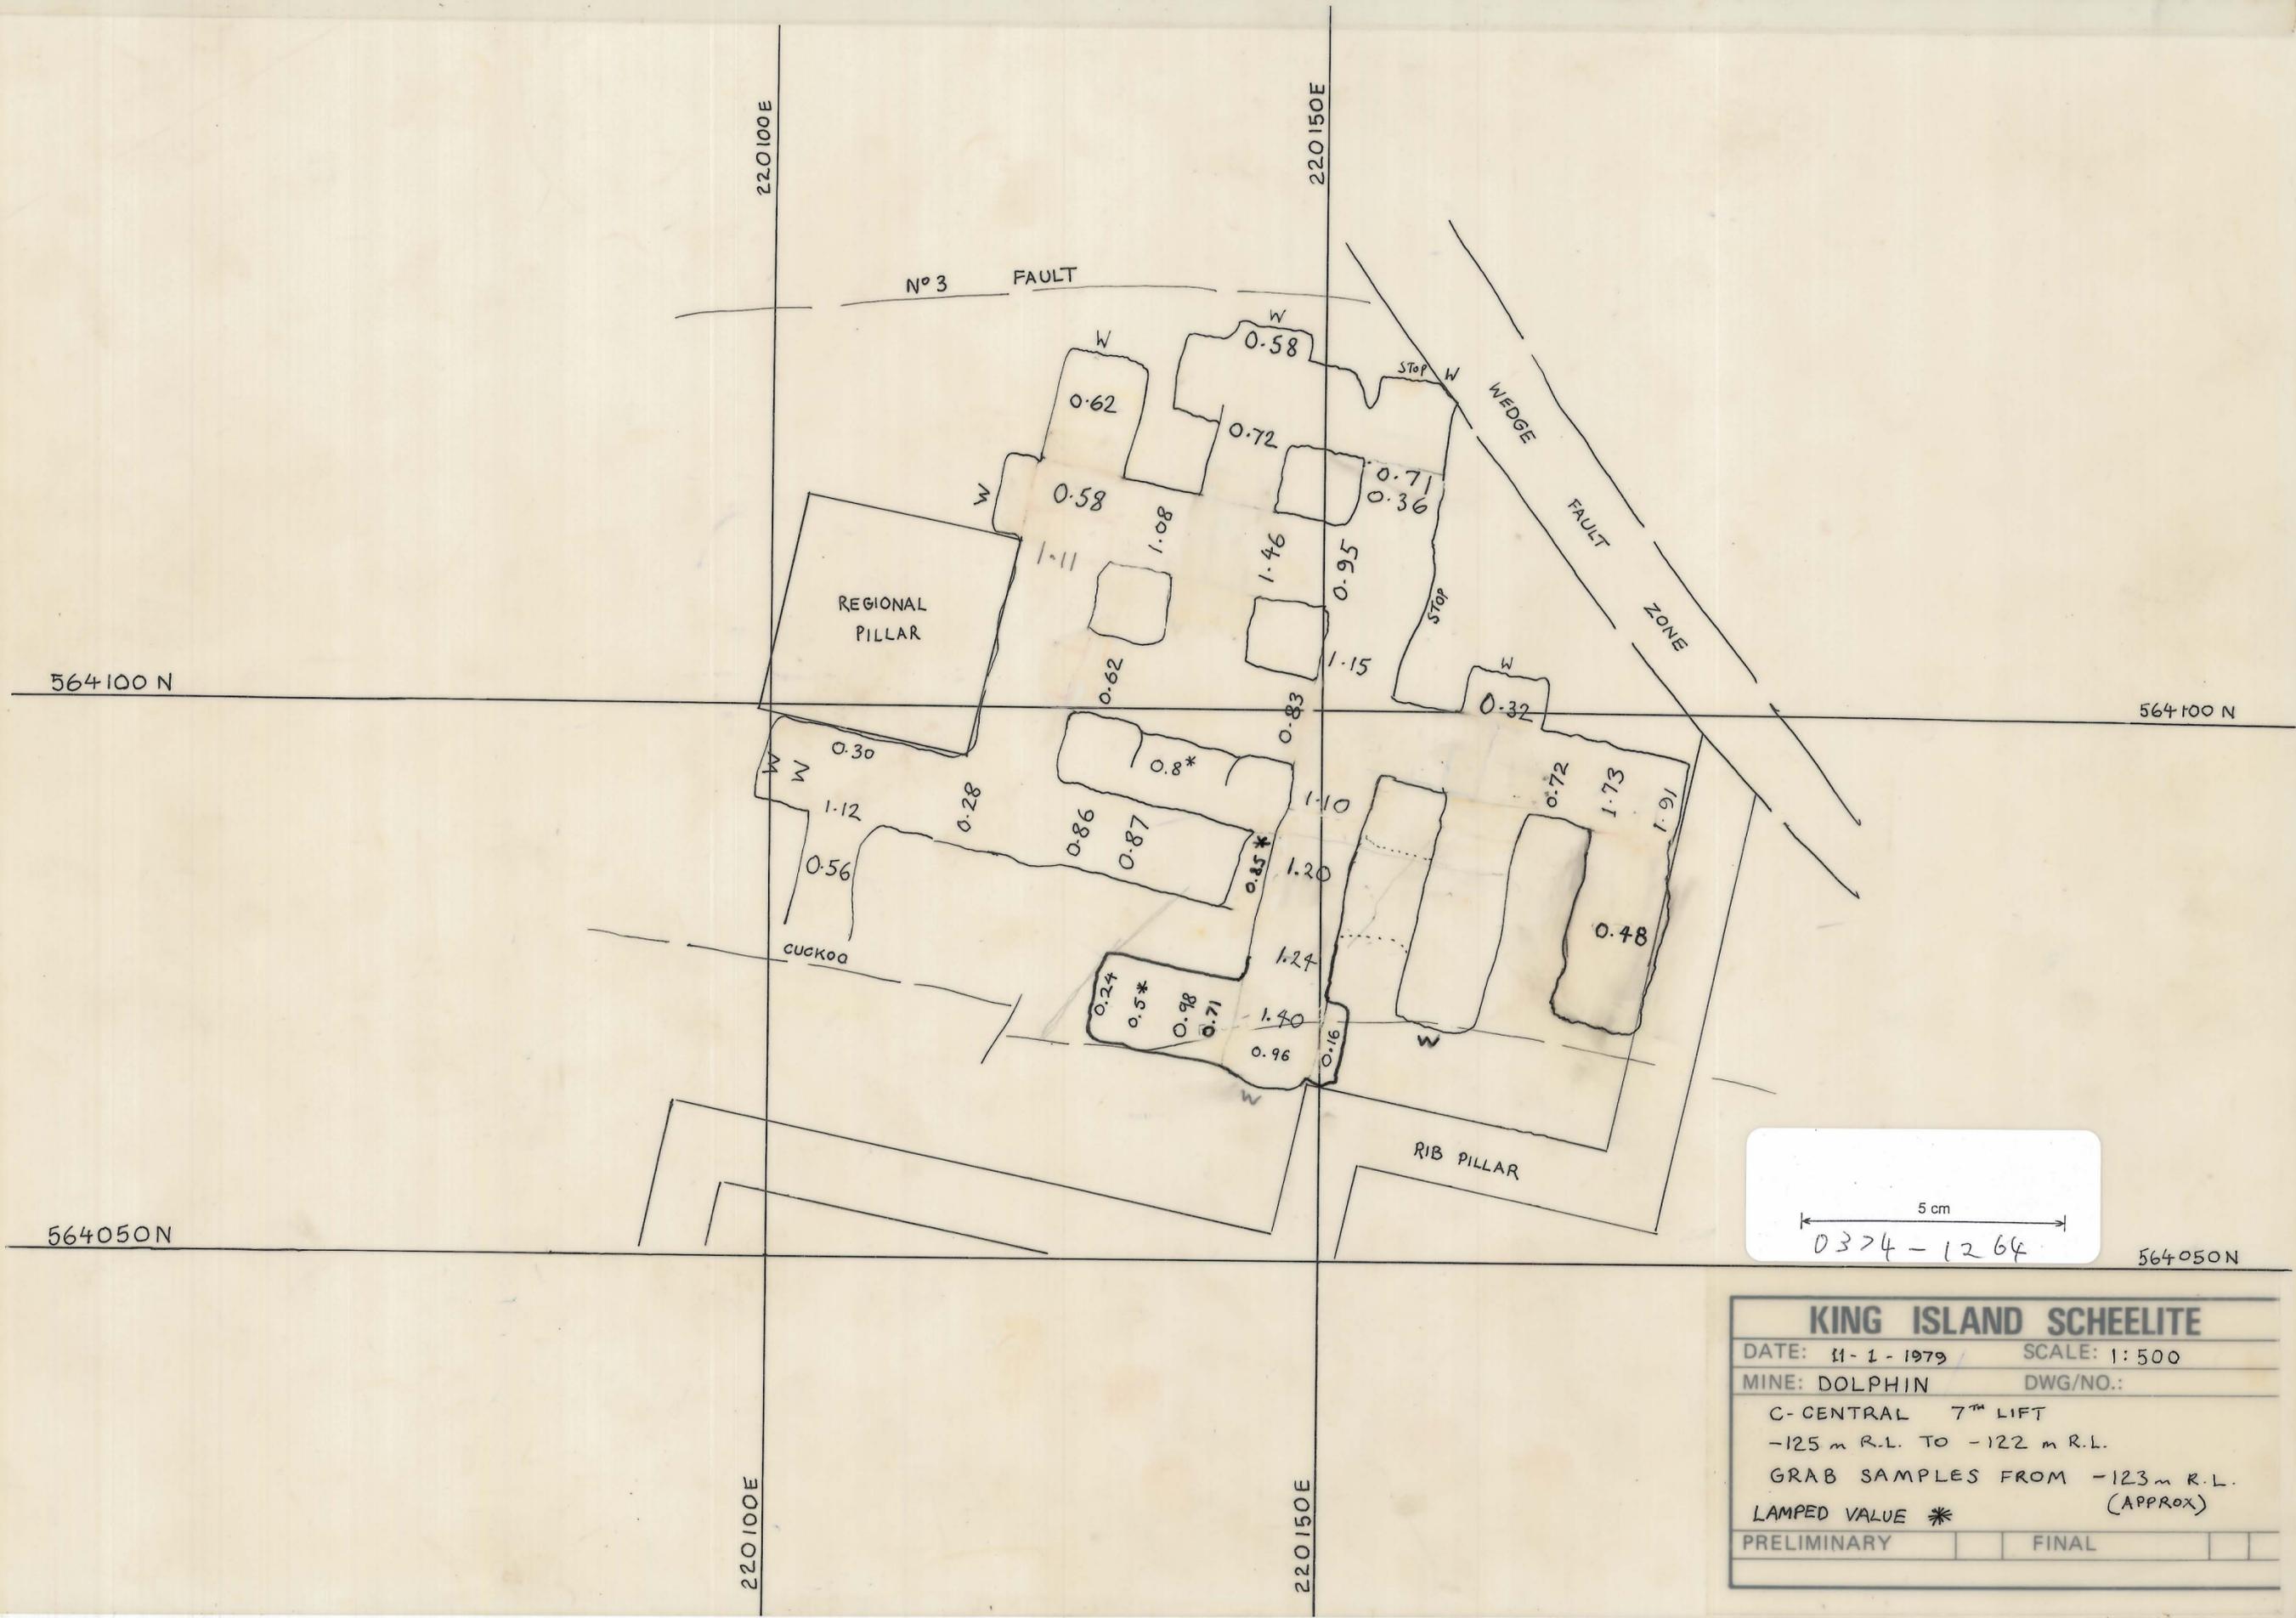

5 cm
0374 - 1264

KING ISLAND SCHEELITE	
DATE: 11-1-1979	SCALE: 1:500
MINE: DOLPHIN	DWG/NO.:
C-CENTRAL 7 TH LIFT	
-125 m R.L. TO -122 m R.L.	
GRAB SAMPLES FROM -123 m R.L. (APPROX)	
LAMPED VALUE *	
PRELIMINARY	FINAL