


0374-1265

C-CENTRAL 6TH LIFT
-128.5 to -125 RL
SAMPLES FROM -126m RL

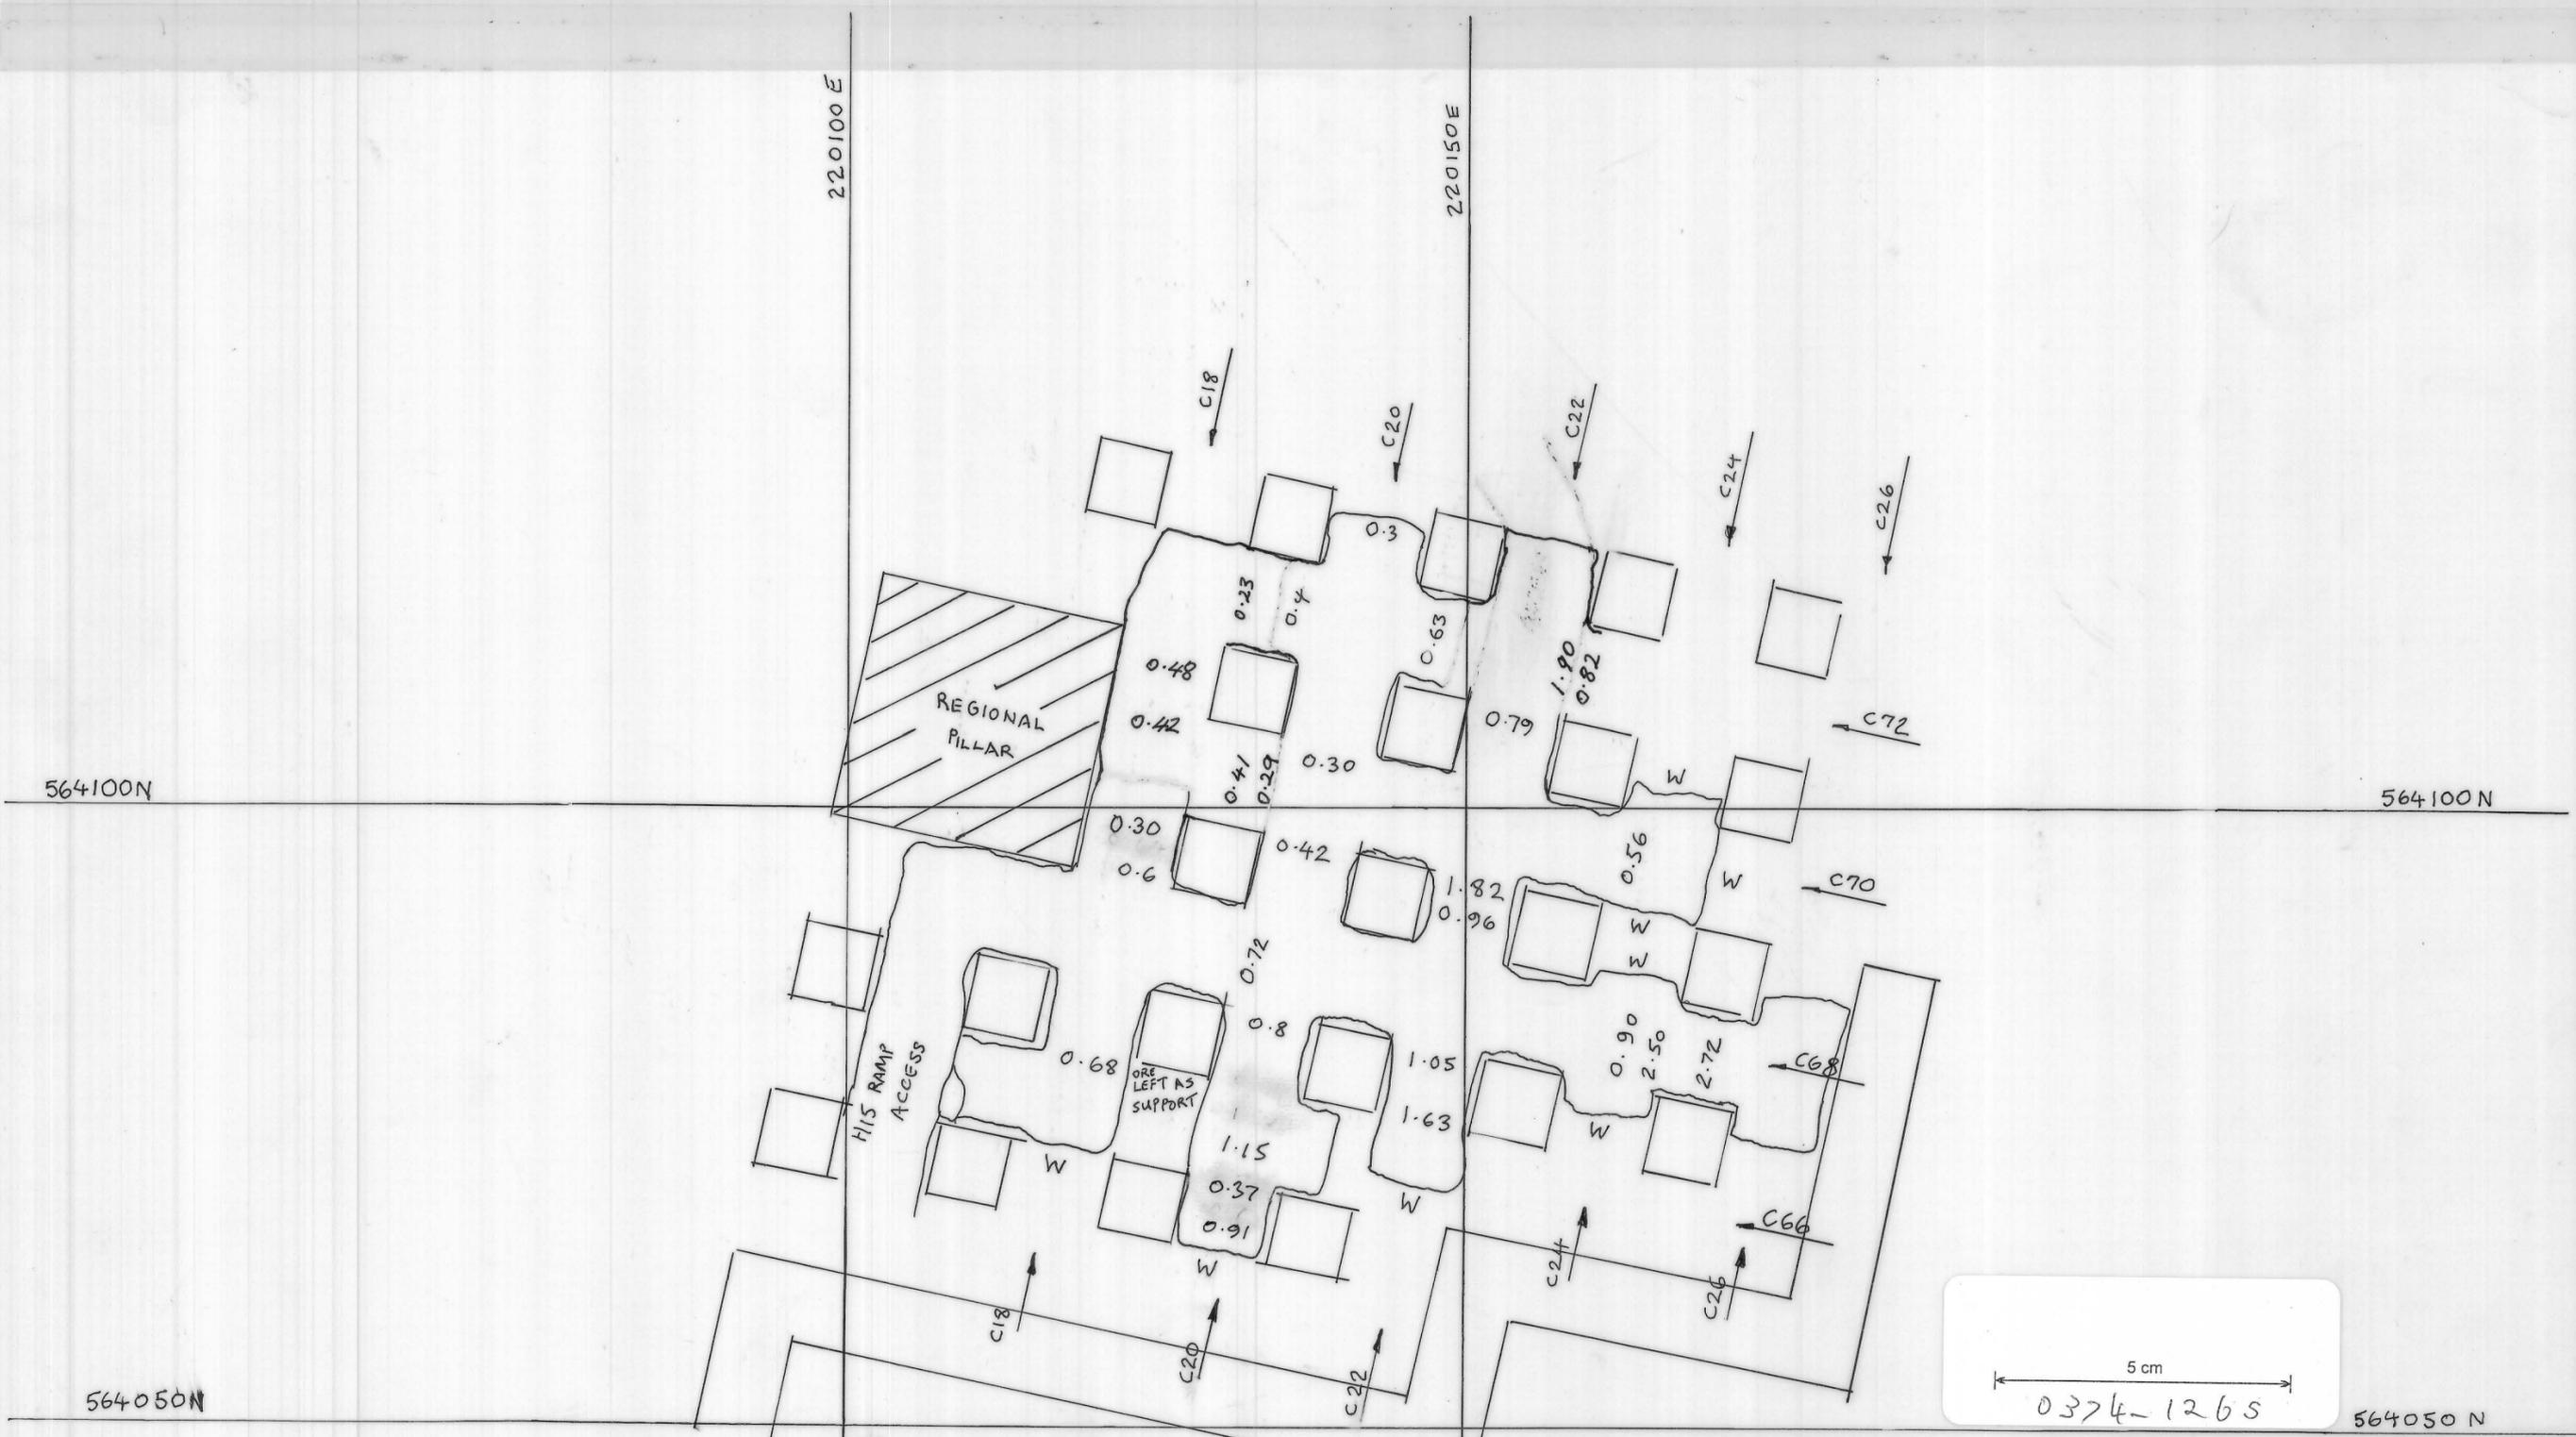

5 cm
0374-1265

KIS KING ISLAND SCHEELITE
A DIVISION OF WARMAN INTERNATIONAL

GRASSY KING ISLAND

PLAN NUMBER GRAB SAMPLES C-CENTRAL 6TH LIFT
-128.5 m R.L. to -125 m R.L.
SAMPLES FROM -126 R.L. (APPROX)