


0374-1270

220100 E

220150 E

220200 E

564100 N

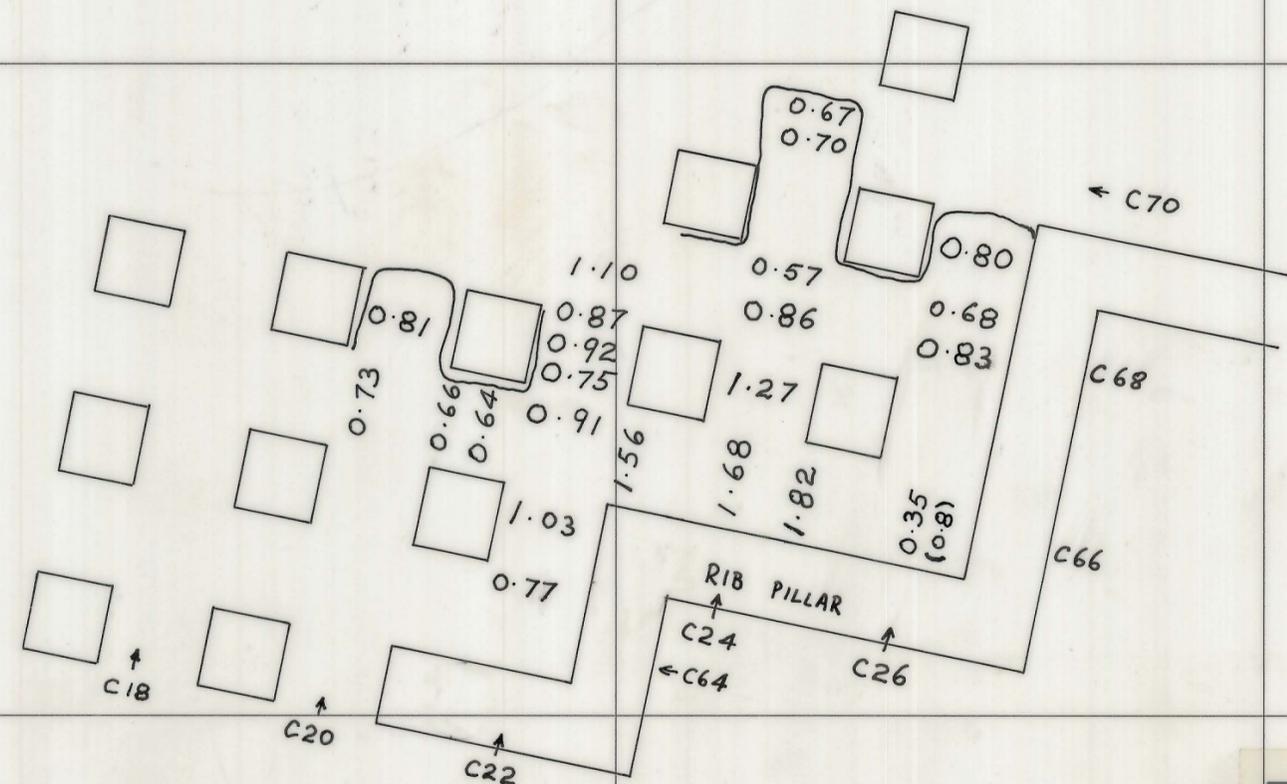

0374-1270

564050 N

KING ISLAND SCHEELITE			
DATE:	SCALE: 1:500		
MINE: DOLPHIN	DWG/NO.:		
C- CENTRAL SECOND LIFT			
-142 m to -139 m R.L.			
GRAB SAMPLE ASSAYS.			
PRELIMINARY	FINAL		

